

TEMPORARY AND DURABLE 100m YELLOW LINE

STA 9+100 TO 9+269 SOLID LT & DASHED RT
 STA 9+269 TO 9+318 DASHED
 STA 9+318 TO 9+559 DASHED LT & SOLID RT

TEMPORARY AND DURABLE 100m WHITE LINE

STA 7+850 TO 9+100 SOLID LT&RT

REHABILITATION OF D.I.'S, C.B.'S OR M.H.'S

STA 10+230 LT
 STA 10+250 LT
 STA 10+280 LT

YIELDING MARKER POST

STA 9+231LT&RT
 STA 9+342 LT&RT
 STA 9+368 LT
 STA 9+431LT

RELOCATED MAILBOX, SINGLE SUPPORT

STA 9+416 LT
 STA 9+865 LT

REMOVING SIGNS

I2

REMOVAL AND DISPOSAL OF GUARD RAIL

STA 9+573 TO 9+733 LT
 STA 9+924 TO 10+172 RT

MANUFACTURED TERMINAL SECTION


STA 9+130 TO 9+141RT (FLARED)
 STA 9+573 TO 9+584 LT (FLARED)
 STA 9+722 TO 9+733 LT (FLARED)
 STA 9+719 TO 9+730 RT (FLARED)
 STA 9+803 TO 9+814 RT (FLARED)
 STA 9+924 TO 9+935 RT (FLARED)
 STA 10+161 TO 10+172 RT (FLARED)

STEEL BEAM GUARD RAIL W/2.4m POSTS (MOD.)

STA 9+100 TO 9+130 RT
 STA 9+584 TO 9+722 LT
 STA 9+730 TO 9+803 RT
 STA 9+935 TO 10+161RT


REMOVAL AND DISPOSAL OF GUARD RAIL

STA 9+573 TO 9+733 LT
 STA 9+573 TO 9+584 LT
 STA 9+584 TO 9+722 LT
 STA 9+722 TO 9+733 LT

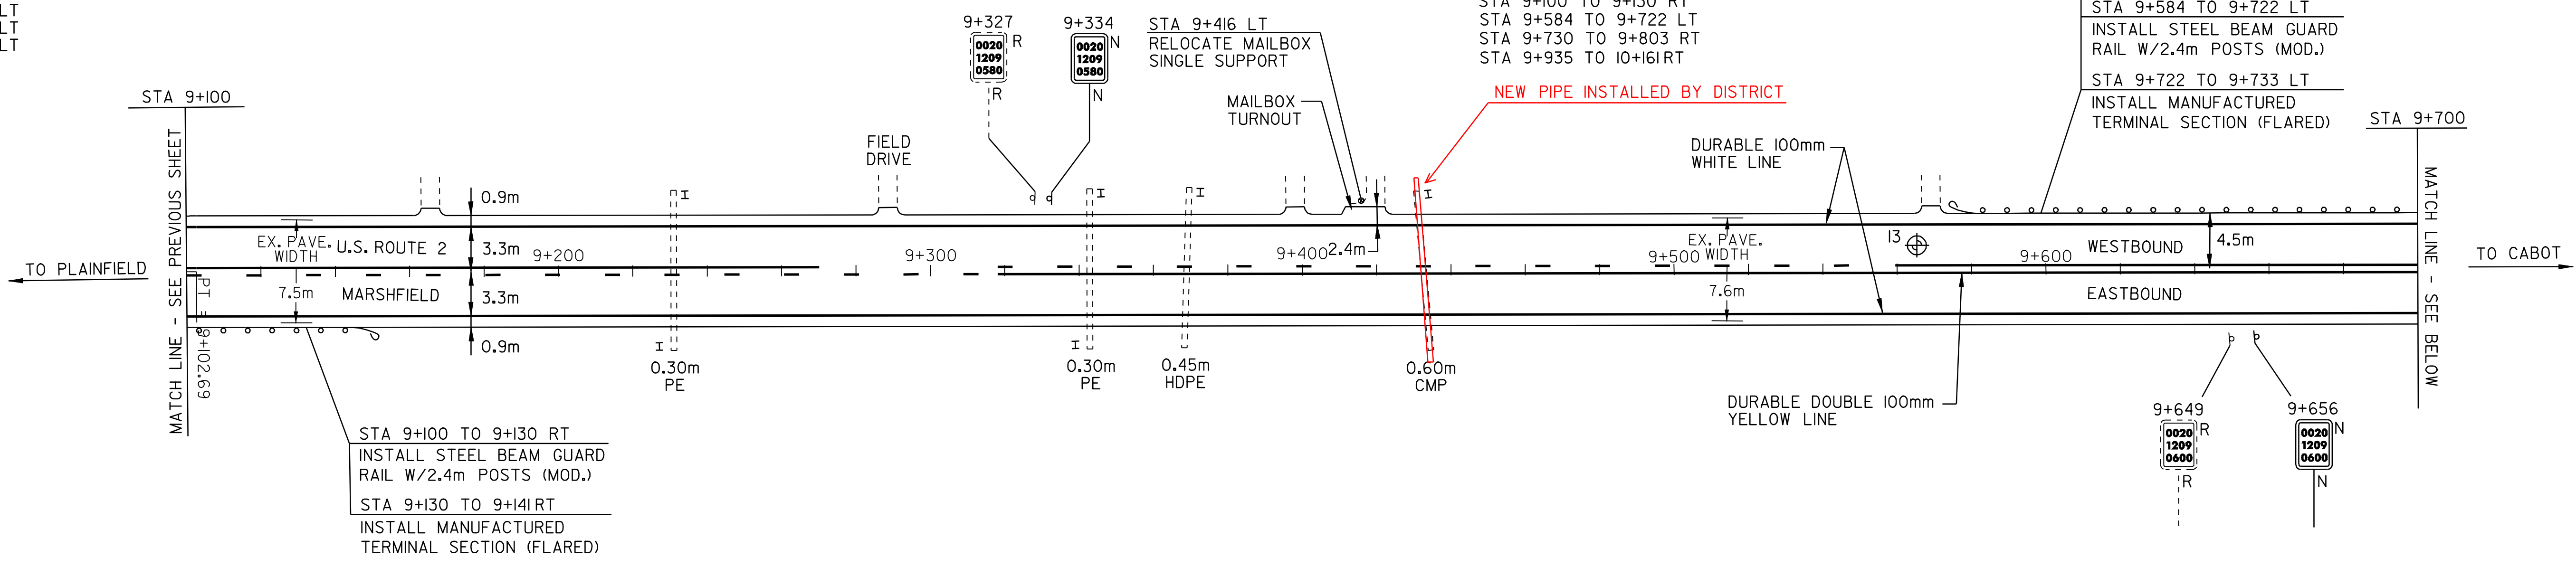

STA 9+100 TO 9+130 RT
 INSTALL STEEL BEAM GUARD RAIL W/2.4m POSTS (MOD.)
 STA 9+130 TO 9+141RT
 INSTALL MANUFACTURED TERMINAL SECTION (FLARED)

STA 9+924 TO 10+172 RT
 REMOVAL AND DISPOSAL OF GUARD RAIL
 STA 9+924 TO 9+935 RT
 INSTALL MANUFACTURED TERMINAL SECTION (FLARED)
 STA 9+935 TO 10+161RT
 INSTALL STEEL BEAM GUARD RAIL W/2.4m POSTS (MOD.)
 STA 10+161 TO 10+172 RT
 INSTALL MANUFACTURED TERMINAL SECTION (FLARED)

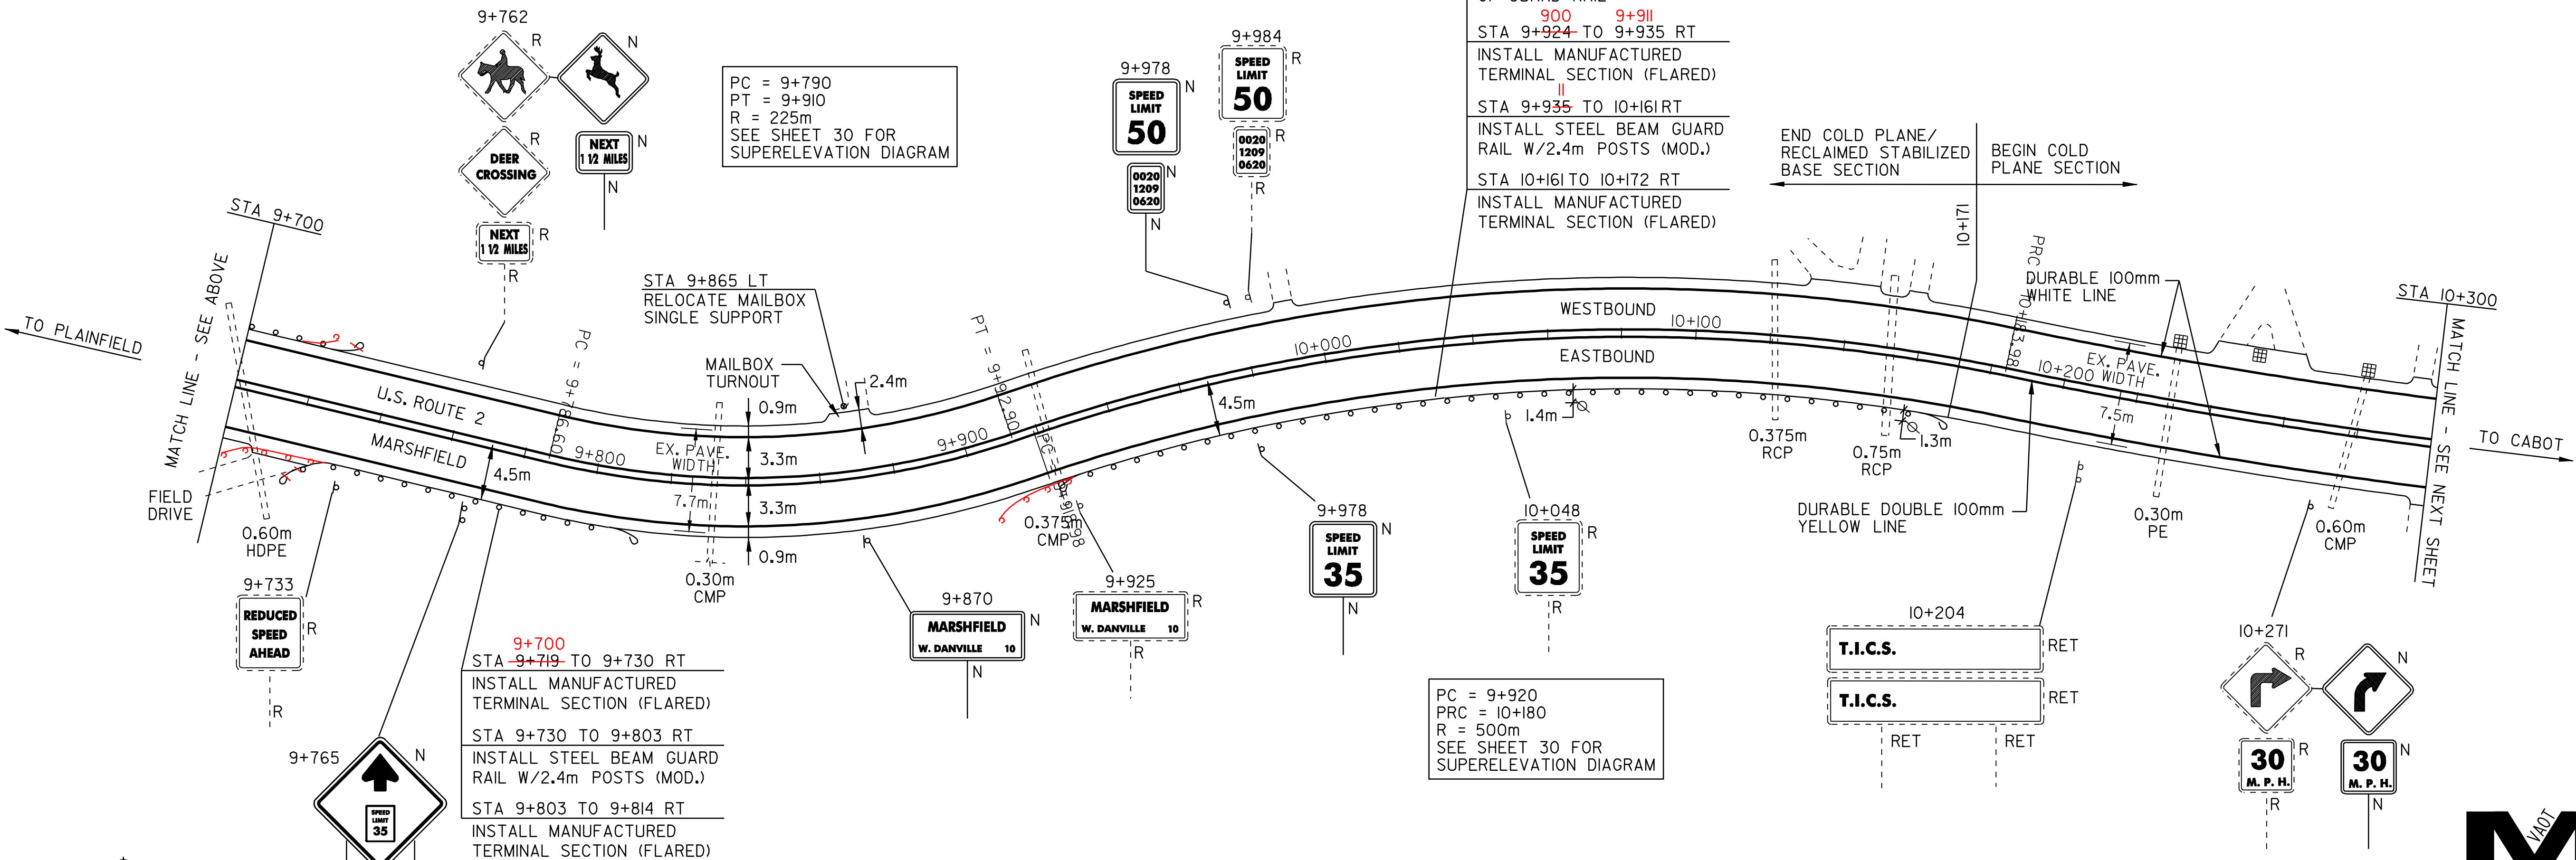

PC = 9+790
 PT = 9+910
 R = 225m
 SEE SHEET 30 FOR SUPERELEVATION DIAGRAM

PC = 9+920
 PRC = 10+180
 R = 500m
 SEE SHEET 30 FOR SUPERELEVATION DIAGRAM

9+700
 STA 9+719 TO 9+730 RT
 INSTALL MANUFACTURED TERMINAL SECTION (FLARED)
 STA 9+730 TO 9+803 RT
 INSTALL STEEL BEAM GUARD RAIL W/2.4m POSTS (MOD.)
 STA 9+803 TO 9+814 RT
 INSTALL MANUFACTURED TERMINAL SECTION (FLARED)

PAVEMENT CORES -			
#	TOTAL DEPTH (mm)	SOLID CORE	COMMENTS
13	280	NO	CORE BROKE UP

NOTE:
 - NO PCC UNDER ANY CORES
 - NO CORES OVER ASPHALTED (UNLESS NOTED)
 - NO SHOULDER CORES

PAVING PROJECT LAYOUT #8

DESIGNED BY	BCE/PJM	DATE	7-02
DRAWN BY	C.E.A., INC.	DATE	7-02
DESIGN FILE NO.	/pave/98b090/pb090.dgn		
PRF FILE	pb090p08.1	DATE PLOTTED	09-MAY-2008 10
PROJ. NAME	MARSHFIELD - CABOT		
PROJ. NO.	NH 2104(1)S		
SHEET	18	OF	60 SHEETS