

**TEMPORARY AND DURABLE 100m YELLOW LINE**

STA 10+700 TO 11+000 SOLID LT&RT  
 STA 10+865 DOUBLE SOLID LT  
 STA 10+895 DOUBLE SOLID LT  
 (WITH CENTERLINE BREAKS FOR TOWN HIGHWAYS)

**TEMPORARY AND DURABLE 100m WHITE LINE**

STA 10+700 TO 11+000 SOLID LT&RT  
 STA 10+866 TO 10+896 LT (GORE AROUND ISLAND)(SOLID)  
 (WITH EDGE LINE BREAKS FOR TOWN HIGHWAYS)

**TEMPORARY AND DURABLE 600m STOP BAR**

STA 10+865 LT VT ROUTE 215  
 STA 10+895 LT VT ROUTE 215

**TEMPORARY AND DURABLE LETTER OR SYMBOL**

STA 10+865 LT "STOP"  
 STA 10+895 LT 2 - "STOP"

**REHABILITATION OF D.I.'S, C.B.'S OR M.H.'S**

STA 10+709 LT  
 STA 10+740 LT  
 STA 10+846 RT  
 STA 10+855 LT  
 STA 10+863 RT  
 STA 10+879 LT

**BITUMINOUS CONCRETE GUTTER**


STA 10+775 TO 10+847 RT  
 STA 10+863 TO 10+899 RT  
 (SEE DETAIL, SHEET 4)

**CHANGE ELEVATION OF SEWER MANHOLE**

STA 10+860 LT

**REMOVING SIGNS**

44

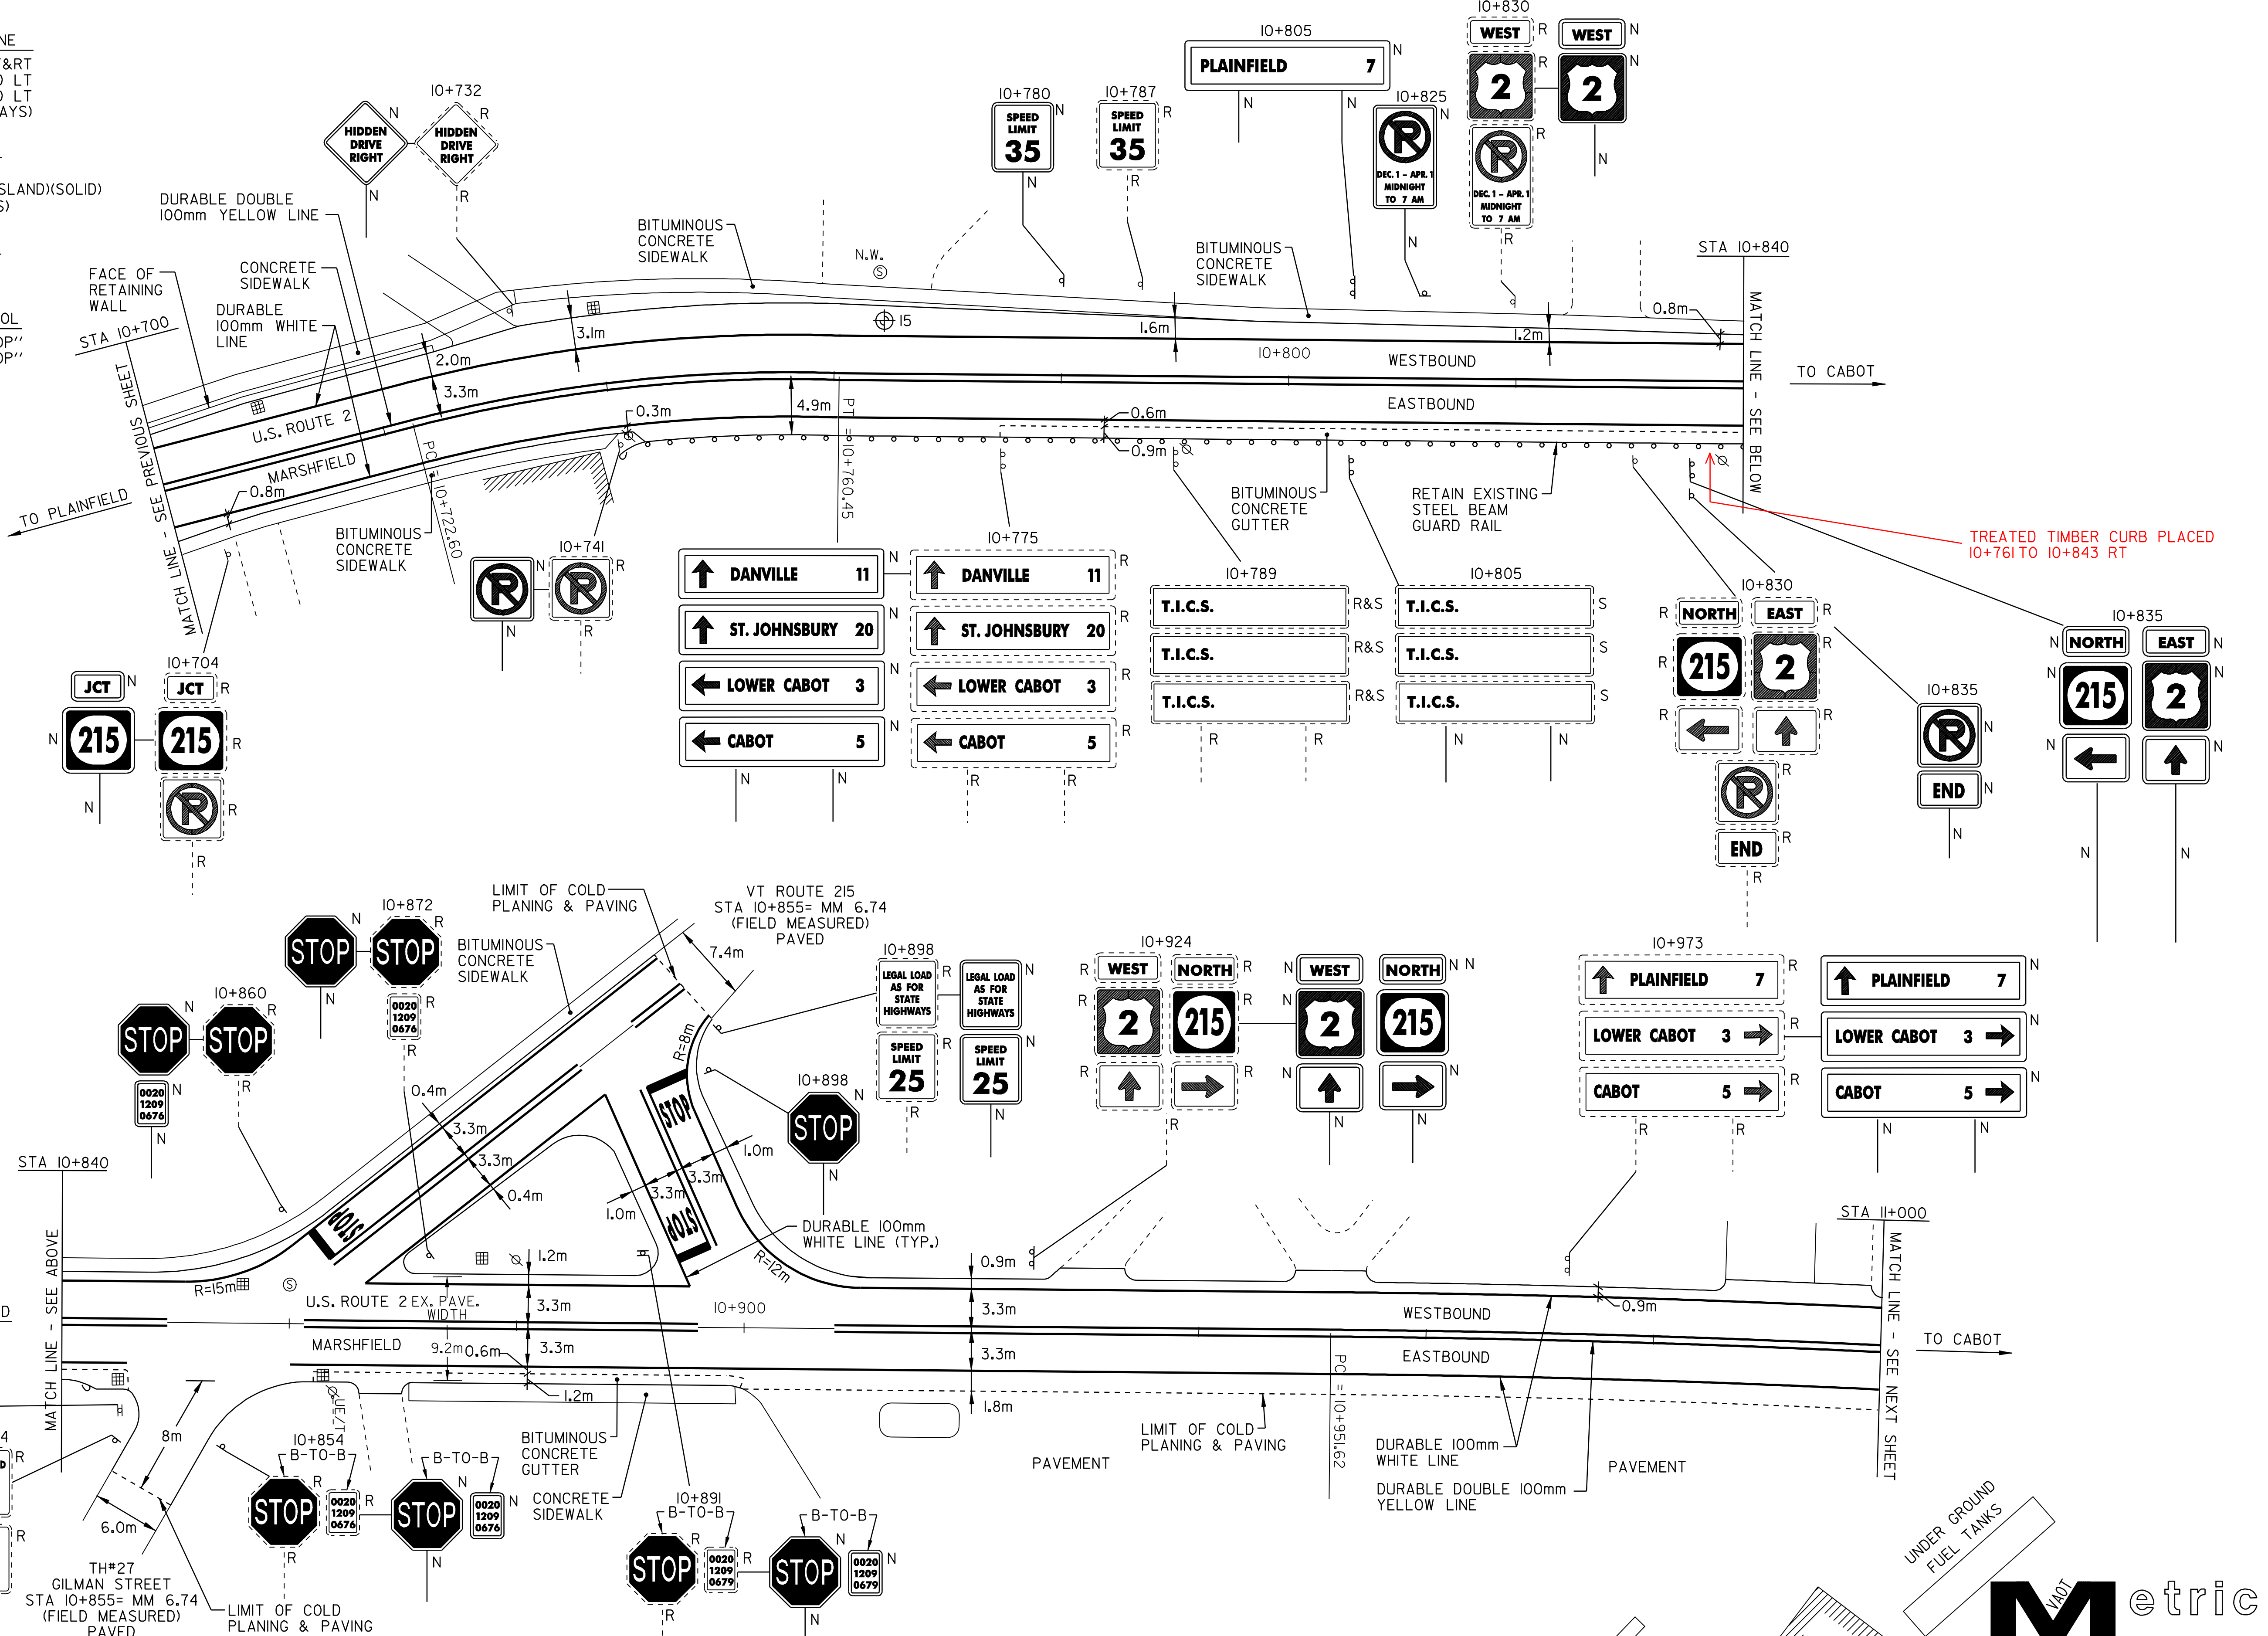

**PAVEMENT CORES -**

* TOTAL DEPTH (mm)	SOLID CORE	COMMENTS
15	140	YES DRAINABLE BASE, CORE AT SIDEWALK

**NOTE:**  
 - NO PCC UNDER ANY CORES  
 - NO CORES OVER ASPHALTED (UNLESS NOTED)  
 - NO SHOULDER CORES



**PAVING PROJECT LAYOUT #10**

DESIGNED BY BCE/PJM DATE 7-02  
 DRAWN BY C.E.A., INC. DATE 7-02  
 DESIGN FILE NO. /pave/98b090/pb090.dgn  
 PRF FILE pb090p10.i DATE PLOTTED 09-MAY-2008 10  
 PROJ. NAME **MARSHFIELD - CABOT**  
 PROJ. NO. **NH 2104(1)S**  
 SHEET **20** OF **60** SHEETS