



SEE HAND DRAWN REVISED BANKING DIAGRAMS

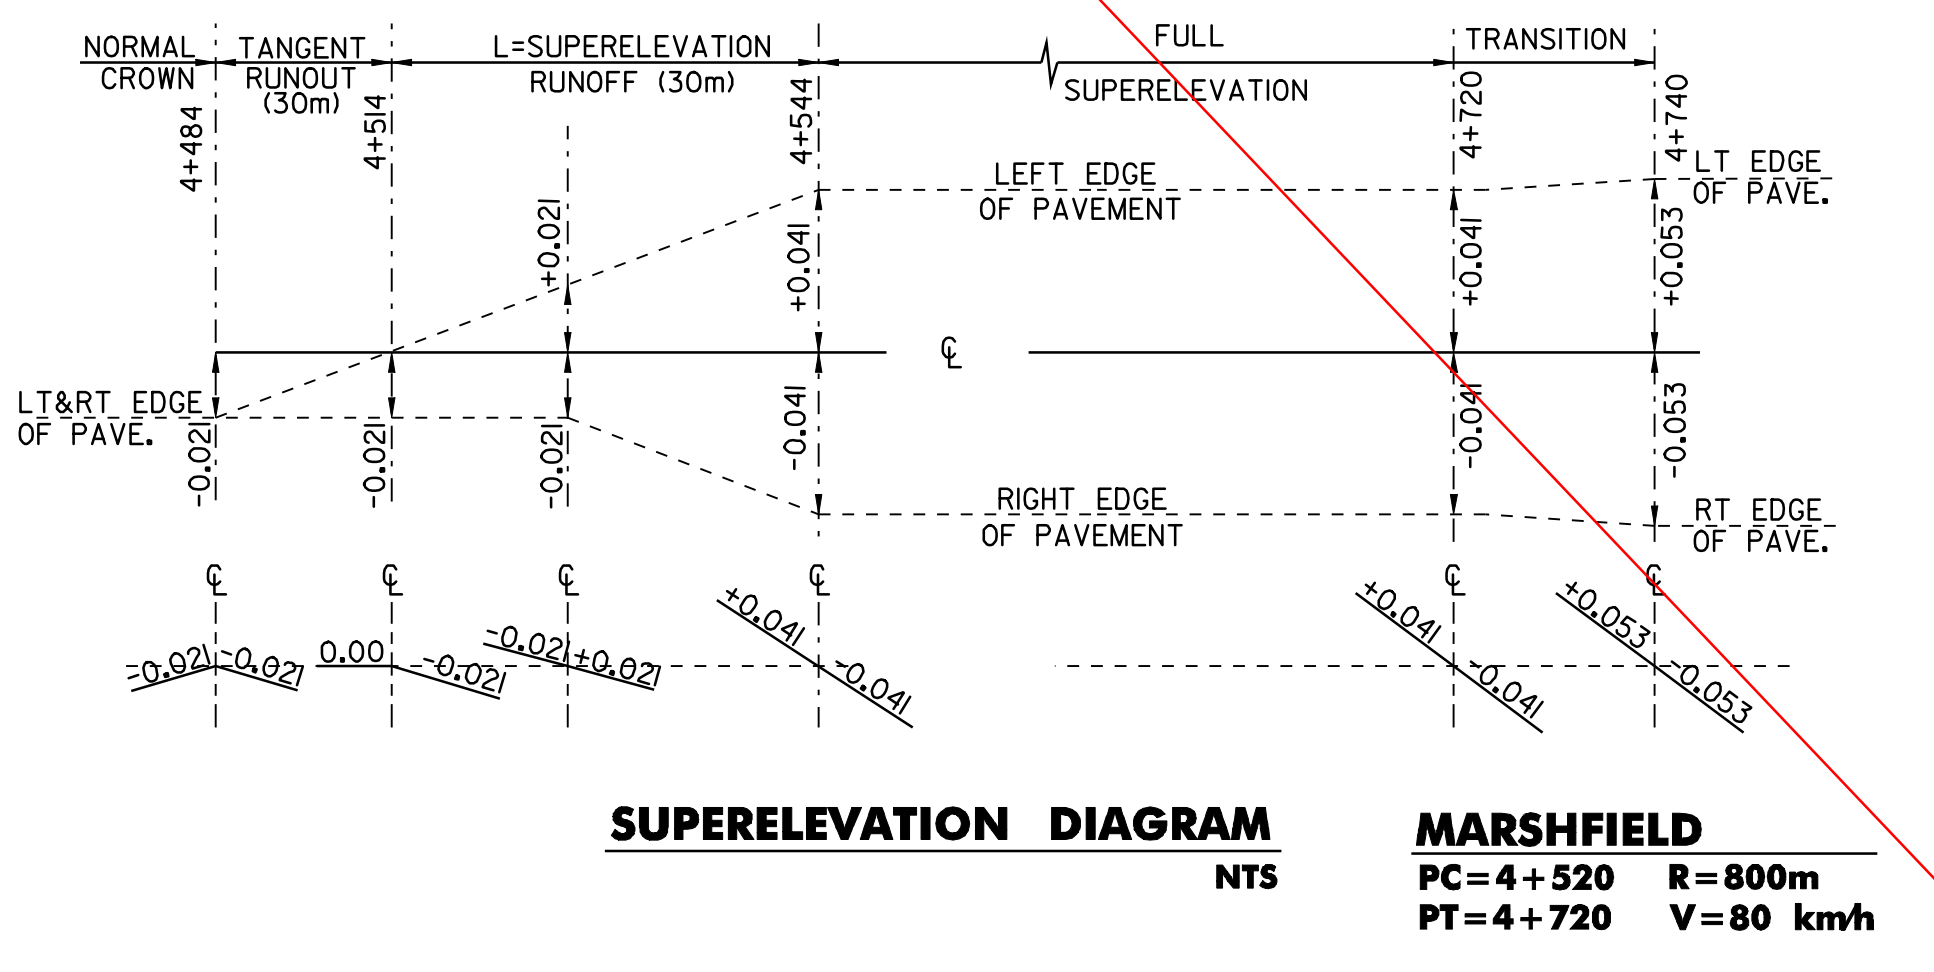

NOTE:
THE CONTRACTOR IS RESPONSIBLE FOR THE ENGINEERING WORK
REQUIRED TO LAYOUT AND MAINTAIN THE CROSS SLOPES IN THE
REGRADEING OF THE RECLAIMED AREAS.

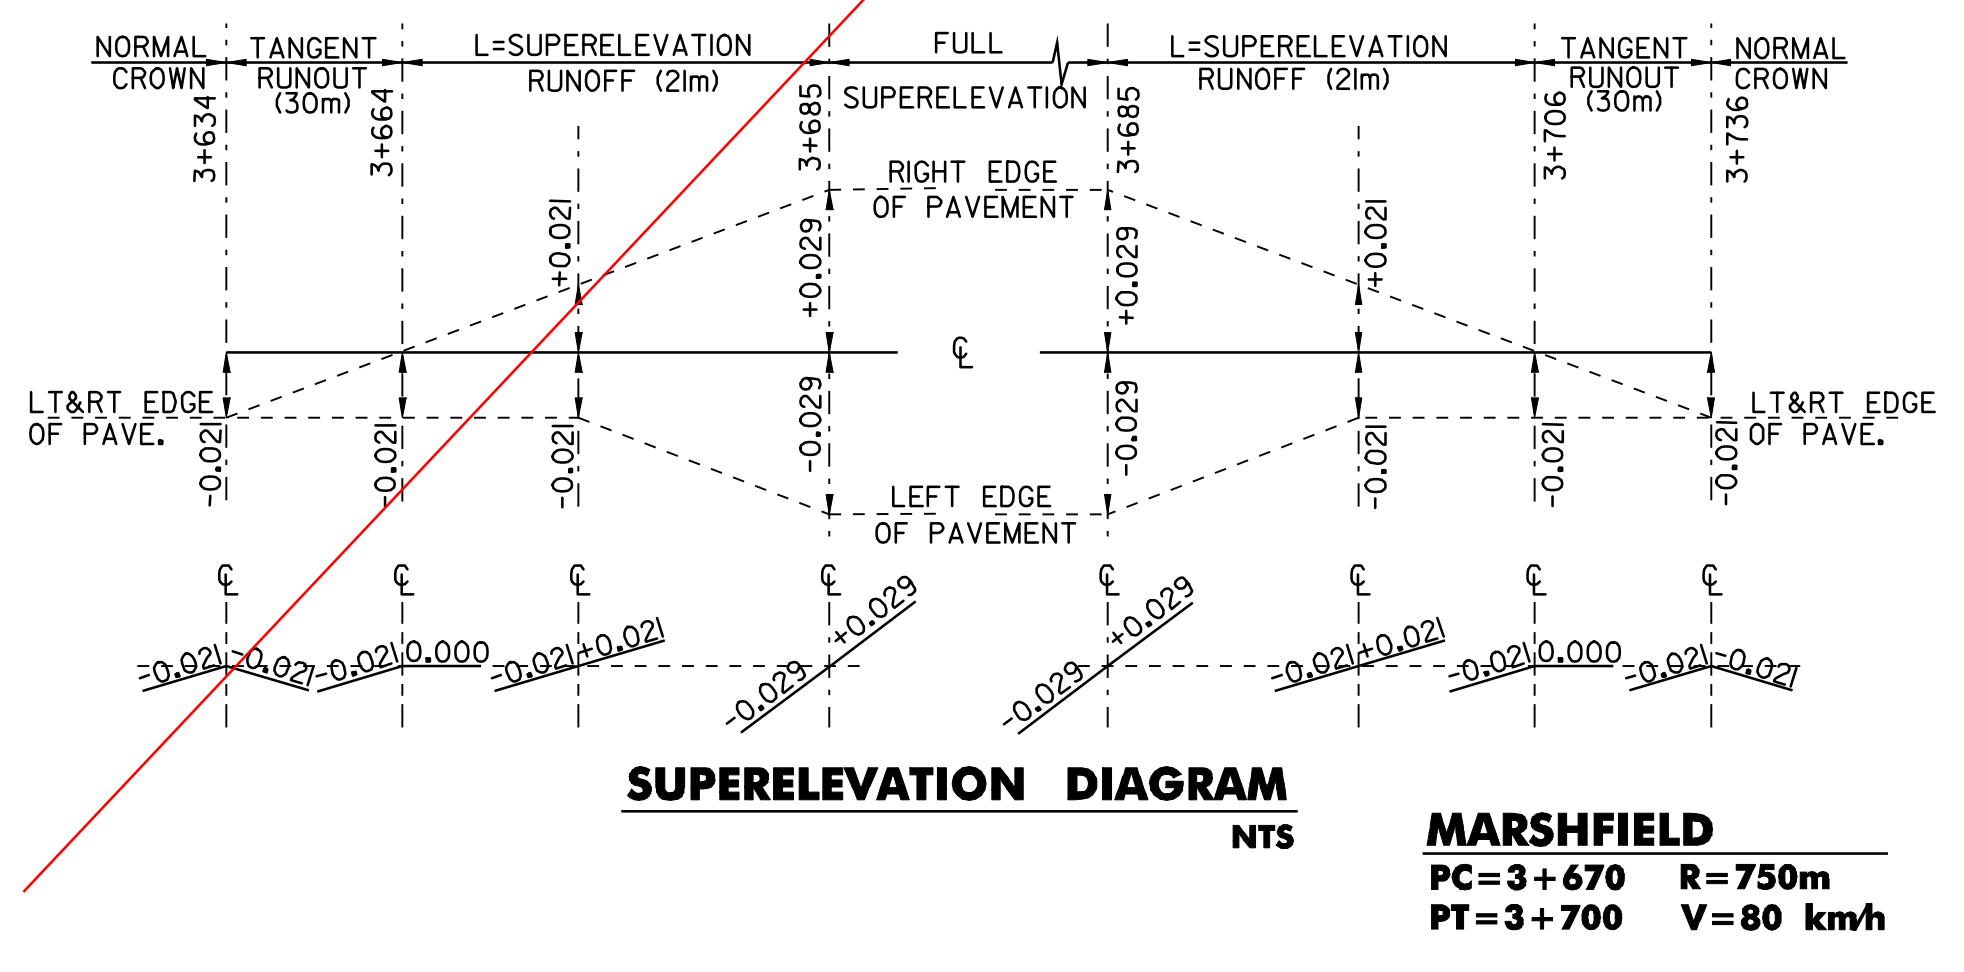

**SUPERELEVATION
BANKING DIAGRAM
SHEET #2**

DESIGNED BY	BCE/PJM	DATE	7-02
DRAWN BY	C.E.A., INC.	DATE	7-02
DESIGN FILE NO.	/pave/98b090/pb090.dgn		
PRF FILE	pb090bd2.1	DATE PLOTTED	09-MAY-2008
PROJ. NAME	MARSHFIELD - CABOT		
PROJ. NO.	NH 2104(1)S		
SHEET	28	OF	60 SHEETS