





MARSHFIELD - BRIDGE #79
STA 8+767.6 = MM 5.448

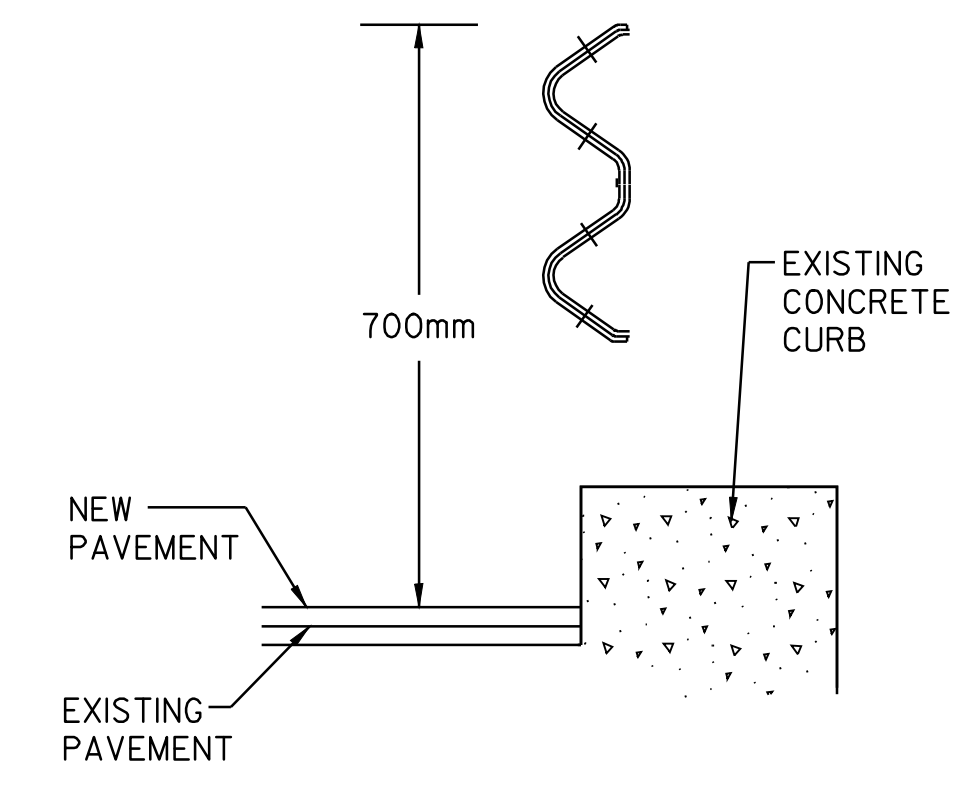



SECTION @ EXISTING POST

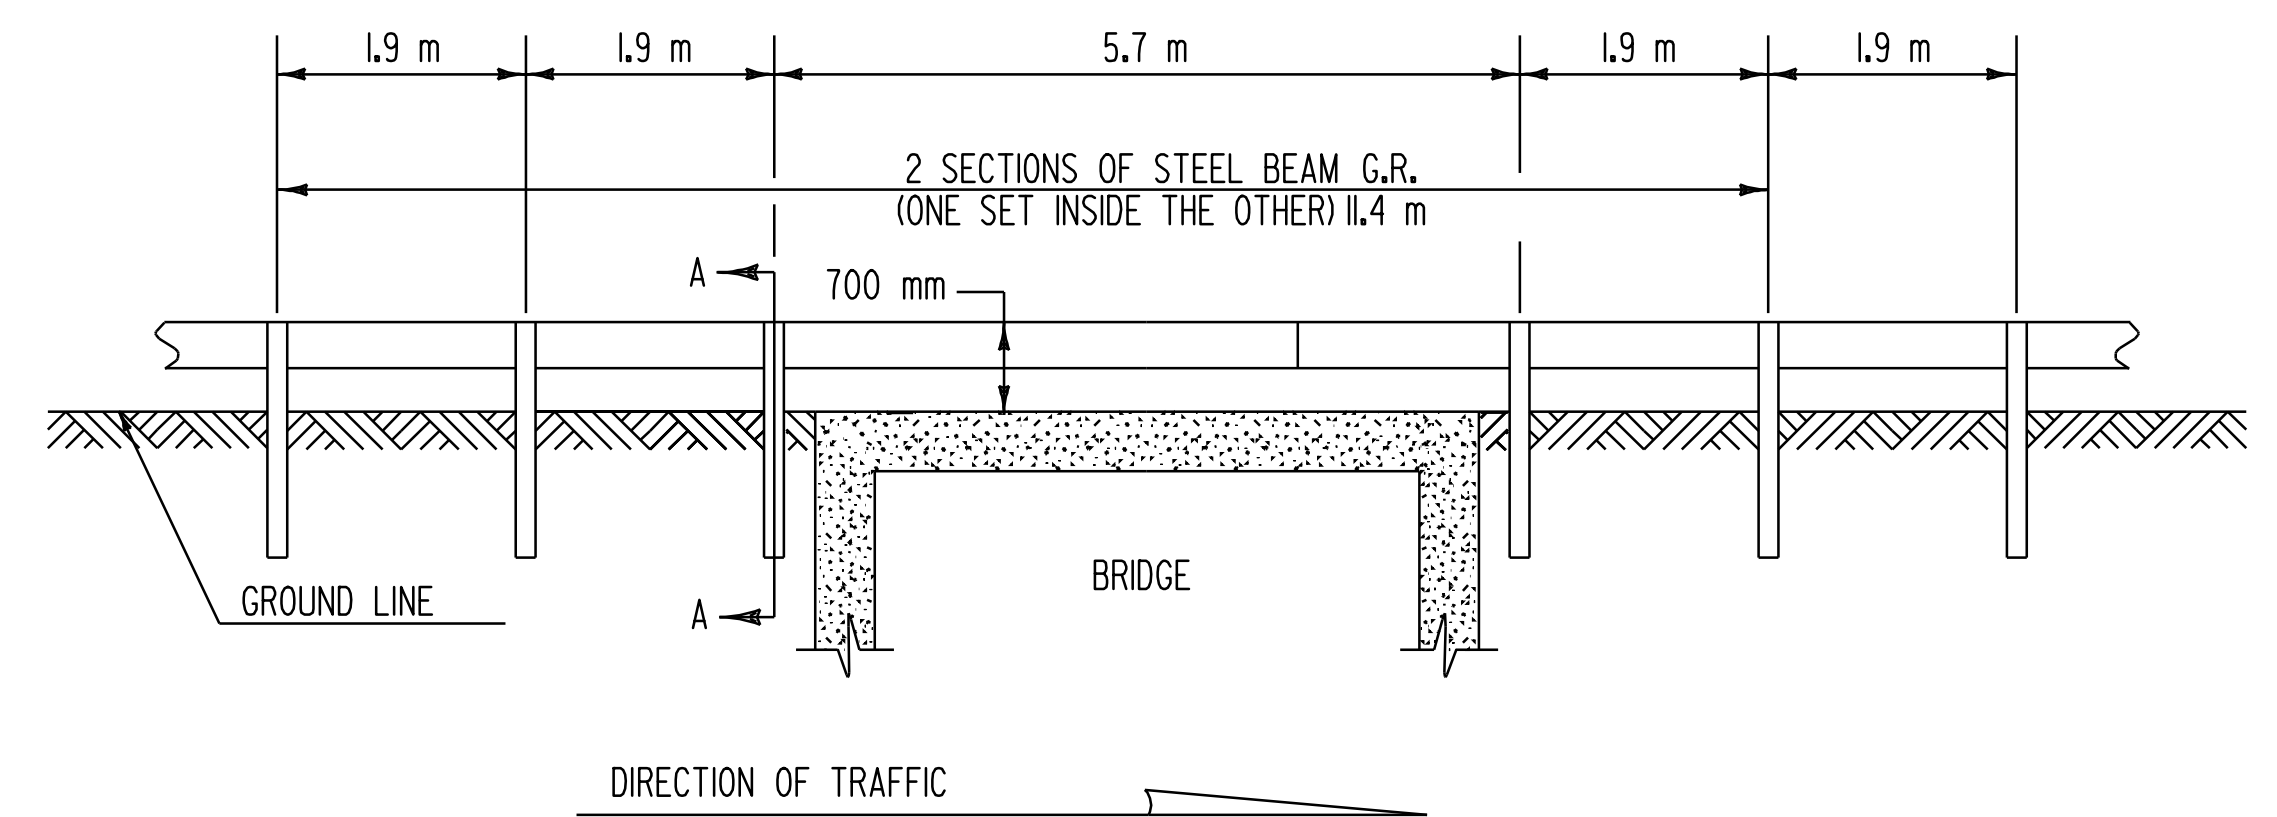

DETAIL OF STEEL BEAM GUARD RAIL AT LARGE CULVERTS/BRIDGES

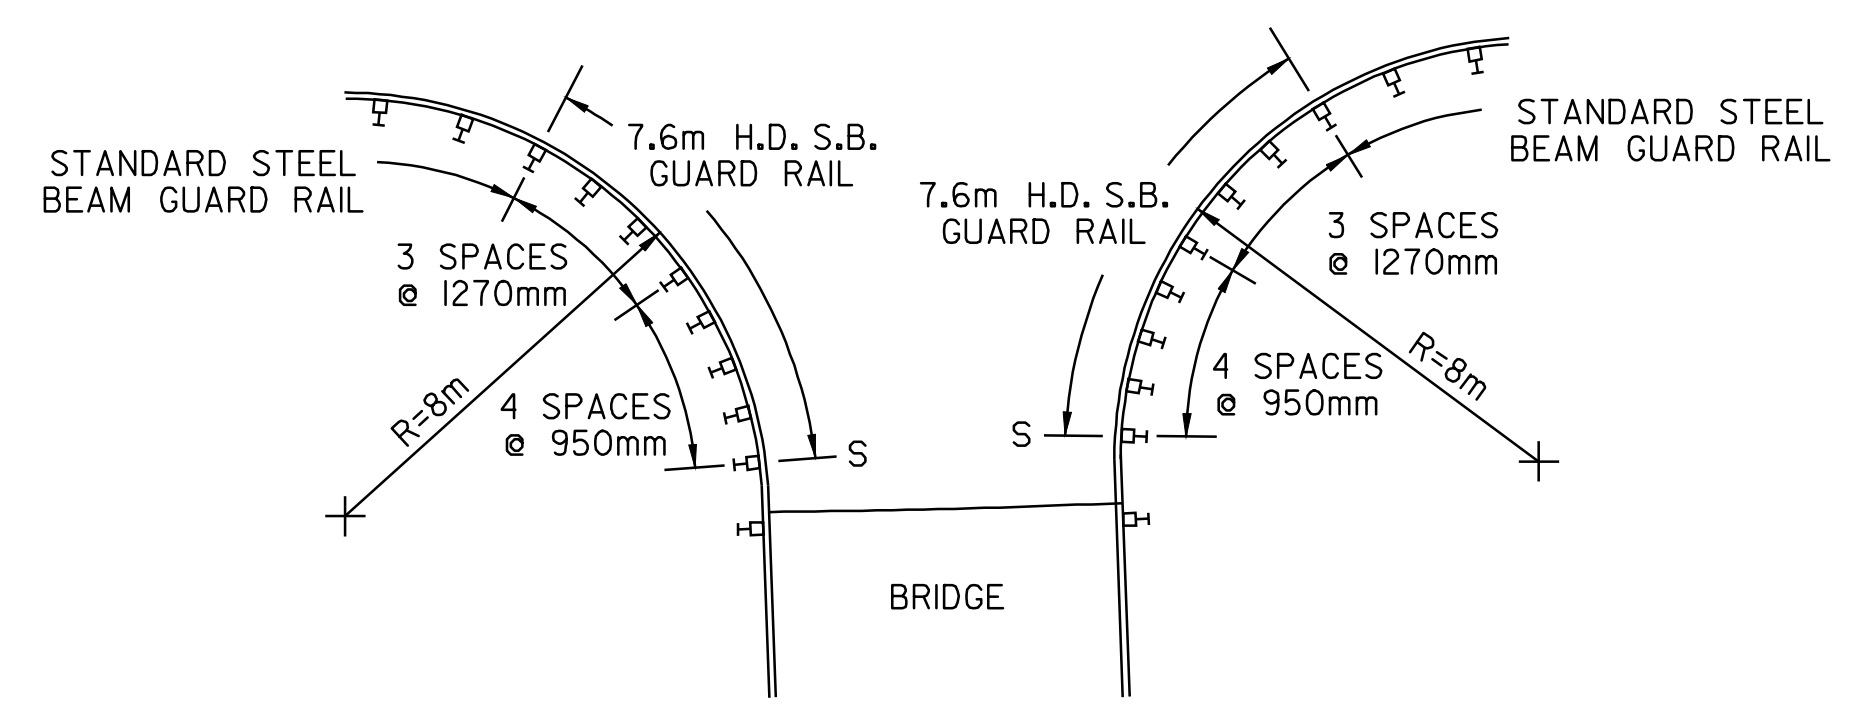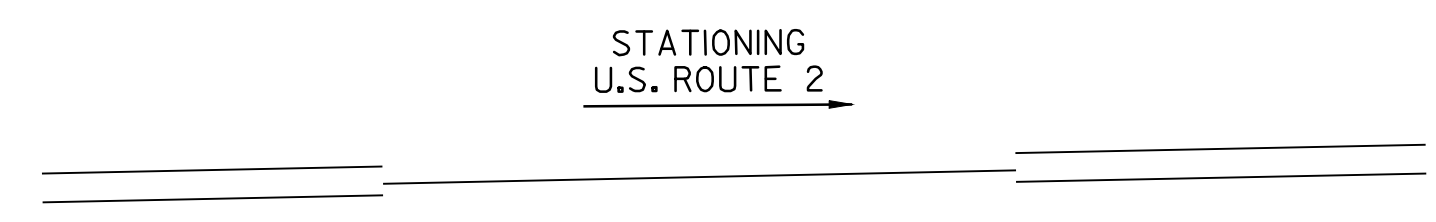

MARSHFIELD - TH #35 BRIDGE
STA 9+049 = MM 5.61

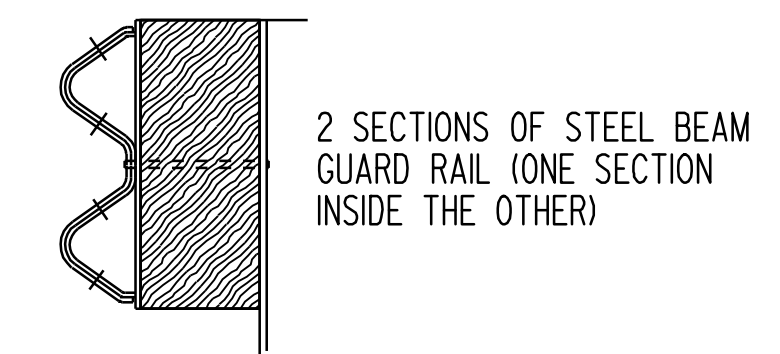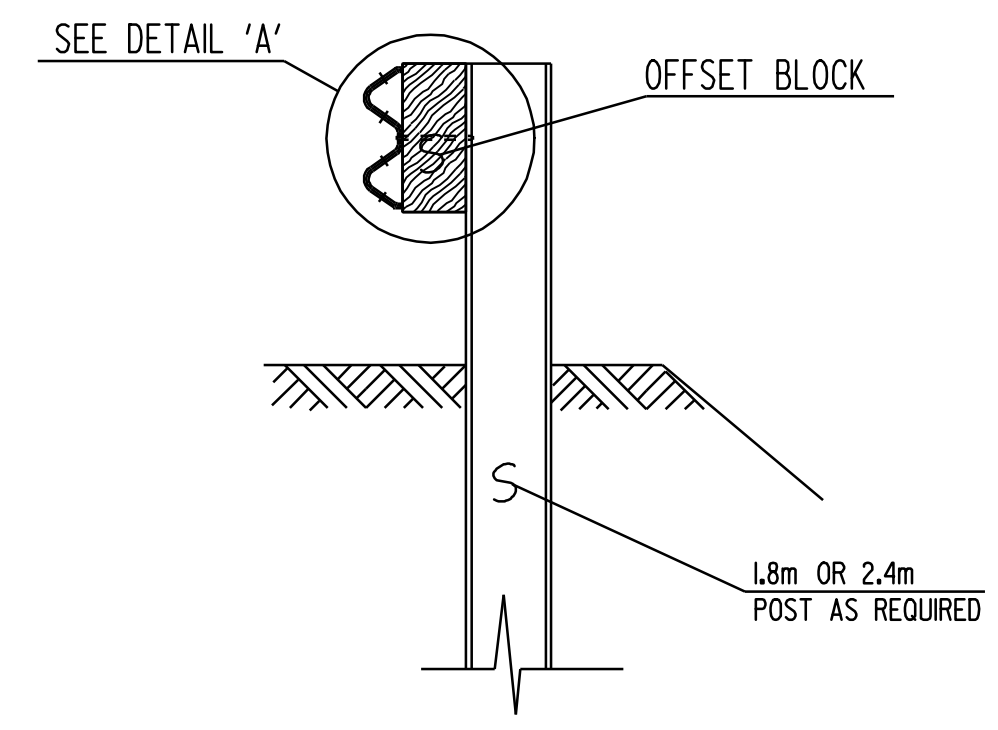

DETAIL A

NOTES

1. SEE STANDARD G-1M & G-1DM FOR STEEL BEAM GUARD RAIL DETAILS.
2. THIS WORK SHALL BE PAID UNDER ITEM 621.20, STEEL BEAM GUARD RAIL, OR 621.21 HEAVY DUTY STEEL BEAM GUARD RAIL AT A PAY FACTOR OF 1.0.



BRIDGE DETAIL SHEET #4	DESIGNED BY <u>BCE/PJM</u> DATE <u>7-02</u>
	DRAWN BY <u>C.E.A., INC.</u> DATE <u>7-02</u>
	DESIGN FILE NO. <u>/pave/98b090/pb090.dgn</u>
	PRF FILE <u>pb090b04.i</u> DATE <u>09-MAY-2008</u>
	PROJ. NAME: MARSHFIELD - CABOT
PROJ. NO.: NH 2104(1)S	
SHEET 55 OF 60 SHEETS	