


- RECORD PLANS -

NOTE
The transition from PC 01630 to PT 01670 has been eliminated. This is now a mill and fill section.



NOTE:
THE CONTRACTOR IS RESPONSIBLE FOR THE ENGINEERING WORK
REQUIRED TO LAYOUT AND MAINTAIN THE CROSS SLOPES IN THE
REGRADING OF THE RECLAIMED AREAS.

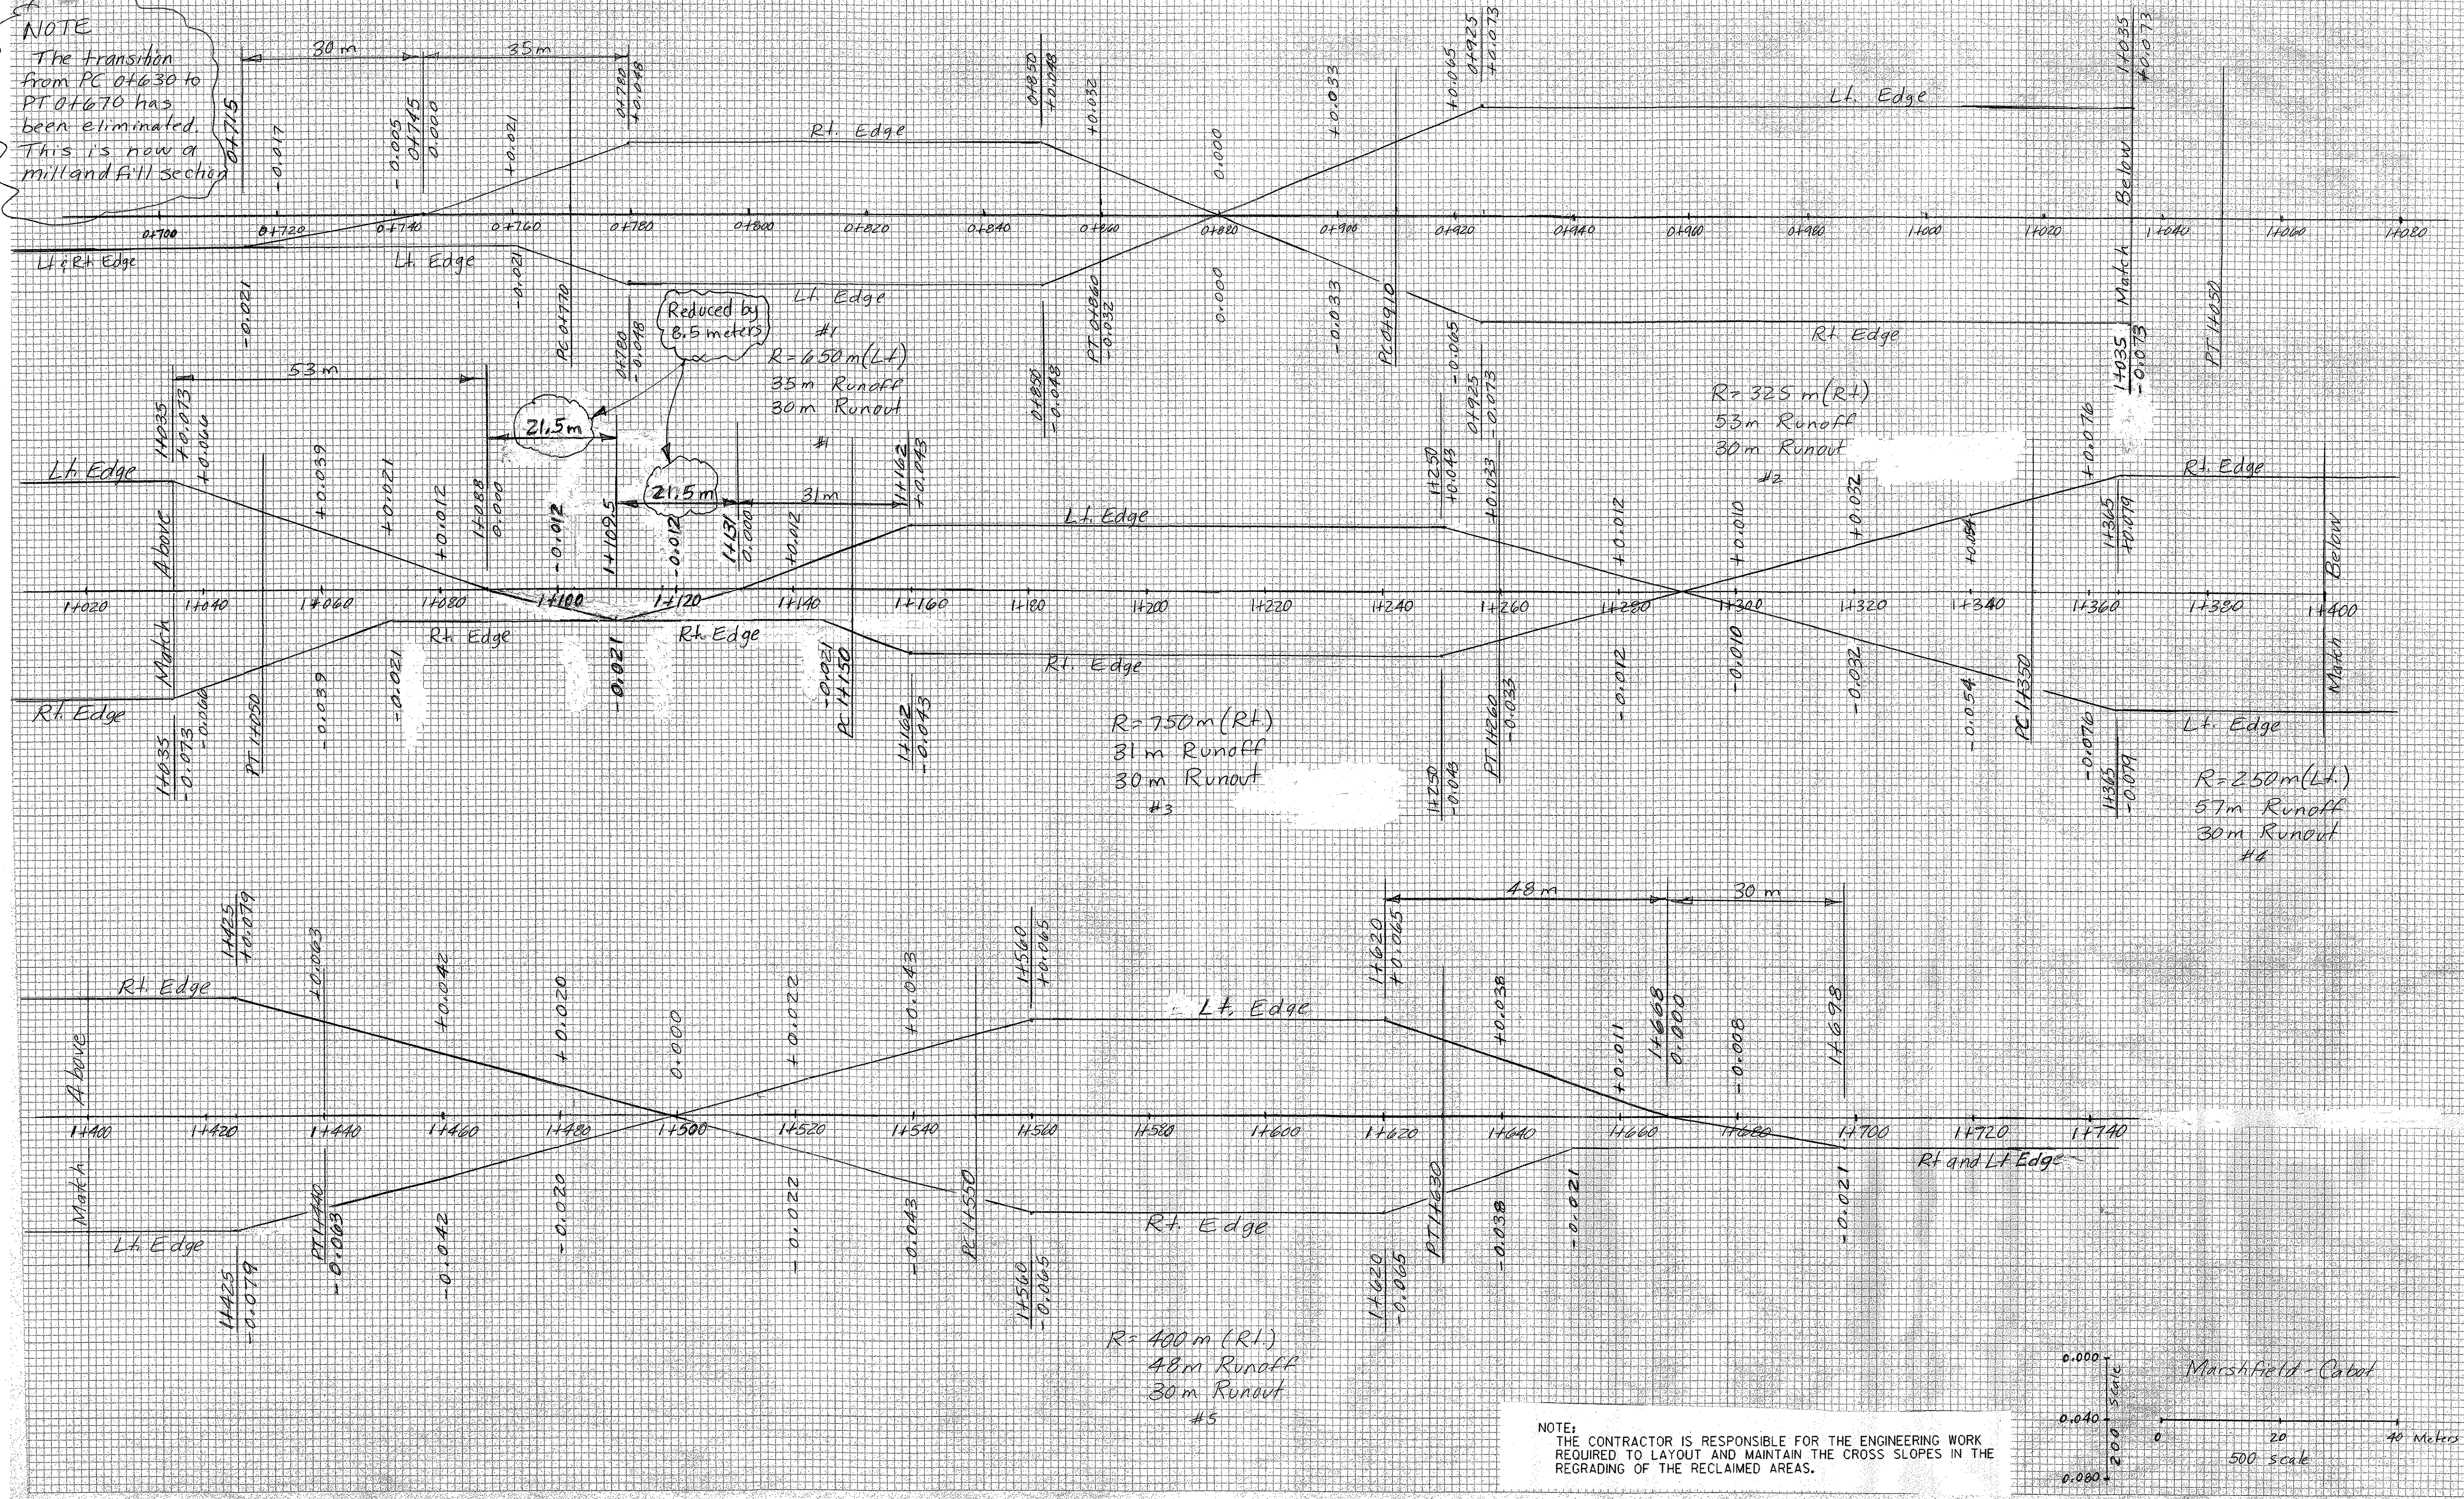