

R=2000m (Rt.)
Runoff=14m #21
Runout=30m


R=800m (Lt.)
Runoff=30m
Runout=30m #21

R=1300m (Rt.)
Runoff=19m #20
Runout=30m



R=1000m (Lt.)
Runoff=24m
Runout=30m #23

R=440m (Lt.)
Runoff=45m
Runout=30m #24

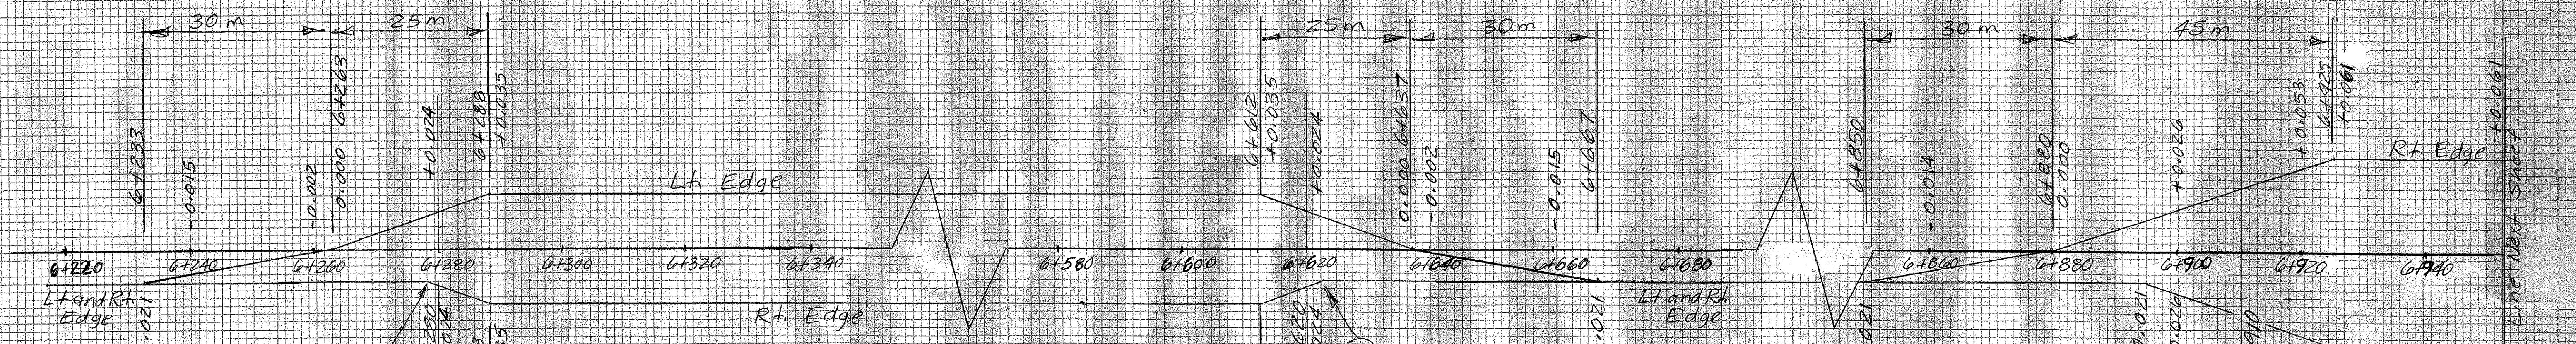

R=975m (Rt.)
Runoff=25m
Runout=30m #25

R=450m (Lt.)
Runoff=45m
Runout=30m #26

NOTE: THE CONTRACTOR IS RESPONSIBLE FOR THE ENGINEERING WORK REQUIRED TO LAYOUT AND MAINTAIN THE CROSS SLOPES IN THE REGRADING OF THE RECLAIMED AREAS.

Marshfield-Cabot
Meters
500 scale