

646.40 DURABLE 100 mm WHITE LINE (THERMOPLASTIC)  
 (ALL LINES WILL INCLUDE EDGE LINE BREAKS AND RADIUS FOR TOWN HIGHWAYS)

WALLINGFORD:  
 STA. 0+320.0 - STA. 0+700.0 LT & RT

646.60 TEMPORARY 100 mm WHITE LINE (PAINT)  
 (ALL LINES WILL INCLUDE EDGE LINE BREAKS AND RADIUS FOR TOWN HIGHWAYS)

WALLINGFORD:  
 STA. 0+320.0 - STA. 0+700.0 LT & RT

675.50 REMOVING SIGNS

AS SHOWN - 7-8


646.41 DURABLE 100 mm YELLOW LINE (THERMOPLASTIC)  
 (ALL LINES WILL INCLUDE C/L BREAKS FOR TOWN HIGHWAYS) S=SOLID, D=DASHED

WALLINGFORD:  
 STA. 0+320.0 - STA. 0+700.0 LT S - RT S

646.61 TEMPORARY 100 mm YELLOW LINE (PAINT)  
 (ALL LINES WILL INCLUDE C/L BREAKS FOR TOWN HIGHWAYS) S=SOLID, D=DASHED

WALLINGFORD:  
 STA. 0+320.0 - STA. 0+700.0 LT S - RT S

675.60 ERECTING SALVAGED SIGNS  
 AS SHOWN - 1

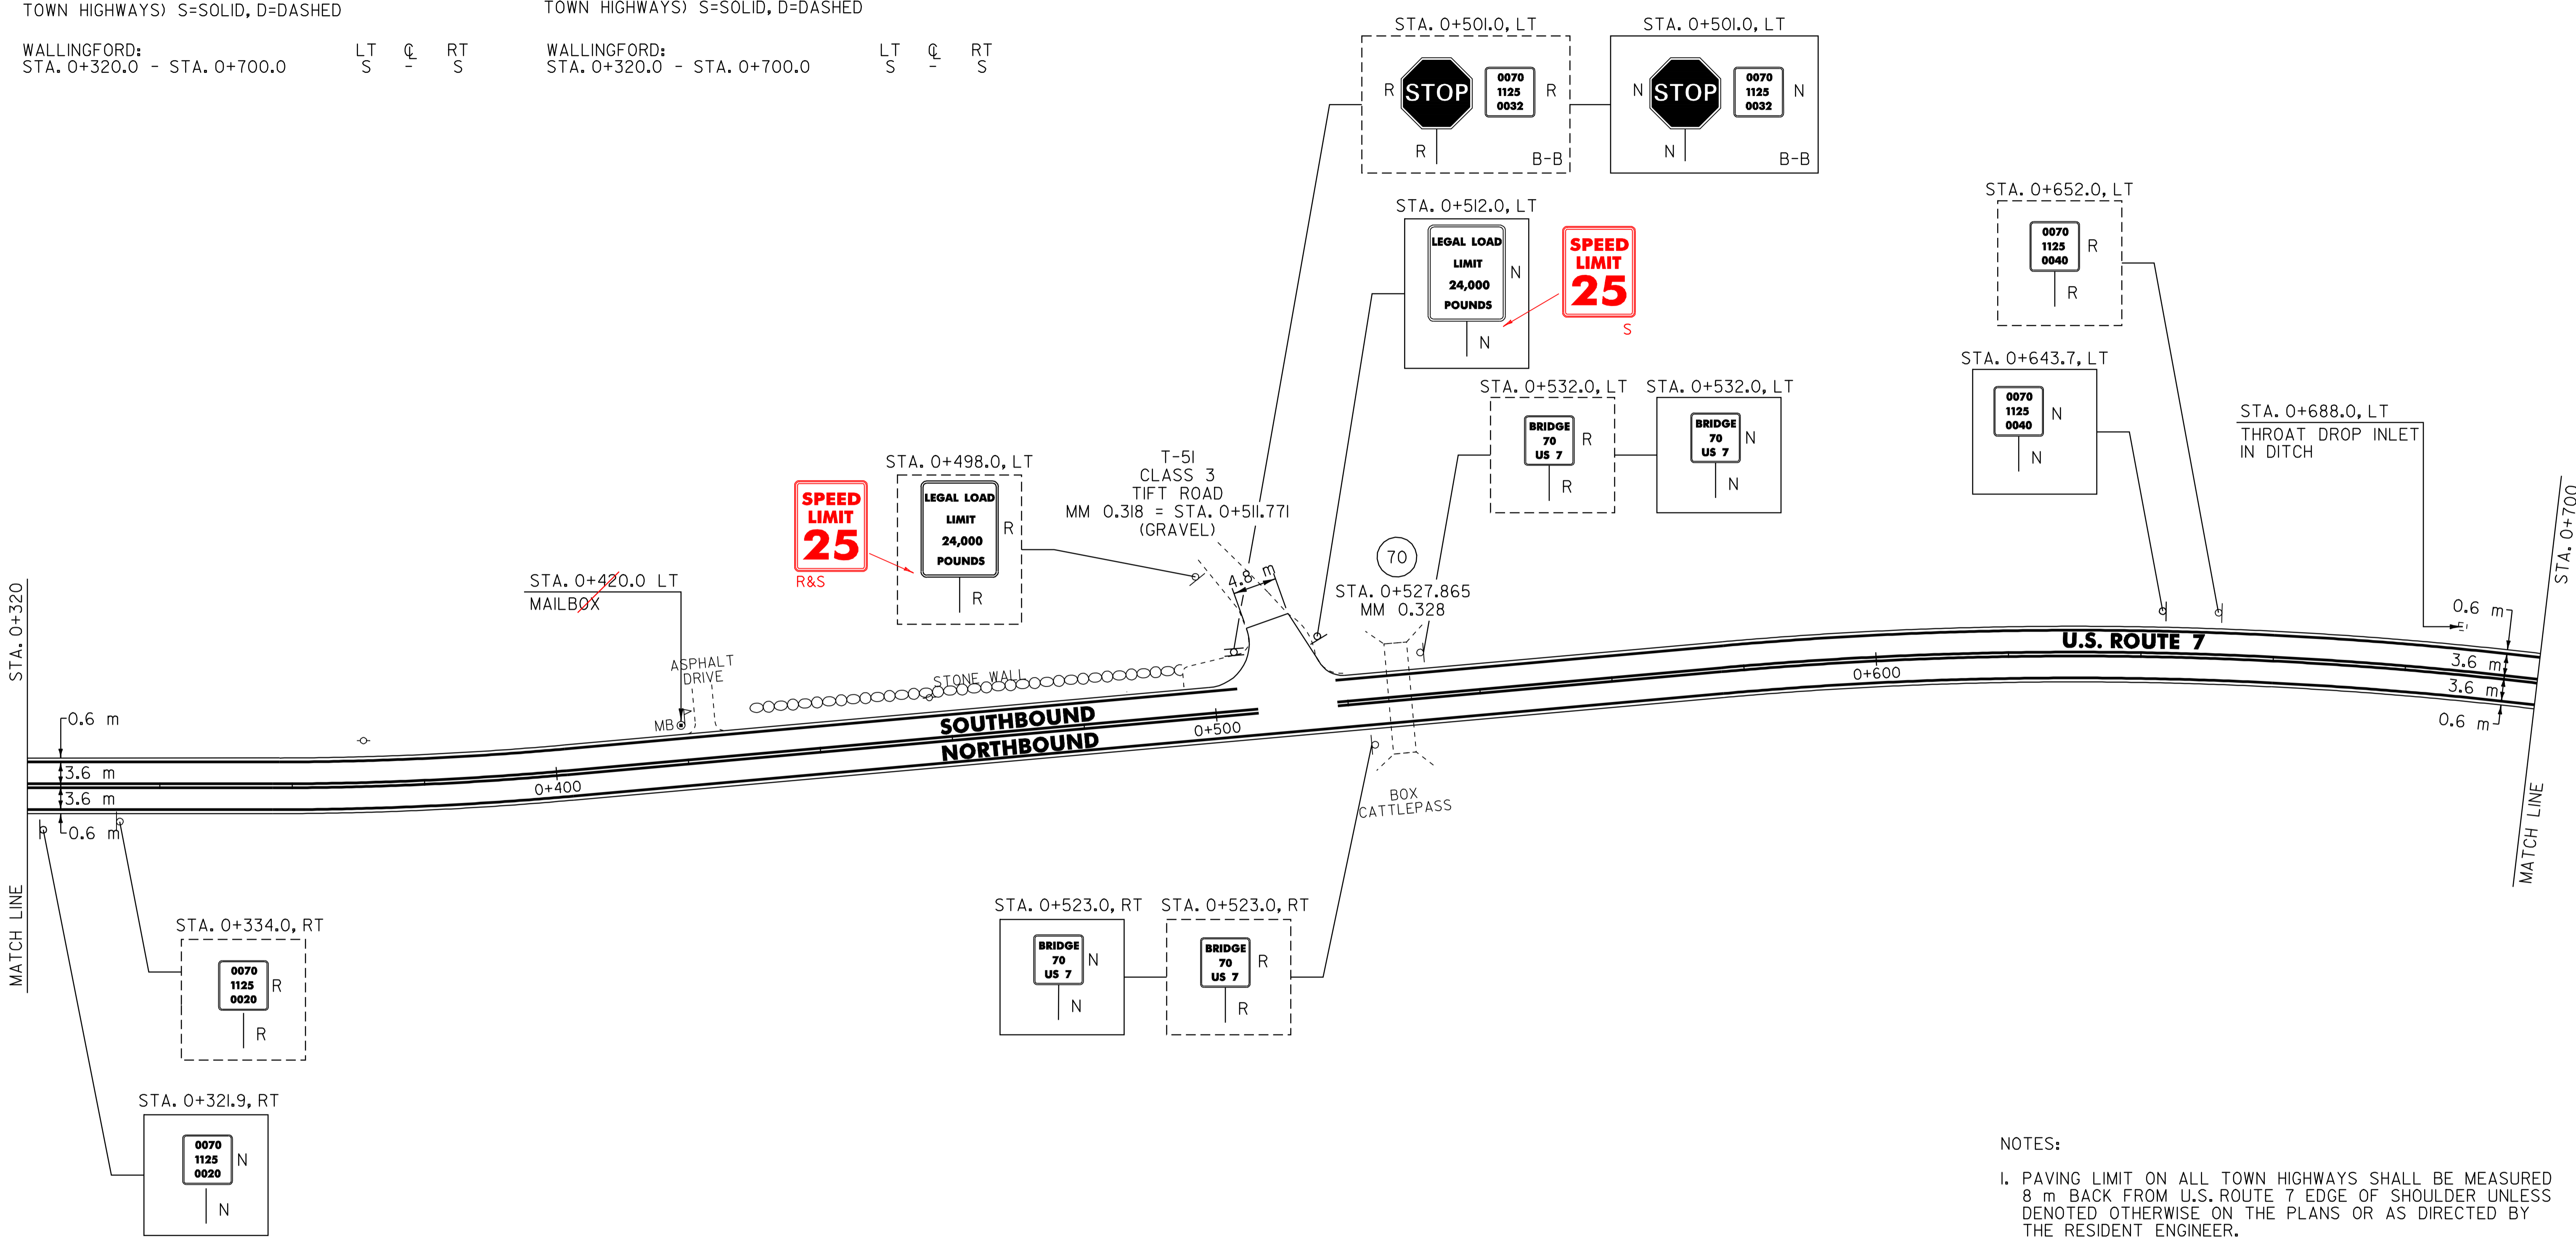

MATCH LINE STA. 0+320

MATCH LINE STA. 0+700

- NOTES:
- PAVING LIMIT ON ALL TOWN HIGHWAYS SHALL BE MEASURED 8 m BACK FROM U.S. ROUTE 7 EDGE OF SHOULDER UNLESS DENOTED OTHERWISE ON THE PLANS OR AS DIRECTED BY THE RESIDENT ENGINEER.
  - THE CONTRACTOR SHOULD BE AWARE THAT EXISTING BURIED UTILITIES (SUCH AS PHONE CABLE, FIBER OPTIC CABLE, SEWER LINES, ETC.) ARE LOCATED ADJACENT TO U.S. ROUTE 7 WITHIN THE PROJECT LIMITS. THE CONTRACTOR IS RESPONSIBLE FOR CONTACTING "DIG SAFE" AT 1-888-344-7233 TO DETERMINE THE EXACT LOCATIONS OF THESE UTILITIES PRIOR TO INSTALLING GUARDRAIL, CLEANING DITCHES OR PERFORMING ANY OTHER OPERATIONS THAT MAY DISTURB THE EXISTING SUBSURFACE CONDITIONS.

**SIGN LEGEND**  
 R= REMOVE  
 S= SALVAGE  
 N= NEW  
 RET= RETAIN  
 B-B= BACK TO BACK  
 EXISTING= -----  
 NEW= \_\_\_\_\_  
 ⊕ = SIGN TO BE RETURNED TO THE TOWN OF WALLINGFORD

**PAVING PROJECT LAYOUT # 2**

SURVEYED BY N/A DATE N/A  
 DRAWN BY C.A.K. DATE 8/05  
 SQUAD LEADER D.E.G.  
 DESIGN FILE NO. ⊃pave\98b098\pb098.dgn  
 IPARM FILE pb098i02.i DATE PLOTTED 08-JUL-2007 15:00  
 PROJ. NAME WALLINGFORD  
 PROJ. NO. NH\_210811S\_&\_SIP\_EHQ4(6)  
 SHEET 22 OF 110 SHEETS

604.412 REHABING DI, CB OR MH, CLASS 1  
 WALLINGFORD:  
 STA. 0+688.0 LT  
~~617.10 RELOCATE MAILBOX, SINGLE UNIT~~  
 WALLINGFORD:  
~~STA. 0+420.0 LT~~

DATUM  
 VERTICAL N/A  
 HORIZONTAL N/A