

646.40 DURABLE 100 mm WHITE LINE (THERMOPLASTIC)  
(ALL LINES WILL INCLUDE EDGE LINE BREAKS AND RADIUS FOR TOWN HIGHWAYS)

WALLINGFORD:  
STA. 1+840.0 - STA. 2+220.0 LT & RT

646.41 DURABLE 100 mm YELLOW LINE (THERMOPLASTIC)  
(ALL LINES WILL INCLUDE C/L BREAKS FOR TOWN HIGHWAYS) S=SOLID, D=DASHED

WALLINGFORD:  
STA. 1+840.0 - STA. 2+220.0 LT S C RT S  
STA. 1+850.746 DOUBLE SOLID, RT T-59

646.46 DURABLE 600 mm STOP BAR (THERMOPLASTIC)

WALLINGFORD:  
STA. 1+850.746 RT, T-59

646.50 DURABLE LETTER OR SYMBOL (THERMOPLASTIC)

WALLINGFORD:  
STA. 1+850.746 RT, T-59, "S,T,O,P" (4 EA)  
STA. 1+886.0, LT

646.60 TEMPORARY 100 mm WHITE LINE (PAINT)  
(ALL LINES WILL INCLUDE EDGE LINE BREAKS AND RADIUS FOR TOWN HIGHWAYS)

WALLINGFORD:  
STA. 1+840.0 - STA. 2+220.0 LT & RT

646.61 TEMPORARY 100 mm YELLOW LINE (PAINT)  
(ALL LINES WILL INCLUDE C/L BREAKS FOR TOWN HIGHWAYS) S=SOLID, D=DASHED

WALLINGFORD:  
STA. 1+840.0 - STA. 2+220.0 LT S C RT S  
STA. 1+850.746 DOUBLE SOLID RT, T-59

646.66 TEMPORARY 600 mm STOP BAR (PAINT)


WALLINGFORD:  
STA. 1+850.746 RT, T-59

~~646.70 TEMPORARY LETTER OR SYMBOL (PAINT)~~

WALLINGFORD:  
~~STA. 1+850.746 RT, T-59, "S,T,O,P" (4 EA)~~

675.50 REMOVING SIGNS  
AS SHOWN - 17

675.60 ERECTING SALVAGED SIGNS  
AS SHOWN - 2

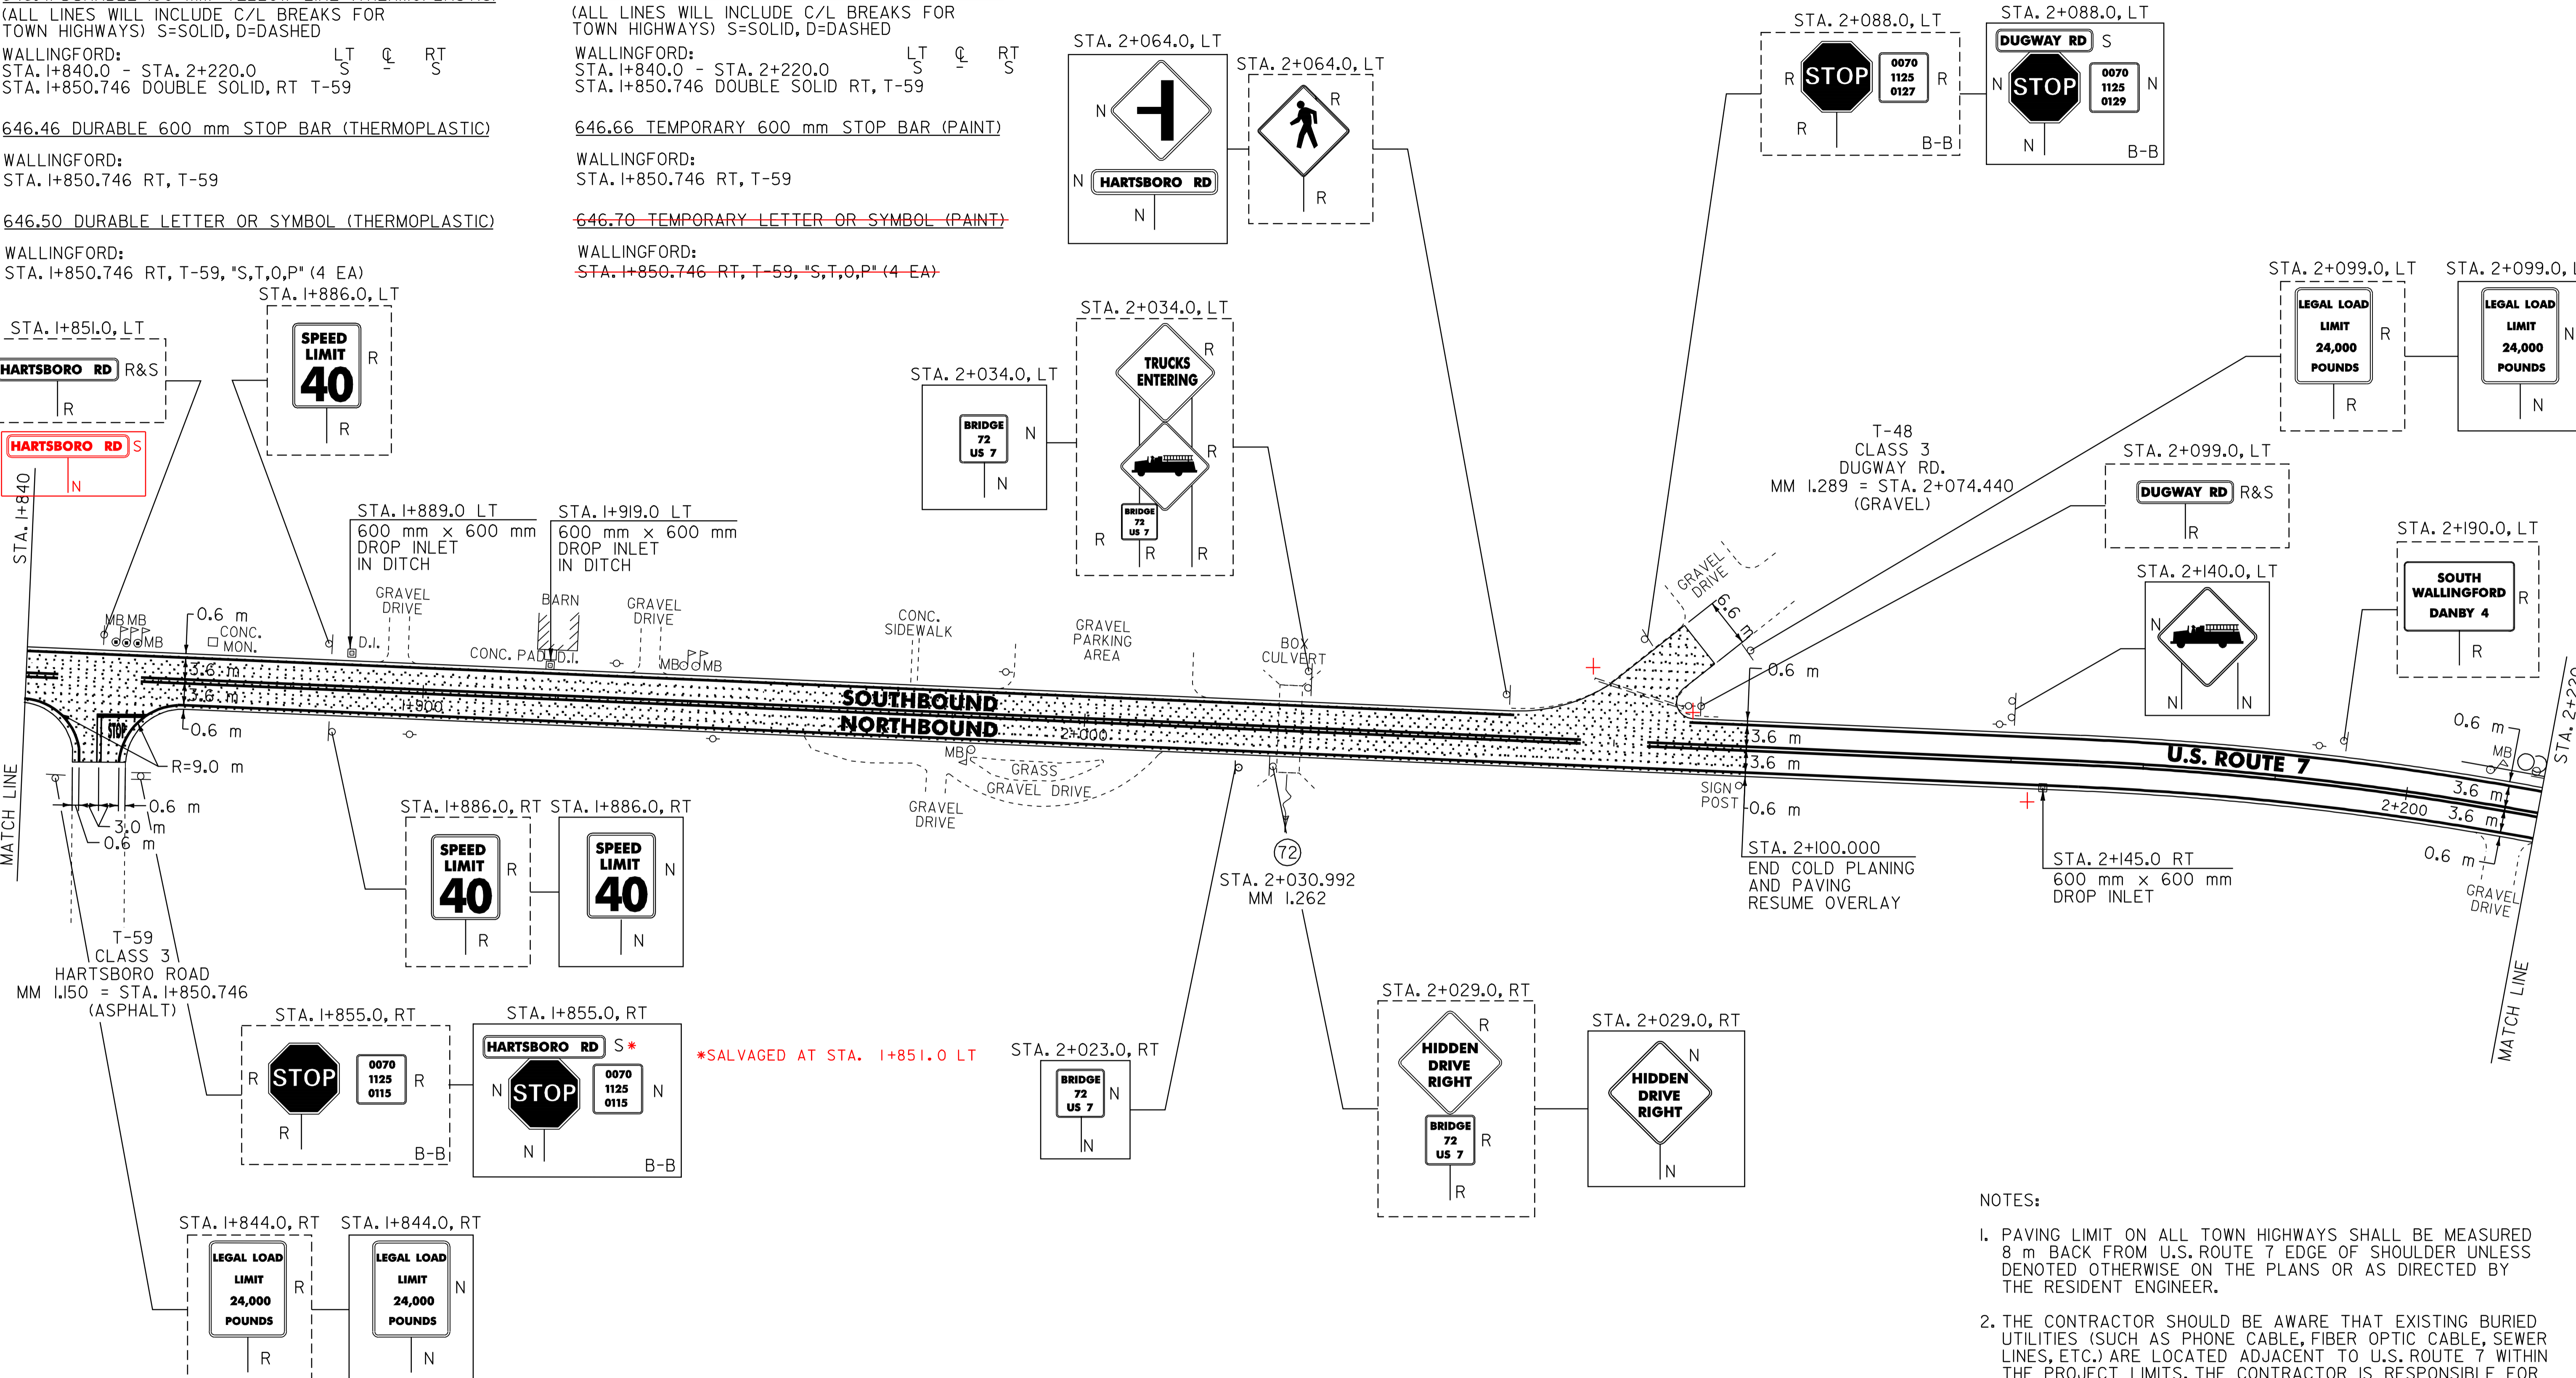

DATUM

VERTICAL	N/A
HORIZONTAL	N/A

604.412 REHABING DI, CB OR MH, CLASS I  
WALLINGFORD:  
STA. 1+889.0 LT  
~~STA. 1+919.0 LT~~  
STA. 2+145.0 RT

621.80 REMOVAL AND DISPOSAL OF GUARDRAIL  
WALLINGFORD:  
STA. 2+217.0 - STA. 2+220.0 LT (3.0 m)

621.55 MANUFACTURED TERMINAL SECTION (FLARED)  
WALLINGFORD:  
STA. 2+217.0 - STA. 2+220.0, LT

SIGN LEGEND  
R= REMOVE  
S= SALVAGE  
N= NEW  
RET= RETAIN  
B-B= BACK TO BACK  
EXISTING= \_\_\_\_\_  
NEW= \_\_\_\_\_  
⊙ = SIGN TO BE RETURNED TO THE TOWN OF WALLINGFORD

- NOTES:
- PAVING LIMIT ON ALL TOWN HIGHWAYS SHALL BE MEASURED 8 m BACK FROM U.S. ROUTE 7 EDGE OF SHOULDER UNLESS DENOTED OTHERWISE ON THE PLANS OR AS DIRECTED BY THE RESIDENT ENGINEER.
  - THE CONTRACTOR SHOULD BE AWARE THAT EXISTING BURIED UTILITIES (SUCH AS PHONE CABLE, FIBER OPTIC CABLE, SEWER LINES, ETC.) ARE LOCATED ADJACENT TO U.S. ROUTE 7 WITHIN THE PROJECT LIMITS. THE CONTRACTOR IS RESPONSIBLE FOR CONTACTING "DIG SAFE" AT 1-888-344-7233 TO DETERMINE THE EXACT LOCATIONS OF THESE UTILITIES PRIOR TO INSTALLING GUARDRAIL, CLEANING DITCHES OR PERFORMING ANY OTHER OPERATIONS THAT MAY DISTURB THE EXISTING SUBSURFACE CONDITIONS.

<h2>PAVING PROJECT LAYOUT</h2> <h3># 6</h3>	SURVEYED BY	N/A	DATE	N/A
	DRAWN BY	C.A.K.	DATE	8/05
	SQUAD LEADER	D.E.G.		
	DESIGN FILE NO.	pave\98b098\pb098.dgn		
	IPARM FILE	pb098\06.i	DATE PLOTTED	08-JUL-2007 15:40
PROJ. NAME	WALLINGFORD			
PROJ. NO.	NH_210811S_&_SIP_EHQ4(6)			
SHEET	26	OF	110	SHEETS