

646.40 DURABLE 100 mm WHITE LINE (THERMOPLASTIC)
 (ALL LINES WILL INCLUDE EDGE LINE BREAKS AND RADIUS FOR TOWN HIGHWAYS)

WALLINGFORD:
 STA. 2+220.0 - STA. 2+580.0 LT & RT

646.41 DURABLE 100 mm YELLOW LINE (THERMOPLASTIC)
 (ALL LINES WILL INCLUDE C/L BREAKS FOR TOWN HIGHWAYS) S=SOLID, D=DASHED

WALLINGFORD:
 STA. 2+220.0 - STA. 2+580.0 LT S C RT S

646.60 TEMPORARY 100 mm WHITE LINE (PAINT)
 (ALL LINES WILL INCLUDE EDGE LINE BREAKS AND RADIUS FOR TOWN HIGHWAYS)

WALLINGFORD:
 STA. 2+220.0 - STA. 2+580.0 LT & RT

646.61 TEMPORARY 100 mm YELLOW LINE (PAINT)
 (ALL LINES WILL INCLUDE C/L BREAKS FOR TOWN HIGHWAYS) S=SOLID, D=DASHED


WALLINGFORD:
 STA. 2+220.0 - STA. 2+580.0 LT S C RT S

675.50 REMOVING SIGNS

AS SHOWN - 15

675.60 ERECTING SALVAGED SIGNS

AS SHOWN - 3 2

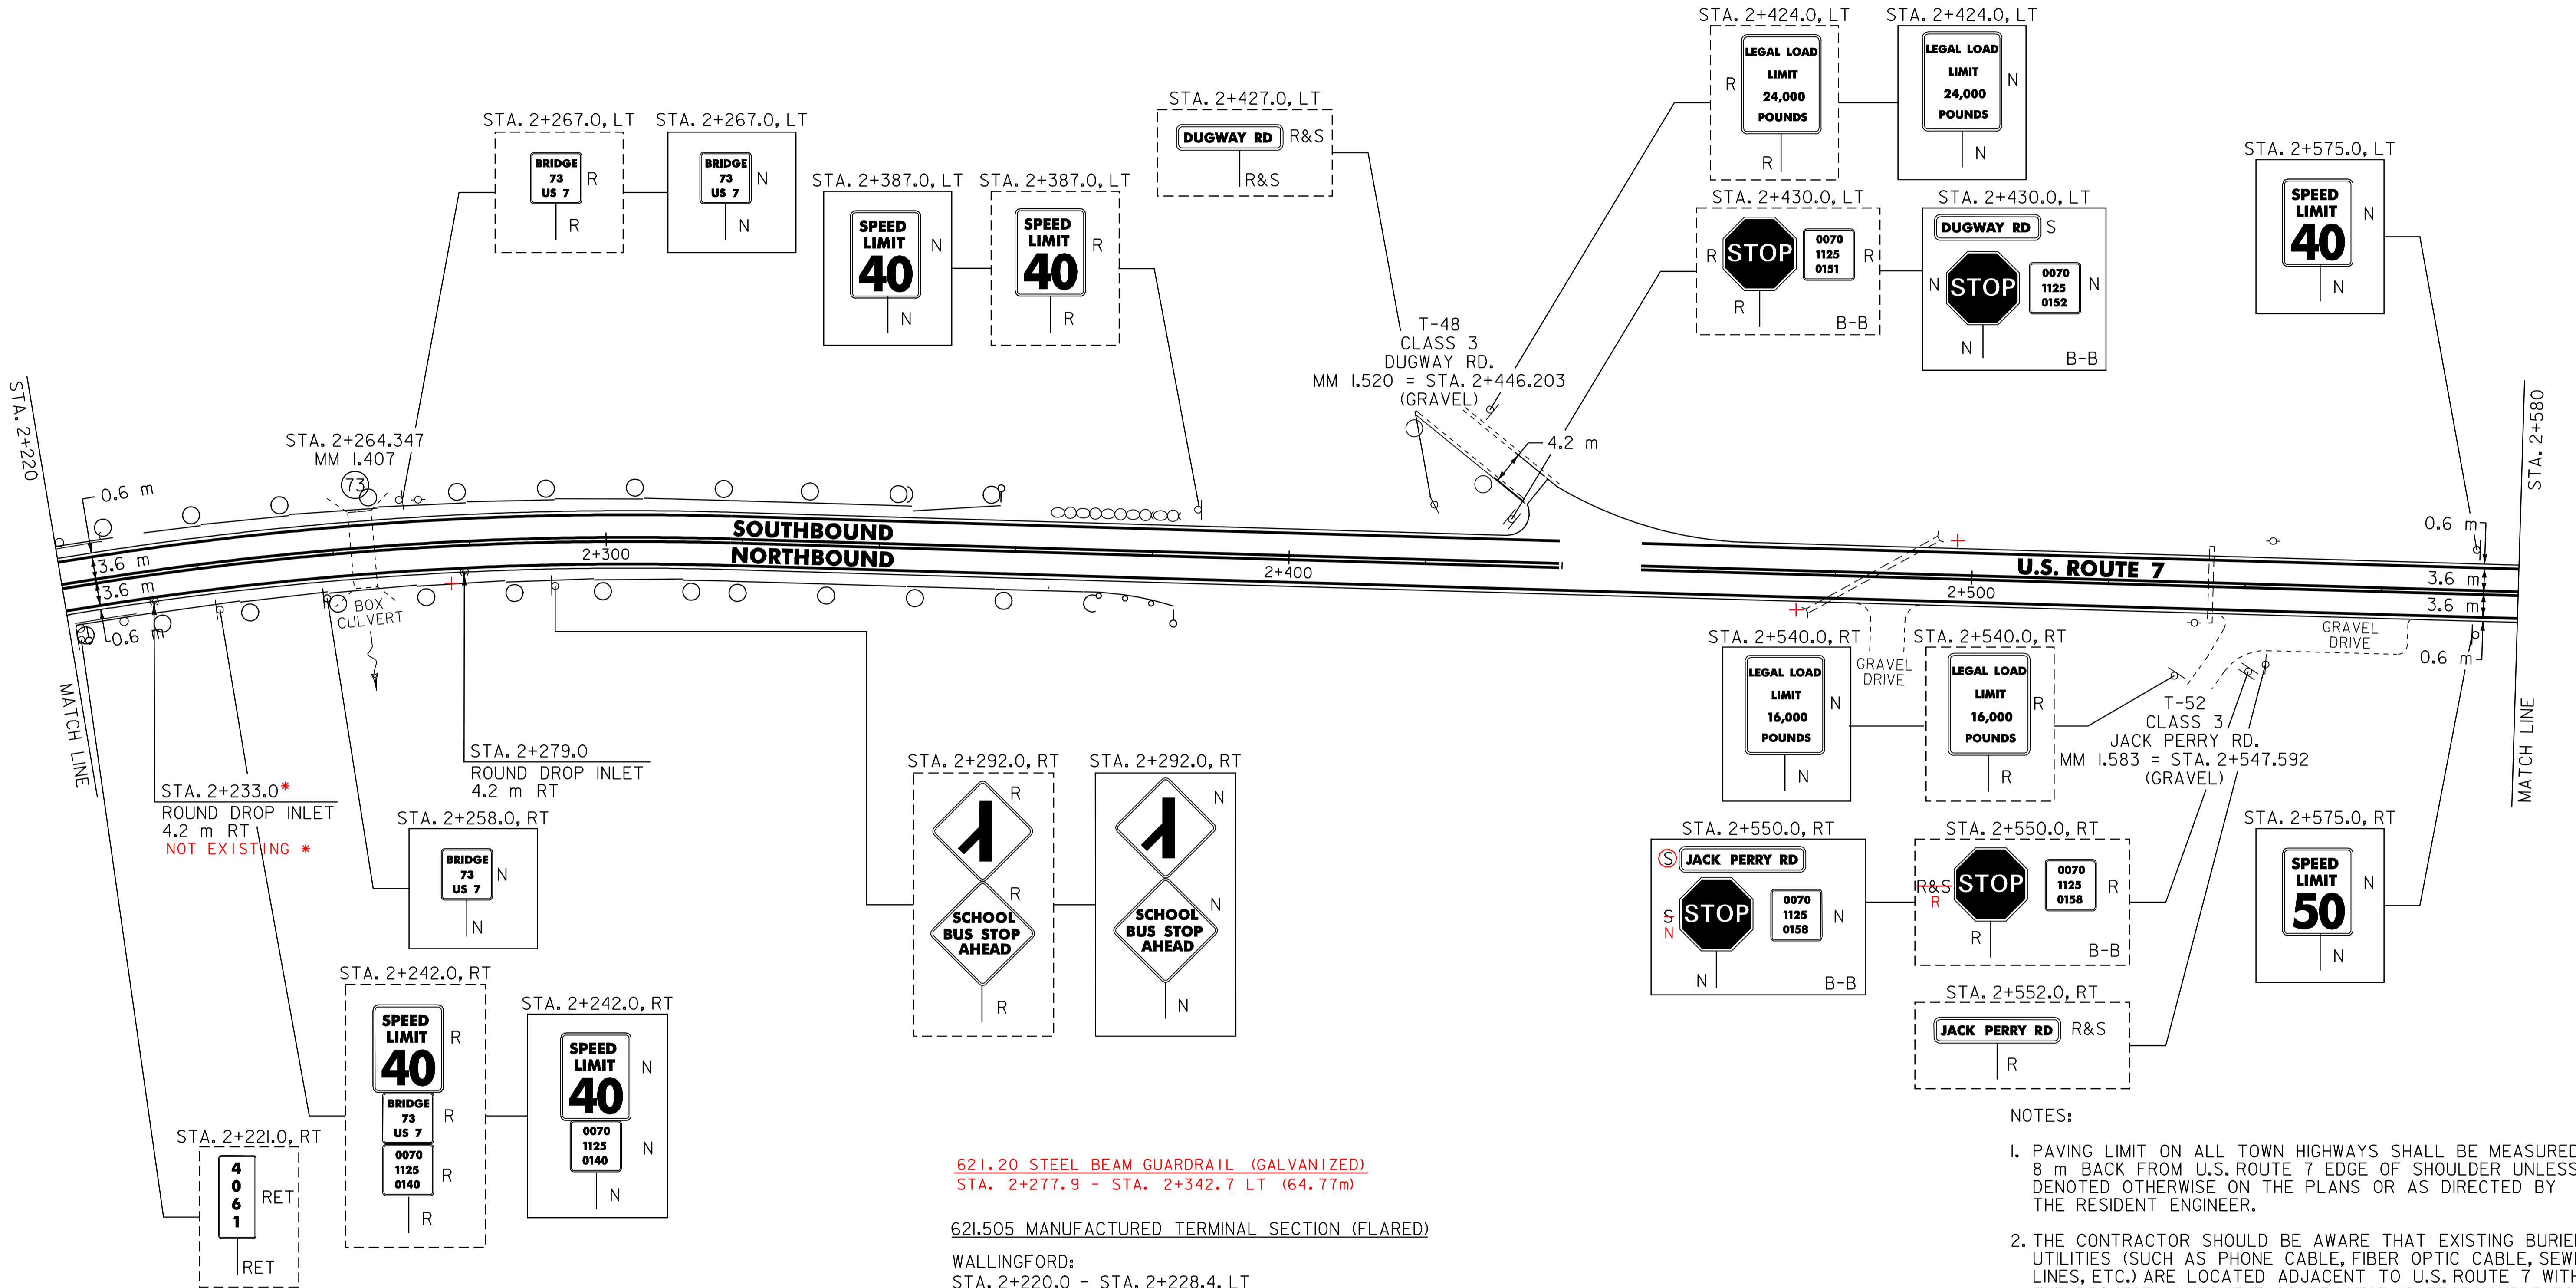

621.20 STEEL BEAM GUARDRAIL (GALVANIZED)
 STA. 2+277.9 - STA. 2+342.7 LT (64.77m)

621.505 MANUFACTURED TERMINAL SECTION (FLARED)

WALLINGFORD:
 STA. 2+220.0 - STA. 2+228.4, LT
 STA. 2+220.0 - STA. 2+231.4, RT
 STA. 2+346.2 - STA. 2+357.6, LT
 STA. 2+372.0 - STA. 2+383.4, RT

621.80 REMOVAL AND DISPOSAL OF GUARDRAIL

WALLINGFORD:
 STA. 2+220.0 - STA. 2+380.0 RT (160.0 m)
 STA. 2+220.0 - STA. 2+355.0 LT (135.0 m)

676.10 DELINEATORS WITH STEEL POSTS

WALLINGFORD:
 TYPE I WHITE
 STA. 2+220.0 RT
 STA. 2+357.6 LT
 STA. 2+383.4 RT

604.412 REHABING DI, CB OR MH, CLASS I

WALLINGFORD:
~~STA. 2+233.0 RT *~~
 STA. 2+279.0 RT

616.35 TREATED TIMBER CURB

WALLINGFORD: (133.35m)
 STA. 2+233.0 - STA. 2+368.0 RT ~~(435.0-m)~~

621.20 STEEL BEAM GUARDRAIL W/2.4 m POSTS (MOD.) (GALVANIZED)

WALLINGFORD: 2+277.9 LT (49.53m)
 STA. 2+228.4 - STA. 2+346.2 LT (117.8 m)
 STA. 2+231.4 - STA. 2+372.0 RT (140.6 m)

- NOTES:
- PAVING LIMIT ON ALL TOWN HIGHWAYS SHALL BE MEASURED 8 m BACK FROM U.S. ROUTE 7 EDGE OF SHOULDER UNLESS DENOTED OTHERWISE ON THE PLANS OR AS DIRECTED BY THE RESIDENT ENGINEER.
 - THE CONTRACTOR SHOULD BE AWARE THAT EXISTING BURIED UTILITIES (SUCH AS PHONE CABLE, FIBER OPTIC CABLE, SEWER LINES, ETC.) ARE LOCATED ADJACENT TO U.S. ROUTE 7 WITHIN THE PROJECT LIMITS. THE CONTRACTOR IS RESPONSIBLE FOR CONTACTING "DIG SAFE" AT 1-888-344-7233 TO DETERMINE THE EXACT LOCATIONS OF THESE UTILITIES PRIOR TO INSTALLING GUARDRAIL, CLEANING DITCHES OR PERFORMING ANY OTHER OPERATIONS THAT MAY DISTURB THE EXISTING SUBSURFACE CONDITIONS.

SIGN LEGEND
 R= REMOVE
 S= SALVAGE
 N= NEW
 RET= RETAIN
 B-B= BACK TO BACK
 EXISTING= -----
 NEW= _____
 ⊕ = SIGN TO BE RETURNED TO THE TOWN OF WALLINGFORD

PAVING PROJECT LAYOUT # 7

SURVEYED BY	N/A	DATE	N/A
DRAWN BY	C.A.K.	DATE	8/05
SQUAD LEADER	D.E.G.		
DESIGN FILE NO.	pave\98b098\pb098.dgn		
IPARM FILE	pb098\07.1	DATE PLOTTED	08-JUL-2007 15:40
PROJ. NAME	WALLINGFORD		
PROJ. NO.	NH_210811S_&_SIP_EHQ4(6)		
SHEET	27	OF	110 SHEETS

DATUM	
VERTICAL	N/A
HORIZONTAL	N/A