

646.40 DURABLE 100 mm WHITE LINE (THERMOPLASTIC)

(ALL LINES WILL INCLUDE EDGE LINE BREAKS AND RADIUS FOR TOWN HIGHWAYS)

WALLINGFORD:
STA. 2+960.0 - STA. 3+340.0 LT & RT

646.41 DURABLE 100 mm YELLOW LINE (THERMOPLASTIC)

(ALL LINES WILL INCLUDE C/L BREAKS FOR TOWN HIGHWAYS) S=SOLID, D=DASHED

WALLINGFORD: LT C RT
STA. 2+960.0 - STA. 3+340.0 S - S

646.60 TEMPORARY 100 mm WHITE LINE (PAINT)

(ALL LINES WILL INCLUDE EDGE LINE BREAKS AND RADIUS FOR TOWN HIGHWAYS)

WALLINGFORD:
STA. 2+960.0 - STA. 3+340.0 LT & RT


646.61 TEMPORARY 100 mm YELLOW LINE (PAINT)

(ALL LINES WILL INCLUDE C/L BREAKS FOR TOWN HIGHWAYS) S=SOLID, D=DASHED

WALLINGFORD: LT C RT
STA. 2+960.0 - STA. 3+340.0 S - S

675.50 REMOVING SIGNS

AS SHOWN - I

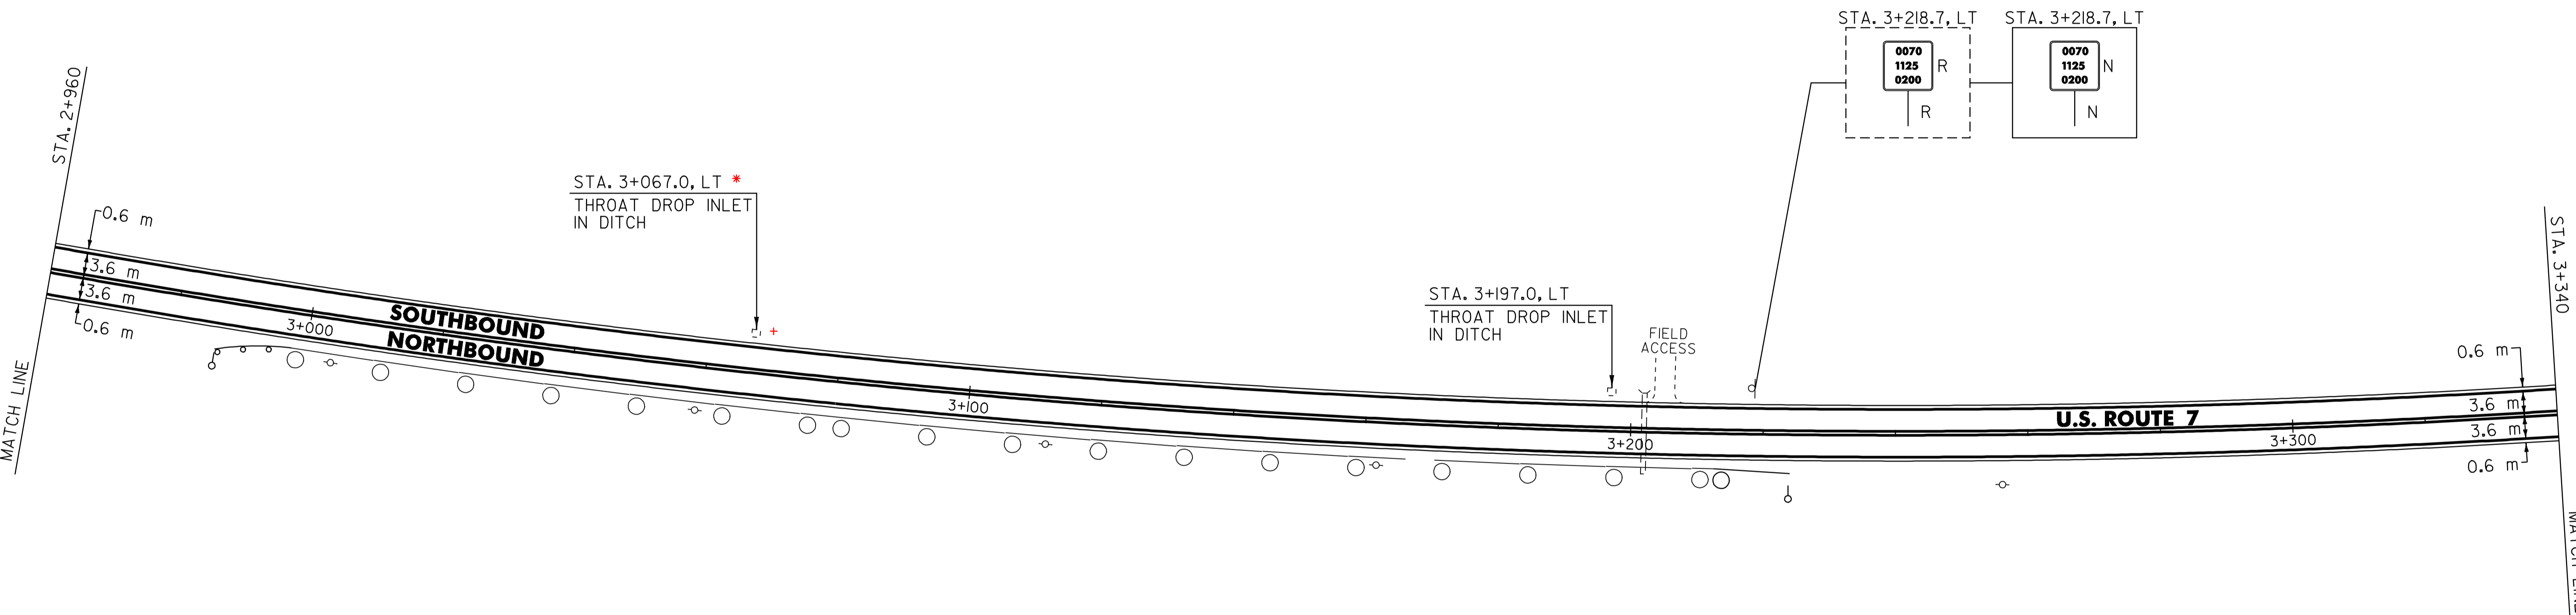

621.20 STEEL BEAM GUARDRAIL w/2.4m POSTS (MOD.) (GALVANIZED)

STA. 2+997.6 - STA. 3+077.6 RT (80.01m)
STA. 3+146.2 - STA. 3+188.1 RT (41.91m)

604.412 REHABING DI, CB OR MH, CLASS I

WALLINGFORD:
STA. 3+067.0 LT
STA. 3+197.0 LT

621.20 STEEL BEAM GUARDRAIL (GALVANIZED)

WALLINGFORD:
~~STA. 2+997.6 - STA. 3+210.4 RT (212.8 m)~~
STA. 3+077.6 - STA. 3+146.2 RT (68.58)
STA. 3+188.1 - STA. 3+214.7 RT (26.67)

621.505 MANUFACTURED TERMINAL SECTION (FLARED)

WALLINGFORD:
STA. 2+986.2 - STA. 2+997.6, RT
~~STA. 3+210.4 - STA. 3+221.8, RT~~

621.80 REMOVAL AND DISPOSAL OF GUARDRAIL

WALLINGFORD:
STA. 2+987.0 - STA. 3+221.0 RT (234.0 m)

676.10 DELINEATORS WITH STEEL POSTS

WALLINGFORD:
TYPE I WHITE
STA. 2+986.2 RT
STA. 3+221.8 RT

NOTE:

I. THE CONTRACTOR SHOULD BE AWARE THAT EXISTING BURIED UTILITIES (SUCH AS PHONE CABLE, FIBER OPTIC CABLE, SEWER LINES, ETC.) ARE LOCATED ADJACENT TO U.S. ROUTE 7 WITHIN THE PROJECT LIMITS. THE CONTRACTOR IS RESPONSIBLE FOR CONTACTING "DIG SAFE" AT 1-888-344-7233 TO DETERMINE THE EXACT LOCATIONS OF THESE UTILITIES PRIOR TO INSTALLING GUARDRAIL, CLEANING DITCHES OR PERFORMING ANY OTHER OPERATIONS THAT MAY DISTURB THE EXISTING SUBSURFACE CONDITIONS.

SIGN LEGEND
R= REMOVE
S= SALVAGE
N= NEW
RET= RETAIN
B-B= BACK TO BACK
EXISTING= -----
NEW= -----
⊙ = SIGN TO BE RETURNED TO THE TOWN OF WALLINGFORD

<p>PAVING PROJECT LAYOUT # 9</p>	SURVEYED BY <u>N/A</u> DATE <u>N/A</u>
	DRAWN BY <u>C.A.K.</u> DATE <u>8/05</u>
	SQUAD LEADER <u>D.E.G.</u>
	DESIGN FILE NO. <u>\\pave\98b098\pb098.dgn</u>
	IPARM FILE <u>pb098i09.i</u> DATE PLOTTED <u>08-JUL-2007 15:00</u>
PROJ. NAME <u>WALLINGFORD</u>	
PROJ. NO. <u>NH_2108(1)S_&_SIP_EHQ4(6)</u>	
SHEET <u>29</u> OF <u>110</u> SHEETS	

DATUM	
VERTICAL	<u>N/A</u>
HORIZONTAL	<u>N/A</u>