

646.40 DURABLE 100 mm WHITE LINE (THERMOPLASTIC)
(ALL LINES WILL INCLUDE EDGE LINE BREAKS AND RADIUS FOR TOWN HIGHWAYS)

WALLINGFORD:
STA. 3+340.0 - STA. 3+720.0 LT & RT

646.41 DURABLE 100 mm YELLOW LINE (THERMOPLASTIC)
(ALL LINES WILL INCLUDE C/L BREAKS FOR TOWN HIGHWAYS) S=SOLID, D=DASHED


WALLINGFORD: LT C RT
STA. 3+340.0 - STA. 3+720.0 S - S

646.60 TEMPORARY 100 mm WHITE LINE (PAINT)
(ALL LINES WILL INCLUDE EDGE LINE BREAKS AND RADIUS FOR TOWN HIGHWAYS)

WALLINGFORD:
STA. 3+340.0 - STA. 3+720.0 LT & RT

646.61 TEMPORARY 100 mm YELLOW LINE (PAINT)
(ALL LINES WILL INCLUDE C/L BREAKS FOR TOWN HIGHWAYS) S=SOLID, D=DASHED

WALLINGFORD: LT C RT
STA. 3+340.0 - STA. 3+720.0 S - S

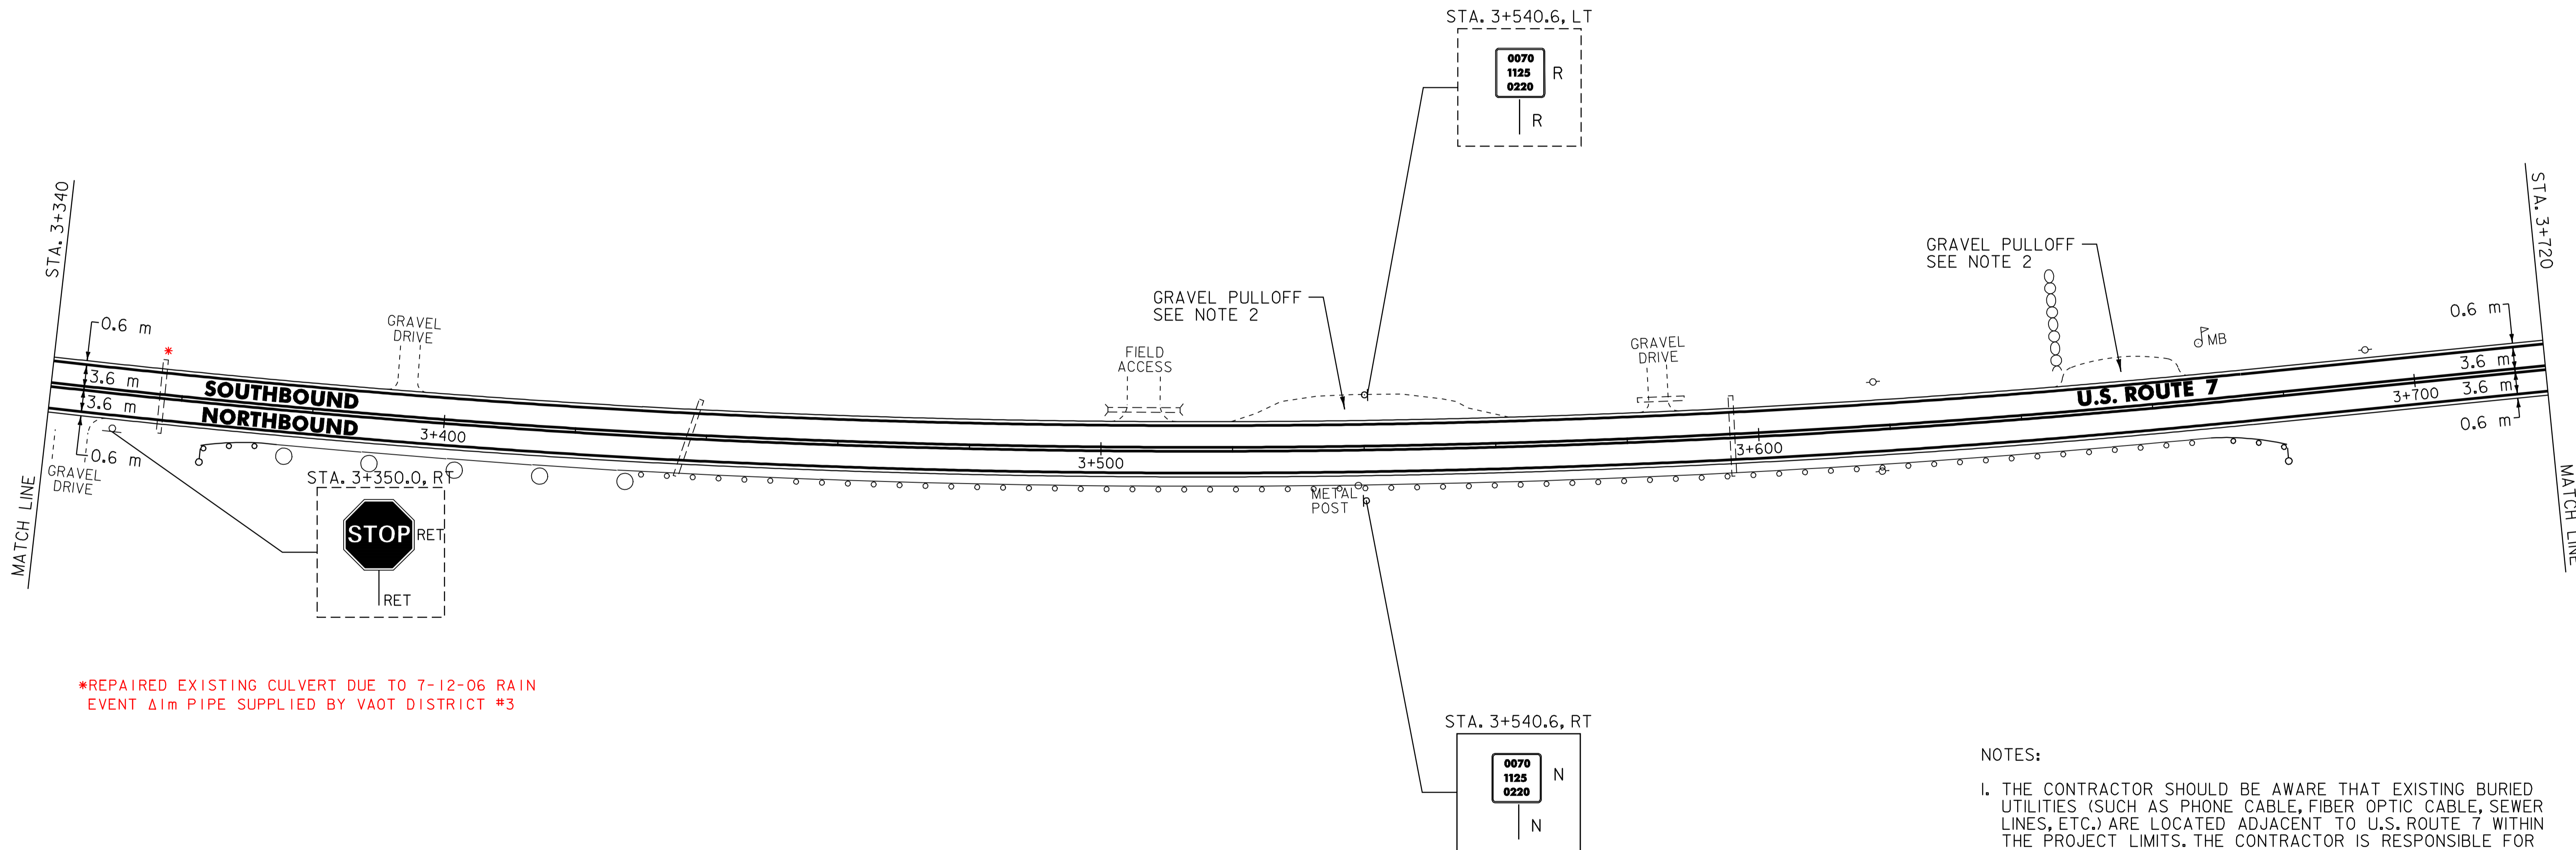

*REPAIRED EXISTING CULVERT DUE TO 7-12-06 RAIN EVENT Δ1m PIPE SUPPLIED BY VAOT DISTRICT #3

NOTES:

1. THE CONTRACTOR SHOULD BE AWARE THAT EXISTING BURIED UTILITIES (SUCH AS PHONE CABLE, FIBER OPTIC CABLE, SEWER LINES, ETC.) ARE LOCATED ADJACENT TO U.S. ROUTE 7 WITHIN THE PROJECT LIMITS. THE CONTRACTOR IS RESPONSIBLE FOR CONTACTING "DIG SAFE" AT 1-888-344-7233 TO DETERMINE THE EXACT LOCATIONS OF THESE UTILITIES PRIOR TO INSTALLING GUARDRAIL, CLEANING DITCHES OR PERFORMING ANY OTHER OPERATIONS THAT MAY DISTURB THE EXISTING SUBSURFACE CONDITIONS.
2. PLACE 100 mm OF COMPACTED COLD PLANE GRINDINGS ON THE EXISTING GRAVEL PULLOFF AND PROVIDE A 45 mm TYPE III 1.5 m WIDE APRON. ANY REQUIRED EXCAVATION SHALL BE PERFORMED AS DIRECTED BY THE RESIDENT ENGINEER AND PAID UNDER ITEM 608.25.

621.20 STEEL BEAM GUARDRAIL W/2.4 m POSTS (MOD.) (GALVANIZED)

WALLINGFORD:
STA. 3+374.9 - STA. 3+686.5 RT (311.6 m)

621.505 MANUFACTURED TERMINAL SECTION (FLARED)

WALLINGFORD:
STA. 3+363.5 - STA. 3+374.9, RT
STA. 3+686.5 - STA. 3+697.9, RT

676.10 DELINEATORS WITH STEEL POSTS

WALLINGFORD:
TYPE I WHITE
STA. 3+363.5 RT
STA. 3+697.9 RT

SIGN LEGEND
R= REMOVE
S= SALVAGE
N= NEW
RET= RETAIN
B-B= BACK TO BACK
EXISTING= -----
NEW= _____
⊙ = SIGN TO BE RETURNED TO THE TOWN OF WALLINGFORD

PAVING PROJECT LAYOUT # 10

SURVEYED BY N/A DATE N/A
DRAWN BY C.A.K. DATE 8/05
SQUAD LEADER D.E.G.
DESIGN FILE NO. zrove\98b098\pb098.dgn
IPARM FILE pb098\0.i DATE PLOTTED 08-JUL-2007 15:00
PROJ. NAME WALLINGFORD
PROJ. NO. NH_2108(1)S_&_SIP_EH04(6)
SHEET 30 OF 110 SHEETS

DATUM
VERTICAL N/A
HORIZONTAL N/A