

646.40 DURABLE 100 mm WHITE LINE (THERMOPLASTIC)
 (ALL LINES WILL INCLUDE EDGE LINE BREAKS AND RADIUS FOR TOWN HIGHWAYS)

WALLINGFORD:
 STA. 4+100.0 - STA. 4+480.0 LT & RT

646.60 TEMPORARY 100 mm WHITE LINE (PAINT)
 (ALL LINES WILL INCLUDE EDGE LINE BREAKS AND RADIUS FOR TOWN HIGHWAYS)

WALLINGFORD:
 STA. 4+100.0 - STA. 4+480.0 LT & RT


675.50 REMOVING SIGNS
 AS SHOWN - 3

646.41 DURABLE 100 mm YELLOW LINE (THERMOPLASTIC)
 (ALL LINES WILL INCLUDE C/L BREAKS FOR TOWN HIGHWAYS) S=SOLID, D=DASHED

WALLINGFORD:
 STA. 4+100.0 - STA. 4+480.0 LT S C RT S

646.61 TEMPORARY 100 mm YELLOW LINE (PAINT)
 (ALL LINES WILL INCLUDE C/L BREAKS FOR TOWN HIGHWAYS) S=SOLID, D=DASHED

WALLINGFORD:
 STA. 4+100.0 - STA. 4+480.0 LT S C RT S

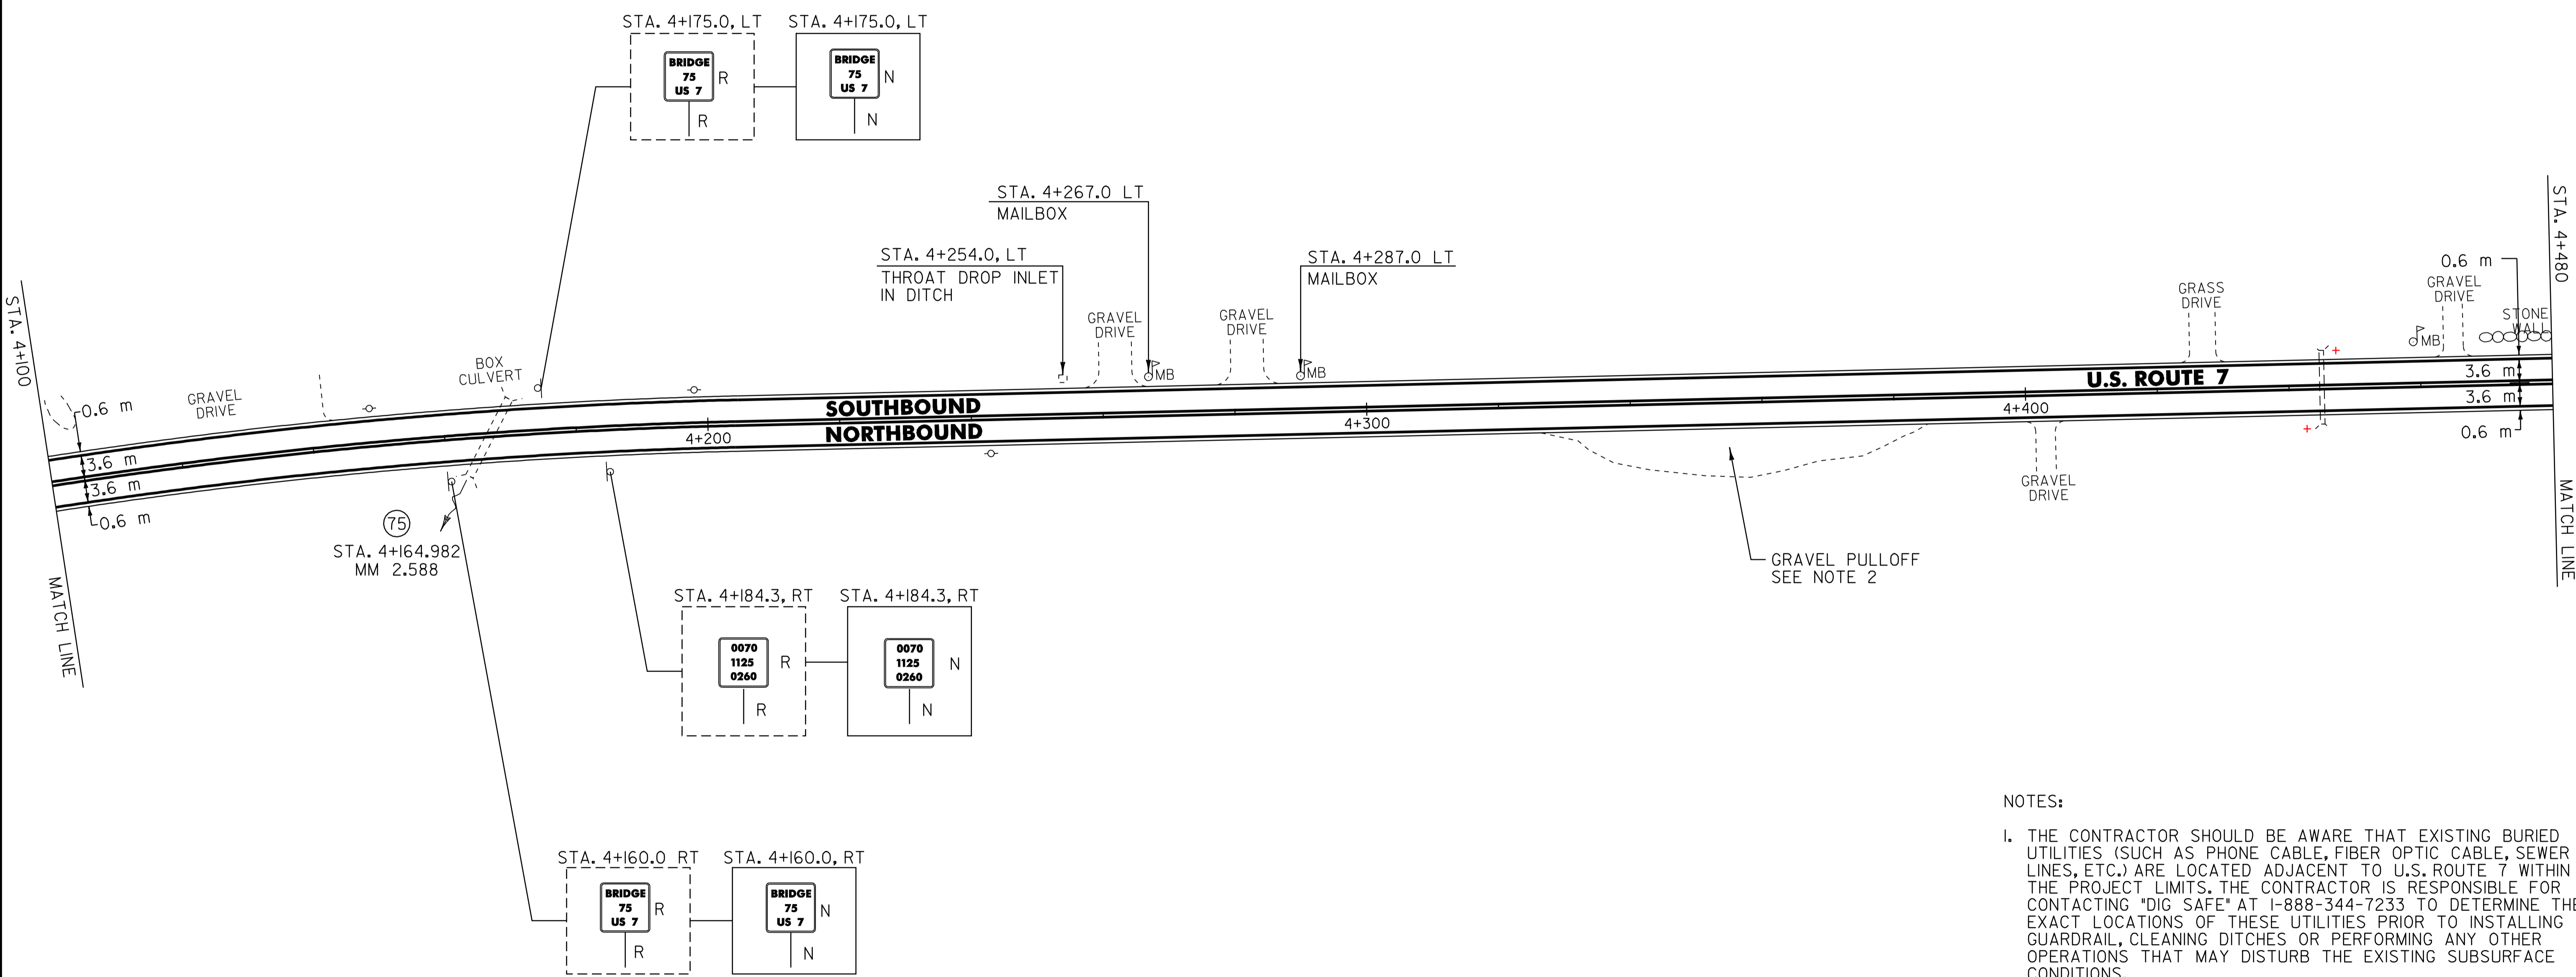

NOTES:

- THE CONTRACTOR SHOULD BE AWARE THAT EXISTING BURIED UTILITIES (SUCH AS PHONE CABLE, FIBER OPTIC CABLE, SEWER LINES, ETC.) ARE LOCATED ADJACENT TO U.S. ROUTE 7 WITHIN THE PROJECT LIMITS. THE CONTRACTOR IS RESPONSIBLE FOR CONTACTING "DIG SAFE" AT 1-888-344-7233 TO DETERMINE THE EXACT LOCATIONS OF THESE UTILITIES PRIOR TO INSTALLING GUARDRAIL, CLEANING DITCHES OR PERFORMING ANY OTHER OPERATIONS THAT MAY DISTURB THE EXISTING SUBSURFACE CONDITIONS.
- PLACE 100 mm OF COMPACTED COLD PLANE GRINDINGS ON THE EXISTING GRAVEL PULLOFF AND PROVIDE A 45 mm TYPE III S 1.5 m WIDE APRON. ANY REQUIRED EXCAVATION SHALL BE PERFORMED AS DIRECTED BY THE RESIDENT ENGINEER AND PAID UNDER ITEM 608.25.

SIGN LEGEND
 R= REMOVE
 S= SALVAGE
 N= NEW
 RET= RETAIN
 B-B= BACK TO BACK
 EXISTING= -----
 NEW= _____
 ⊙ = SIGN TO BE RETURNED TO THE TOWN OF WALLINGFORD

PAVING PROJECT LAYOUT # 12

SURVEYED BY N/A DATE N/A
 DRAWN BY C.A.K. DATE 8/05
 SQUAD LEADER D.E.G.
 DESIGN FILE NO. Ⓐpave\98b\098\pb098.dgn
 IPARM FILE pb098\2.1 DATE 02-JUL-2007 15
 PROJ. NAME WALLINGFORD
 PROJ. NO. NH_2108(1)S_&_SIP_EHQ4(6)
 SHEET 32 OF 110 SHEETS _____

604.412 REHABING DI, CB OR MH, CLASS I

WALLINGFORD:
 STA. 4+254.0 LT

~~617.10 RELOCATE MAILBOX, SINGLE SUPPORT~~

WALLINGFORD:
~~STA. 4+267.0 LT~~
~~STA. 4+287.0 LT~~

DATUM
 VERTICAL N/A
 HORIZONTAL N/A