

646.40 DURABLE 100 mm WHITE LINE (THERMOPLASTIC)
 (ALL LINES WILL INCLUDE EDGE LINE BREAKS AND RADIUS FOR TOWN HIGHWAYS)

WALLINGFORD:
 STA. 4+860.0 - STA. 5+200.0 LT & RT

646.41 DURABLE 100 mm YELLOW LINE (THERMOPLASTIC)
 (ALL LINES WILL INCLUDE C/L BREAKS FOR TOWN HIGHWAYS) S=SOLID, D=DASHED

WALLINGFORD: LT C RT
 STA. 4+860.0 - STA. 4+956.8 D - S
 STA. 4+956.8 - STA. 5+200.0 S - S

646.60 TEMPORARY 100 mm WHITE LINE (PAINT)
 (ALL LINES WILL INCLUDE EDGE LINE BREAKS AND RADIUS FOR TOWN HIGHWAYS)


WALLINGFORD:
 STA. 4+860.0 - STA. 5+200.0 LT & RT

646.61 TEMPORARY 100 mm YELLOW LINE (PAINT)
 (ALL LINES WILL INCLUDE C/L BREAKS FOR TOWN HIGHWAYS) S=SOLID, D=DASHED

WALLINGFORD: LT C RT
 STA. 4+860.0 - STA. 4+956.8 D - S
 STA. 4+956.8 - STA. 5+200.0 S - S

675.50 REMOVING SIGNS

AS SHOWN - 2

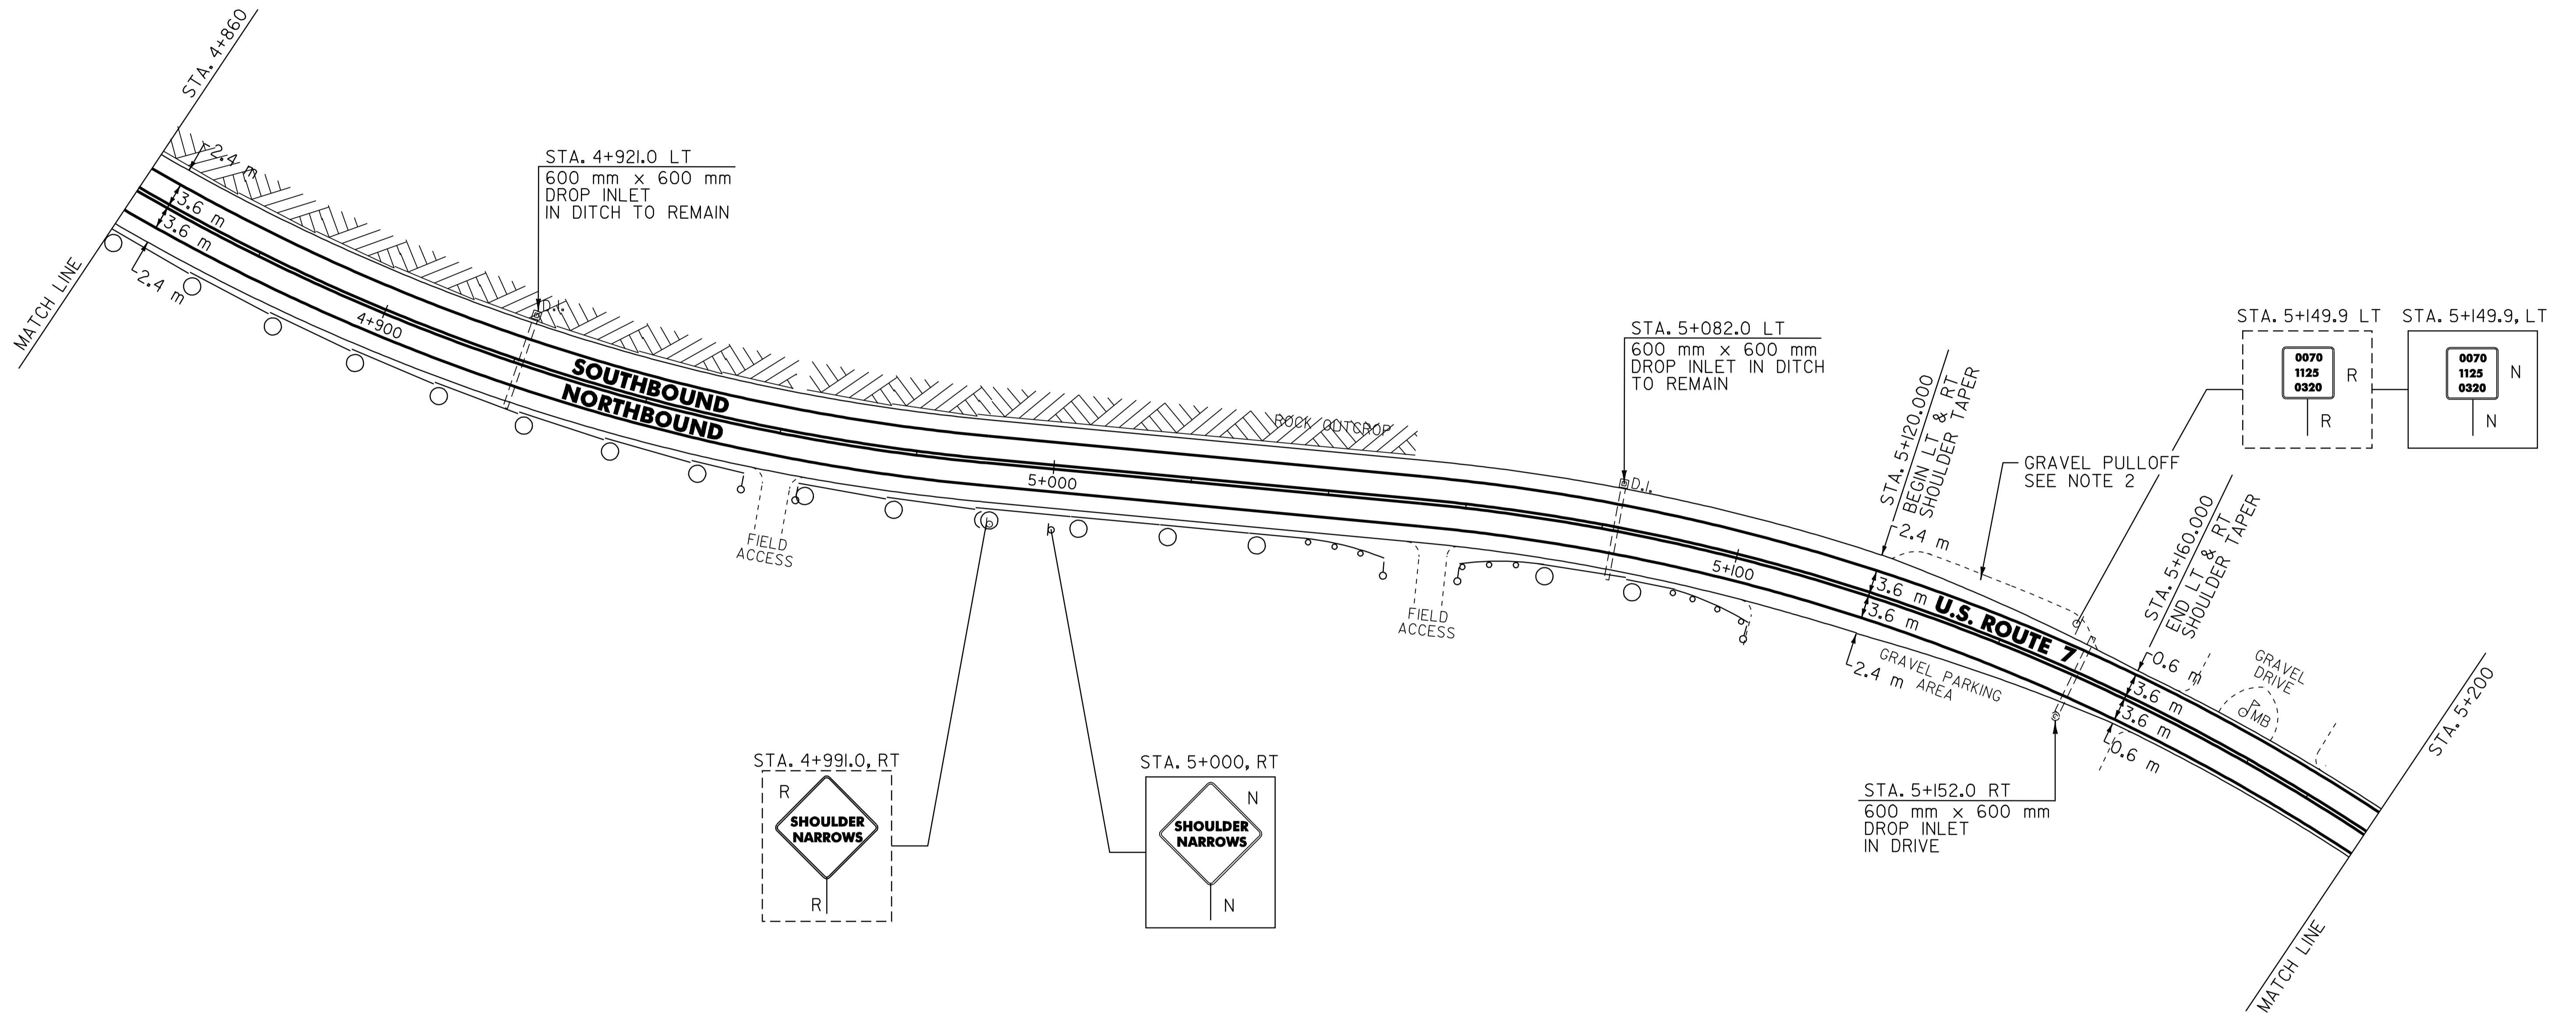

NOTES:

- THE CONTRACTOR SHOULD BE AWARE THAT EXISTING BURIED UTILITIES (SUCH AS PHONE CABLE, FIBER OPTIC CABLE, SEWER LINES, ETC.) ARE LOCATED ADJACENT TO U.S. ROUTE 7 WITHIN THE PROJECT LIMITS. THE CONTRACTOR IS RESPONSIBLE FOR CONTACTING "DIG SAFE" AT 1-888-344-7233 TO DETERMINE THE EXACT LOCATIONS OF THESE UTILITIES PRIOR TO INSTALLING GUARDRAIL, CLEANING DITCHES OR PERFORMING ANY OTHER OPERATIONS THAT MAY DISTURB THE EXISTING SUBSURFACE CONDITIONS.
- PLACE 100 mm OF COMPACTED COLD PLANE GRINDINGS ON THE EXISTING GRAVEL PULLOFF AND PROVIDE A 45 mm TYPE III 1.5 m WIDE APRON. ANY REQUIRED EXCAVATION SHALL BE PERFORMED AS DIRECTED BY THE RESIDENT ENGINEER AND PAID UNDER ITEM 608.25.

604.40 CHANGING ELEVATION OF DI, CB OR MH

WALLINGFORD:
 STA. 5+152.0 RT

621.20 STEEL BEAM GUARDRAIL (GALVANIZED)

WALLINGFORD: 4+952.6 (92.62m)
 STA. 4+860.0 - STA. 4+944.6 RT (84.6 m)
 STA. 4+974.2 - STA. 5+038.8 RT (64.6 m)
 STA. 5+069.6 - STA. 5+092.4 RT (22.8 m)

621.505 MANUFACTURED TERMINAL SECTION (FLARED)

WALLINGFORD: STA. 4+952.6 - STA. 4+964.0 RT
~~STA. 4+944.6 - STA. 4+956.0 RT~~
 STA. 4+962.8 - STA. 4+974.2 RT
 STA. 5+038.8 - STA. 5+050.2 RT
 STA. 5+058.2 - STA. 5+069.6 RT
 STA. 5+092.4 - STA. 5+103.8 RT

621.80 REMOVAL AND DISPOSAL OF GUARDRAIL

WALLINGFORD:
 STA. 4+860.0 - STA. 4+956.0 RT (96.0 m)
 STA. 4+964.0 - STA. 5+049.0 RT (85.0 m)
 STA. 5+058.0 - STA. 5+104.0 RT (46.0 m)

676.10 DELINEATORS WITH STEEL POSTS

WALLINGFORD:
 TYPE 1 WHITE
 STA. 4+956.0 RT
 STA. 4+962.8 RT
 STA. 5+050.2 RT
 STA. 5+058.2 RT
 STA. 5+103.8 RT

SIGN LEGEND

- R= REMOVE
- S= SALVAGE
- N= NEW
- RET= RETAIN
- B-B= BACK TO BACK
- EXISTING= -----
- NEW= _____
- ⊙ = SIGN TO BE RETURNED TO THE TOWN OF WALLINGFORD

PAVING PROJECT LAYOUT # 14

SURVEYED BY	N/A	DATE	N/A
DRAWN BY	C.A.K.	DATE	8/05
SQUAD LEADER	D.E.G.		
DESIGN FILE NO.	/pave/98b098/pb098.dgn		
IPARM FILE	pb098i4.i	DATE PLOTTED	02-JUL-2007 15
PROJ. NAME	WALLINGFORD		
PROJ. NO.	NH_210811S_&_SIP_EH04(6)		
SHEET	34	OF	110 SHEETS

DATUM	
VERTICAL	N/A
HORIZONTAL	N/A