

646.40 DURABLE 100 mm WHITE LINE (THERMOPLASTIC)
 (ALL LINES WILL INCLUDE EDGE LINE BREAKS AND RADIUS FOR TOWN HIGHWAYS)

WALLINGFORD:
 STA. 5+560.0 - STA. 5+940.0 LT & RT

646.41 DURABLE 100 mm YELLOW LINE (THERMOPLASTIC)
 (ALL LINES WILL INCLUDE C/L BREAKS FOR TOWN HIGHWAYS) S=SOLID, D=DASHED

WALLINGFORD:
 STA. 5+560.0 - STA. 5+906.3 LT S C RT S
 STA. 5+906.3 - STA. 5+940.0 S - D
 STA. 5+895.027 DOUBLE SOLID RT, T-34

646.46 DURABLE 600 mm STOP BAR (THERMOPLASTIC)

WALLINGFORD:
 STA. 5+895.027 RT, T-34

646.50 DURABLE LETTER OR SYMBOL (THERMOPLASTIC)

WALLINGFORD:
 STA. 5+895.027 RT, T-34, 'S,T,O,P' (4 EA)

646.60 TEMPORARY 100 mm WHITE LINE (PAINT)
 (ALL LINES WILL INCLUDE EDGE LINE BREAKS AND RADIUS FOR TOWN HIGHWAYS)

WALLINGFORD:
 STA. 5+560.0 - STA. 5+940.0 LT & RT

646.61 TEMPORARY 100 mm YELLOW LINE (PAINT)
 (ALL LINES WILL INCLUDE C/L BREAKS FOR TOWN HIGHWAYS) S=SOLID, D=DASHED

WALLINGFORD:
 STA. 5+560.0 - STA. 5+906.3 LT S C RT S
 STA. 5+906.3 - STA. 5+940.0 S - D
 STA. 5+895.027 DOUBLE SOLID RT, T-34

646.66 TEMPORARY 600 mm STOP BAR (PAINT)

WALLINGFORD:
 STA. 5+895.027 RT, T-34

~~646.70 TEMPORARY LETTER OR SYMBOL (PAINT)~~

WALLINGFORD: NOT USED
~~STA. 5+895.027 RT, T-34, 'S,T,O,P' (4 EA)~~


675.50 REMOVING SIGNS

AS SHOWN - 8

675.60 ERECTING SALVAGED SIGNS

AS SHOWN - 1

MATCH LINE

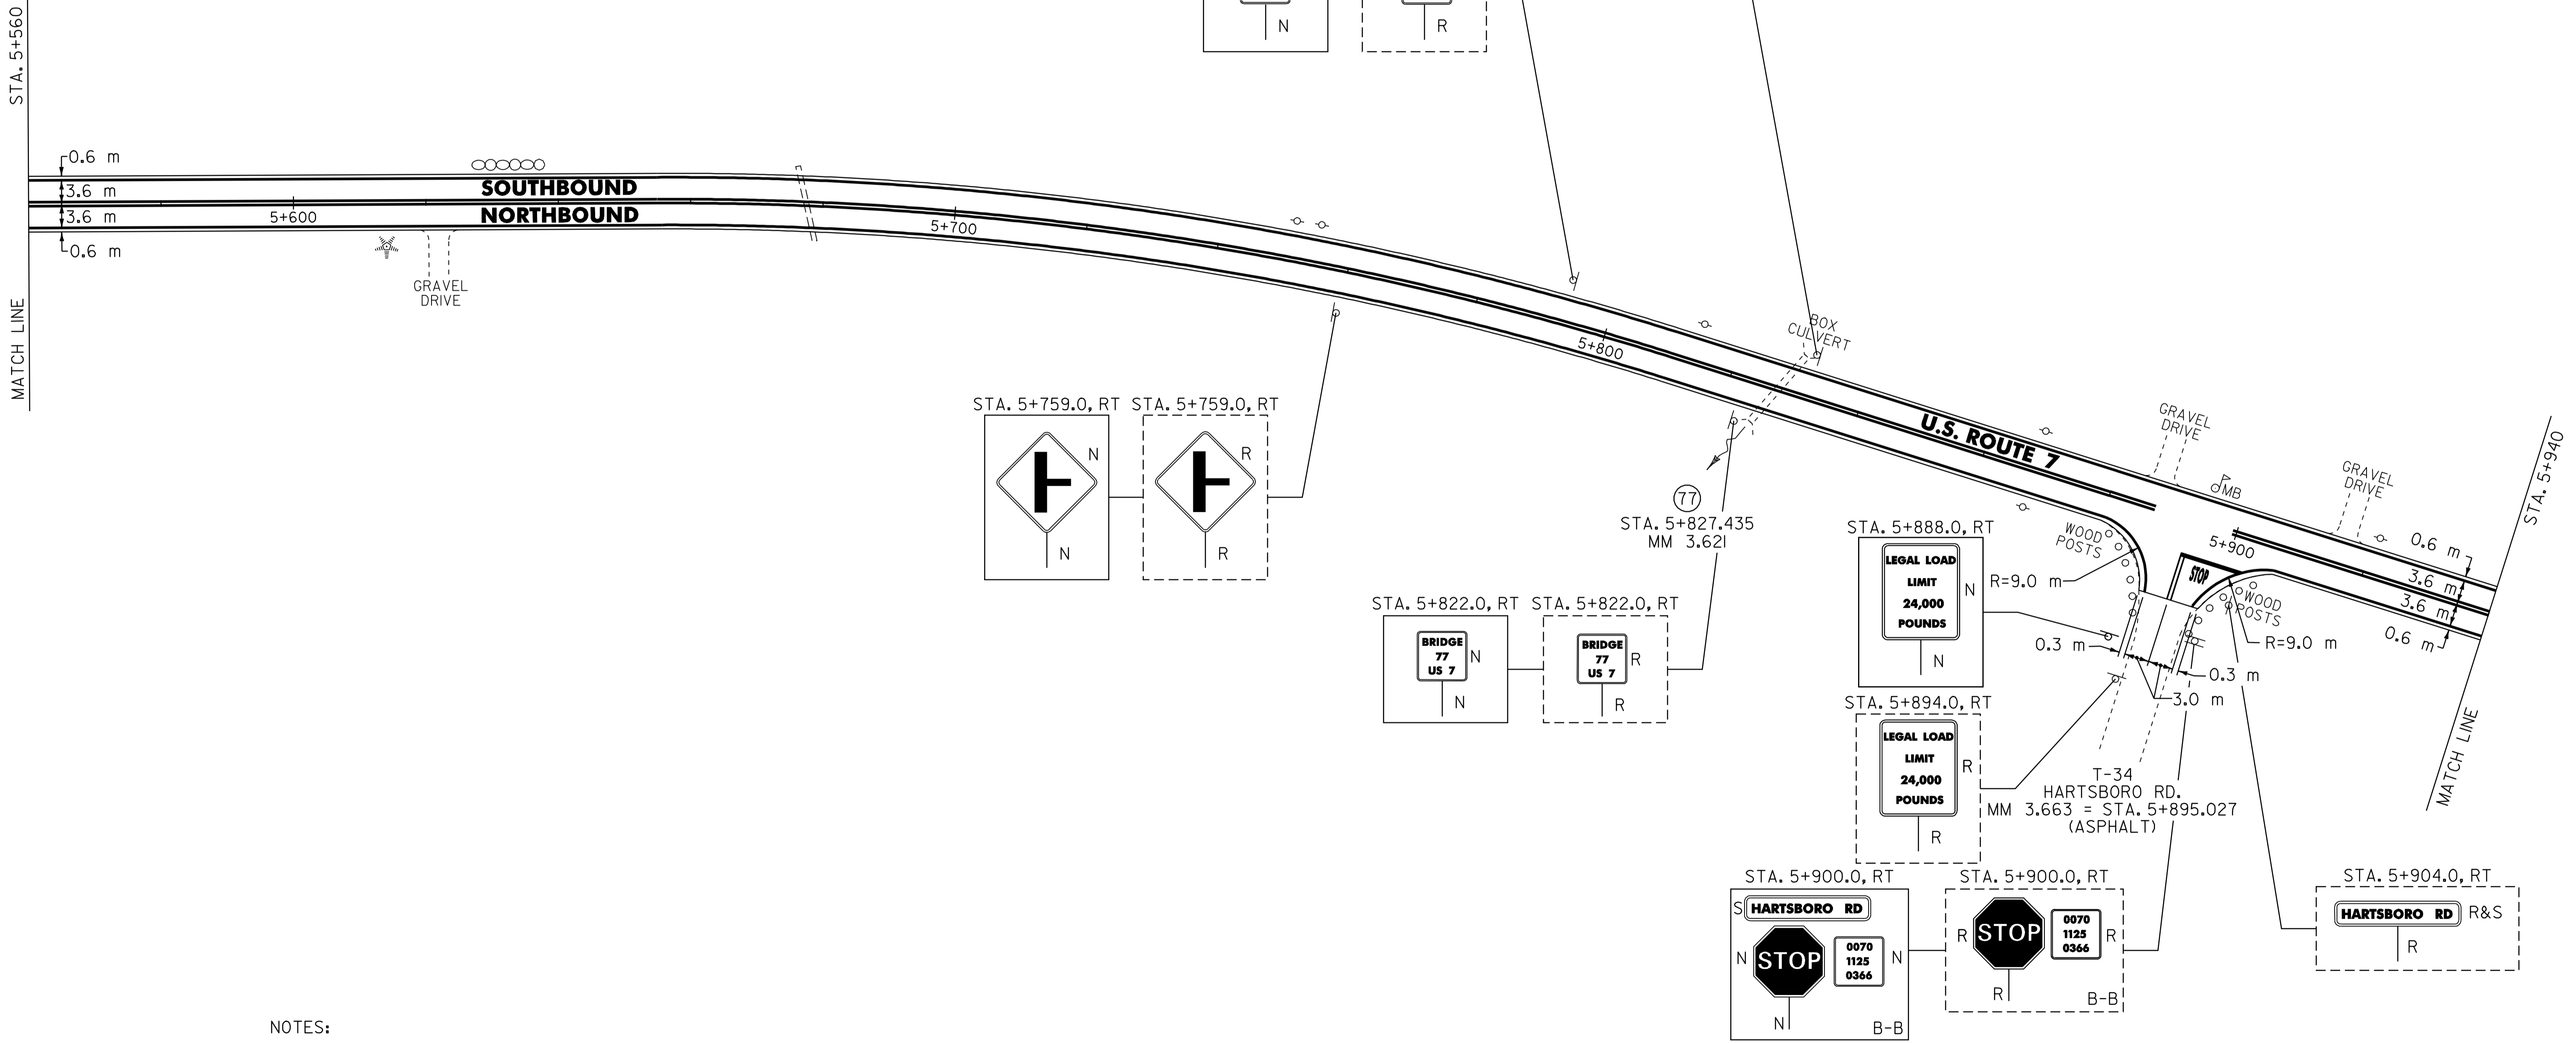

NOTES:

- PAVING LIMIT ON ALL TOWN HIGHWAYS SHALL BE MEASURED 8 m BACK FROM U.S. ROUTE 7 EDGE OF SHOULDER UNLESS DENOTED OTHERWISE ON THE PLANS OR AS DIRECTED BY THE RESIDENT ENGINEER.
- THE CONTRACTOR SHOULD BE AWARE THAT EXISTING BURIED UTILITIES (SUCH AS PHONE CABLE, FIBER OPTIC CABLE, SEWER LINES, ETC.) ARE LOCATED ADJACENT TO U.S. ROUTE 7 WITHIN THE PROJECT LIMITS. THE CONTRACTOR IS RESPONSIBLE FOR CONTACTING "DIG SAFE" AT 1-888-344-7233 TO DETERMINE THE EXACT LOCATIONS OF THESE UTILITIES PRIOR TO INSTALLING GUARDRAIL, CLEANING DITCHES OR PERFORMING ANY OTHER OPERATIONS THAT MAY DISTURB THE EXISTING SUBSURFACE CONDITIONS.

SIGN LEGEND
 R= REMOVE
 S= SALVAGE
 N= NEW
 RET= RETAIN
 B-B= BACK TO BACK
 EXISTING= -----
 NEW= _____
 ⊕ = SIGN TO BE RETURNED TO THE TOWN OF WALLINGFORD

PAVING PROJECT LAYOUT # 16

SURVEYED BY N/A DATE N/A
 DRAWN BY C.A.K. DATE 8/05
 SQUAD LEADER D.E.G.
 DESIGN FILE NO. pave/98b098/pb098.dgn
 IPARM pb098i6.i DATE 02-JUL-2007 15
 FILE PLOTTED
 PROJ. NAME WALLINGFORD
 PROJ. NO. NH_2108(1)S_&_SIP_EH04(6)
 SHEET 36 OF 110 SHEETS

DATUM
 VERTICAL N/A
 HORIZONTAL N/A