

646.40 DURABLE 100 mm WHITE LINE (THERMOPLASTIC)  
 (ALL LINES WILL INCLUDE EDGE LINE BREAKS AND RADIUS FOR TOWN HIGHWAYS)

WALLINGFORD:  
 STA. 6+320.0 - STA. 6+700.0 LT & RT

646.41 DURABLE 100 mm YELLOW LINE (THERMOPLASTIC)  
 (ALL LINES WILL INCLUDE C/L BREAKS FOR TOWN HIGHWAYS) S=SOLID, D=DASHED

WALLINGFORD:  
 STA. 6+320.0 - STA. 6+324.7 LT Q -  
 STA. 6+324.7 - STA. 6+558.1 S -  
 STA. 6+558.1 - STA. 6+700.0 D -


646.60 TEMPORARY 100 mm WHITE LINE (PAINT)  
 (ALL LINES WILL INCLUDE EDGE LINE BREAKS AND RADIUS FOR TOWN HIGHWAYS)

WALLINGFORD:  
 STA. 6+320.0 - STA. 6+700.0 LT & RT

646.61 TEMPORARY 100 mm YELLOW LINE (PAINT)  
 (ALL LINES WILL INCLUDE C/L BREAKS FOR TOWN HIGHWAYS) S=SOLID, D=DASHED

WALLINGFORD:  
 STA. 6+320.0 - STA. 6+324.7 LT Q -  
 STA. 6+324.7 - STA. 6+558.1 S -  
 STA. 6+558.1 - STA. 6+700.0 D -

675.50 REMOVING SIGNS  
 AS SHOWN - 4

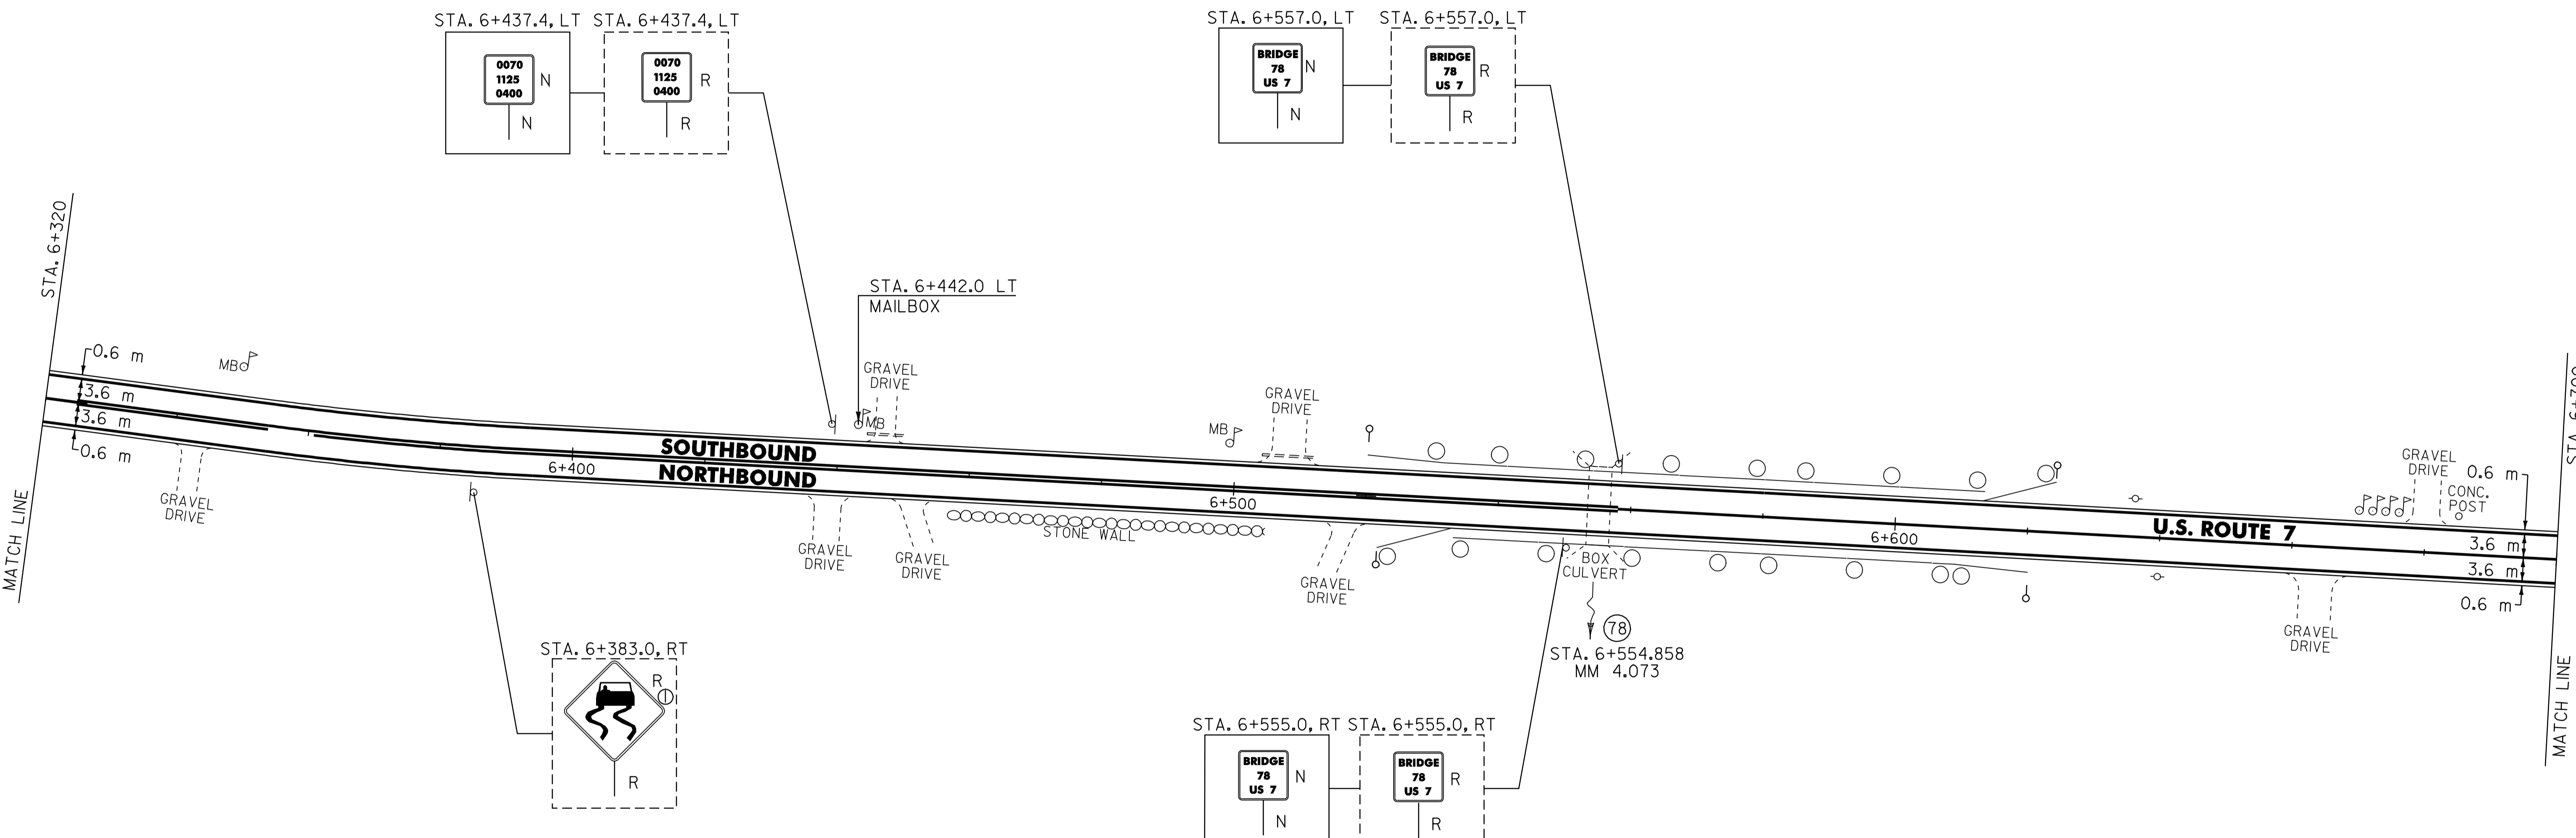

617.10 RELOCATE MAILBOX, SINGLE UNIT

WALLINGFORD:  
 STA. 6+442.0 LT

621.20 STEEL BEAM GUARDRAIL (GALVANIZED)

WALLINGFORD:  
 STA. 6+534.4 - STA. 6+637.0 LT (102.6 m)  
 STA. 6+538.4 - STA. 6+625.8 RT (87.4 m)

621.505 MANUFACTURED TERMINAL SECTION (FLARED)

WALLINGFORD:  
 STA. 6+523.0 - STA. 6+534.4, LT  
 STA. 6+527.0 - STA. 6+538.4, RT  
 STA. 6+625.8 - STA. 6+637.2, RT  
 STA. 6+637.0 - STA. 6+648.4, LT STA. 6+629.7 - STA. 6+641.1 LT

621.80 REMOVAL AND DISPOSAL OF GUARDRAIL

WALLINGFORD:  
 STA. 6+523.0 - STA. 6+638.0 LT (115.0 m)  
 STA. 6+527.0 - STA. 6+634.0 RT (107.0 m)

676.10 DELINEATORS WITH STEEL POSTS

WALLINGFORD:  
 TYPE I WHITE  
 STA. 6+523.0 LT  
 STA. 6+527.0 RT  
 STA. 6+637.2 RT  
 STA. 6+648.4 LT

NOTE:  
 I. THE CONTRACTOR SHOULD BE AWARE THAT EXISTING BURIED UTILITIES (SUCH AS PHONE CABLE, FIBER OPTIC CABLE, SEWER LINES, ETC.) ARE LOCATED ADJACENT TO U.S. ROUTE 7 WITHIN THE PROJECT LIMITS. THE CONTRACTOR IS RESPONSIBLE FOR CONTACTING "DIG SAFE" AT 1-888-344-7233 TO DETERMINE THE EXACT LOCATIONS OF THESE UTILITIES PRIOR TO INSTALLING GUARDRAIL, CLEANING DITCHES OR PERFORMING ANY OTHER OPERATIONS THAT MAY DISTURB THE EXISTING SUBSURFACE CONDITIONS.

SIGN LEGEND  
 R= REMOVE  
 S= SALVAGE  
 N= NEW  
 RET= RETAIN  
 B-B= BACK TO BACK  
 EXISTING= -----  
 NEW= -----  
 ⊕ = SIGN TO BE RETURNED TO THE TOWN OF WALLINGFORD

<b>PAVING PROJECT LAYOUT # 18</b>	SURVEYED BY	N/A	DATE	N/A
	DRAWN BY	C.A.K.	DATE	8/05
	SQUAD LEADER	D.E.G.		
	DESIGN FILE NO.	pave\98b098\pb098.dgn		
	IPARM FILE	pb098i18.1	DATE PLOTTED	02-JUL-2007 15
PROJ. NAME	WALLINGFORD			
PROJ. NO.	NH_2108(1)S_&_SIP_EH04(6)			
SHEET	38	OF	110	SHEETS

DATUM	
VERTICAL	N/A
HORIZONTAL	N/A