

646.40 DURABLE 100 mm WHITE LINE (THERMOPLASTIC)  
 (ALL LINES WILL INCLUDE EDGE LINE BREAKS AND RADIUS FOR TOWN HIGHWAYS)

WALLINGFORD:  
 STA. 6+700.0 - STA. 7+080.0 LT & RT

646.41 DURABLE 100 mm YELLOW LINE (THERMOPLASTIC)  
 (ALL LINES WILL INCLUDE C/L BREAKS FOR TOWN HIGHWAYS) S=SOLID, D=DASHED

WALLINGFORD:	LT	C	RT
STA. 6+700.0 - STA. 6+775.3	-	D	-
STA. 6+775.3 - STA. 6+944.3	D	-	S
STA. 6+944.3 - STA. 7+080.0	S	-	S

646.60 TEMPORARY 100 mm WHITE LINE (PAINT)  
 (ALL LINES WILL INCLUDE EDGE LINE BREAKS AND RADIUS FOR TOWN HIGHWAYS)

WALLINGFORD:  
 STA. 6+700.0 - STA. 7+080.0 LT & RT

646.61 TEMPORARY 100 mm YELLOW LINE (PAINT)  
 (ALL LINES WILL INCLUDE C/L BREAKS FOR TOWN HIGHWAYS) S=SOLID, D=DASHED


WALLINGFORD:	LT	C	RT
STA. 6+700.0 - STA. 6+775.3	-	D	-
STA. 6+775.3 - STA. 6+944.3	D	-	S
STA. 6+944.3 - STA. 7+080.0	S	-	S

675.50 REMOVING SIGNS

AS SHOWN - 8

675.60 ERECTING SALVAGED SIGNS

AS SHOWN - 1

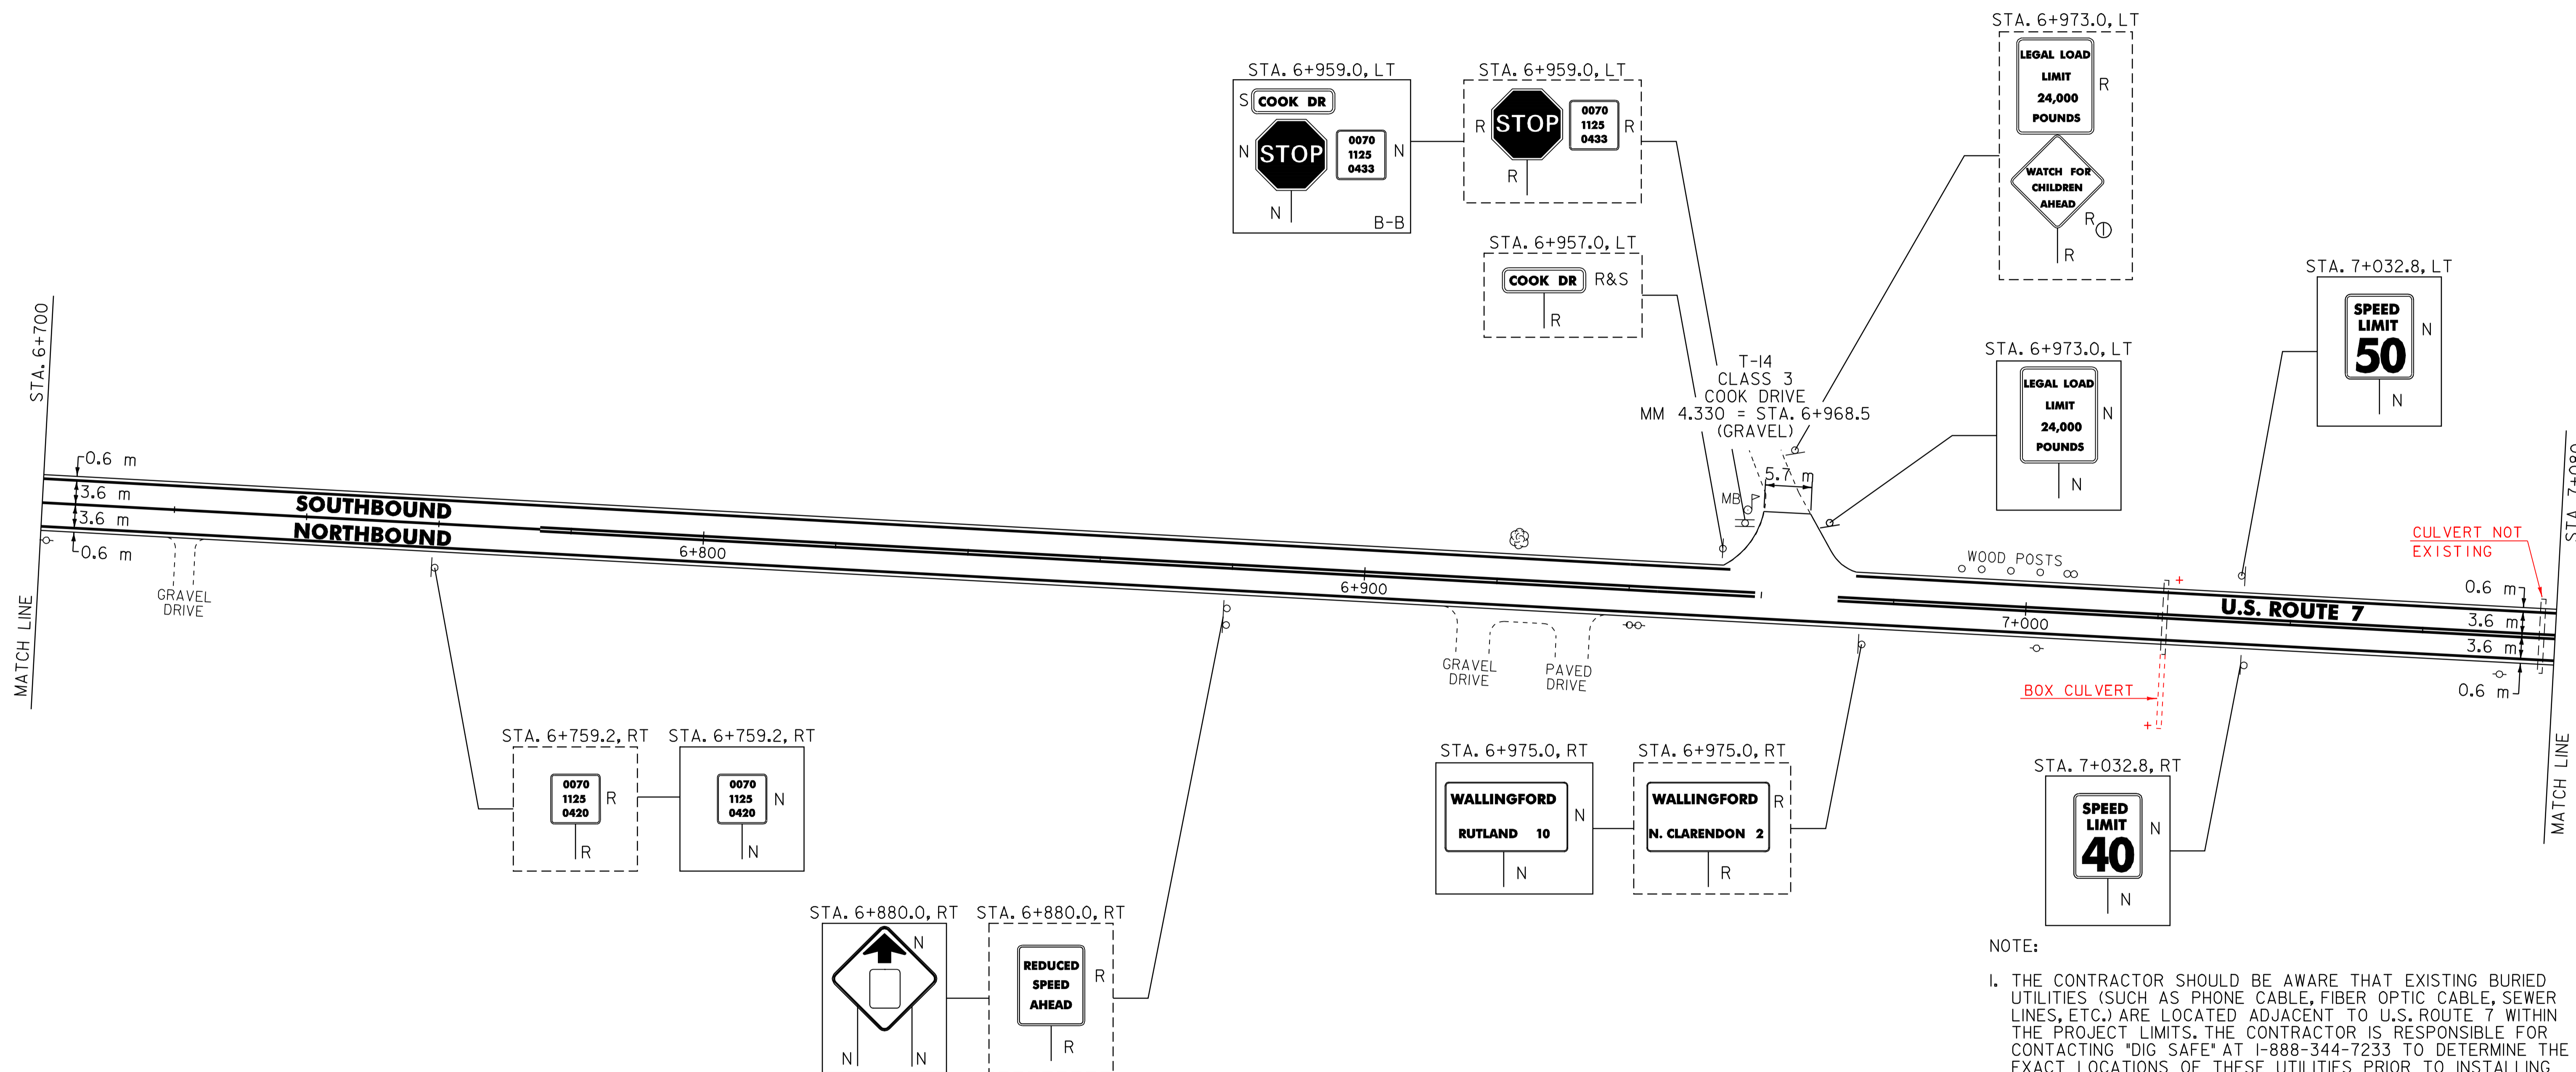

NOTE:

1. THE CONTRACTOR SHOULD BE AWARE THAT EXISTING BURIED UTILITIES (SUCH AS PHONE CABLE, FIBER OPTIC CABLE, SEWER LINES, ETC.) ARE LOCATED ADJACENT TO U.S. ROUTE 7 WITHIN THE PROJECT LIMITS. THE CONTRACTOR IS RESPONSIBLE FOR CONTACTING "DIG SAFE" AT 1-888-344-7233 TO DETERMINE THE EXACT LOCATIONS OF THESE UTILITIES PRIOR TO INSTALLING GUARDRAIL, CLEANING DITCHES OR PERFORMING ANY OTHER OPERATIONS THAT MAY DISTURB THE EXISTING SUBSURFACE CONDITIONS.

**SIGN LEGEND**  
 R= REMOVE  
 S= SALVAGE  
 N= NEW  
 RET= RETAIN  
 B-B= BACK TO BACK  
 EXISTING= \_\_\_\_\_  
 NEW= \_\_\_\_\_  
 ⊙ = SIGN TO BE RETURNED TO THE TOWN OF WALLINGFORD

**PAVING PROJECT LAYOUT # 19**

SURVEYED BY	N/A	DATE	N/A
DRAWN BY	C.A.K.	DATE	8/05
SQUAD LEADER	D.E.G.		
DESIGN FILE NO.	/pave/98b098/pb098.dgn		
IPARM FILE	pb098i19.i	DATE PLOTTED	02-JUL-2007 15
PROJ. NAME	WALLINGFORD		
PROJ. NO.	NH 2108(I)S & STP EHO4(6)		
SHEET	39 OF 110	SHEETS	

DATUM  
 VERTICAL N/A  
 HORIZONTAL N/A