

646.40 DURABLE 100 mm WHITE LINE (THERMOPLASTIC)
 (ALL LINES WILL INCLUDE EDGE LINE BREAKS AND RADIUS FOR TOWN HIGHWAYS)

WALLINGFORD:
 STA. 7+840.0 - STA. 8+020.0 LT & RT

646.41 DURABLE 100 mm YELLOW LINE (THERMOPLASTIC)
 (ALL LINES WILL INCLUDE C/L BREAKS FOR TOWN HIGHWAYS) S=SOLID, D=DASHED

WALLINGFORD:
 STA. 7+840.0 - STA. 8+020.0 LT S C RT S
 STA. 7+853.599 DOUBLE SOLID RT, T-68

646.46 DURABLE 600 mm STOP BAR (THERMOPLASTIC)

WALLINGFORD:
 STA. 7+853.599 RT, T-68

646.50 DURABLE LETTER OR SYMBOL (THERMOPLASTIC)

WALLINGFORD:
 STA. 7+853.599 RT, T-68, "S,T,O,P" (4 EA)

646.60 TEMPORARY 100 mm WHITE LINE (PAINT)
 (ALL LINES WILL INCLUDE EDGE LINE BREAKS AND RADIUS FOR TOWN HIGHWAYS)

WALLINGFORD:
 STA. 7+840.0 - STA. 8+020.0 LT & RT

646.61 TEMPORARY 100 mm YELLOW LINE (PAINT)
 (ALL LINES WILL INCLUDE C/L BREAKS FOR TOWN HIGHWAYS) S=SOLID, D=DASHED

WALLINGFORD:
 STA. 7+840.0 - STA. 8+020.0 LT S C RT S
 STA. 7+853.599 DOUBLE SOLID RT, T-68

646.66 TEMPORARY 600 mm STOP BAR (PAINT)

WALLINGFORD:
 STA. 7+853.599 RT, T-68

~~646.70 TEMPORARY LETTER OR SYMBOL (PAINT)~~


~~WALLINGFORD:
 STA. 7+853.599 RT, T-68, "S,T,O,P" (8 EA)~~

675.50 REMOVING SIGNS

AS SHOWN - 7

675.60 ERECTING SALVAGED SIGNS

AS SHOWN - 1

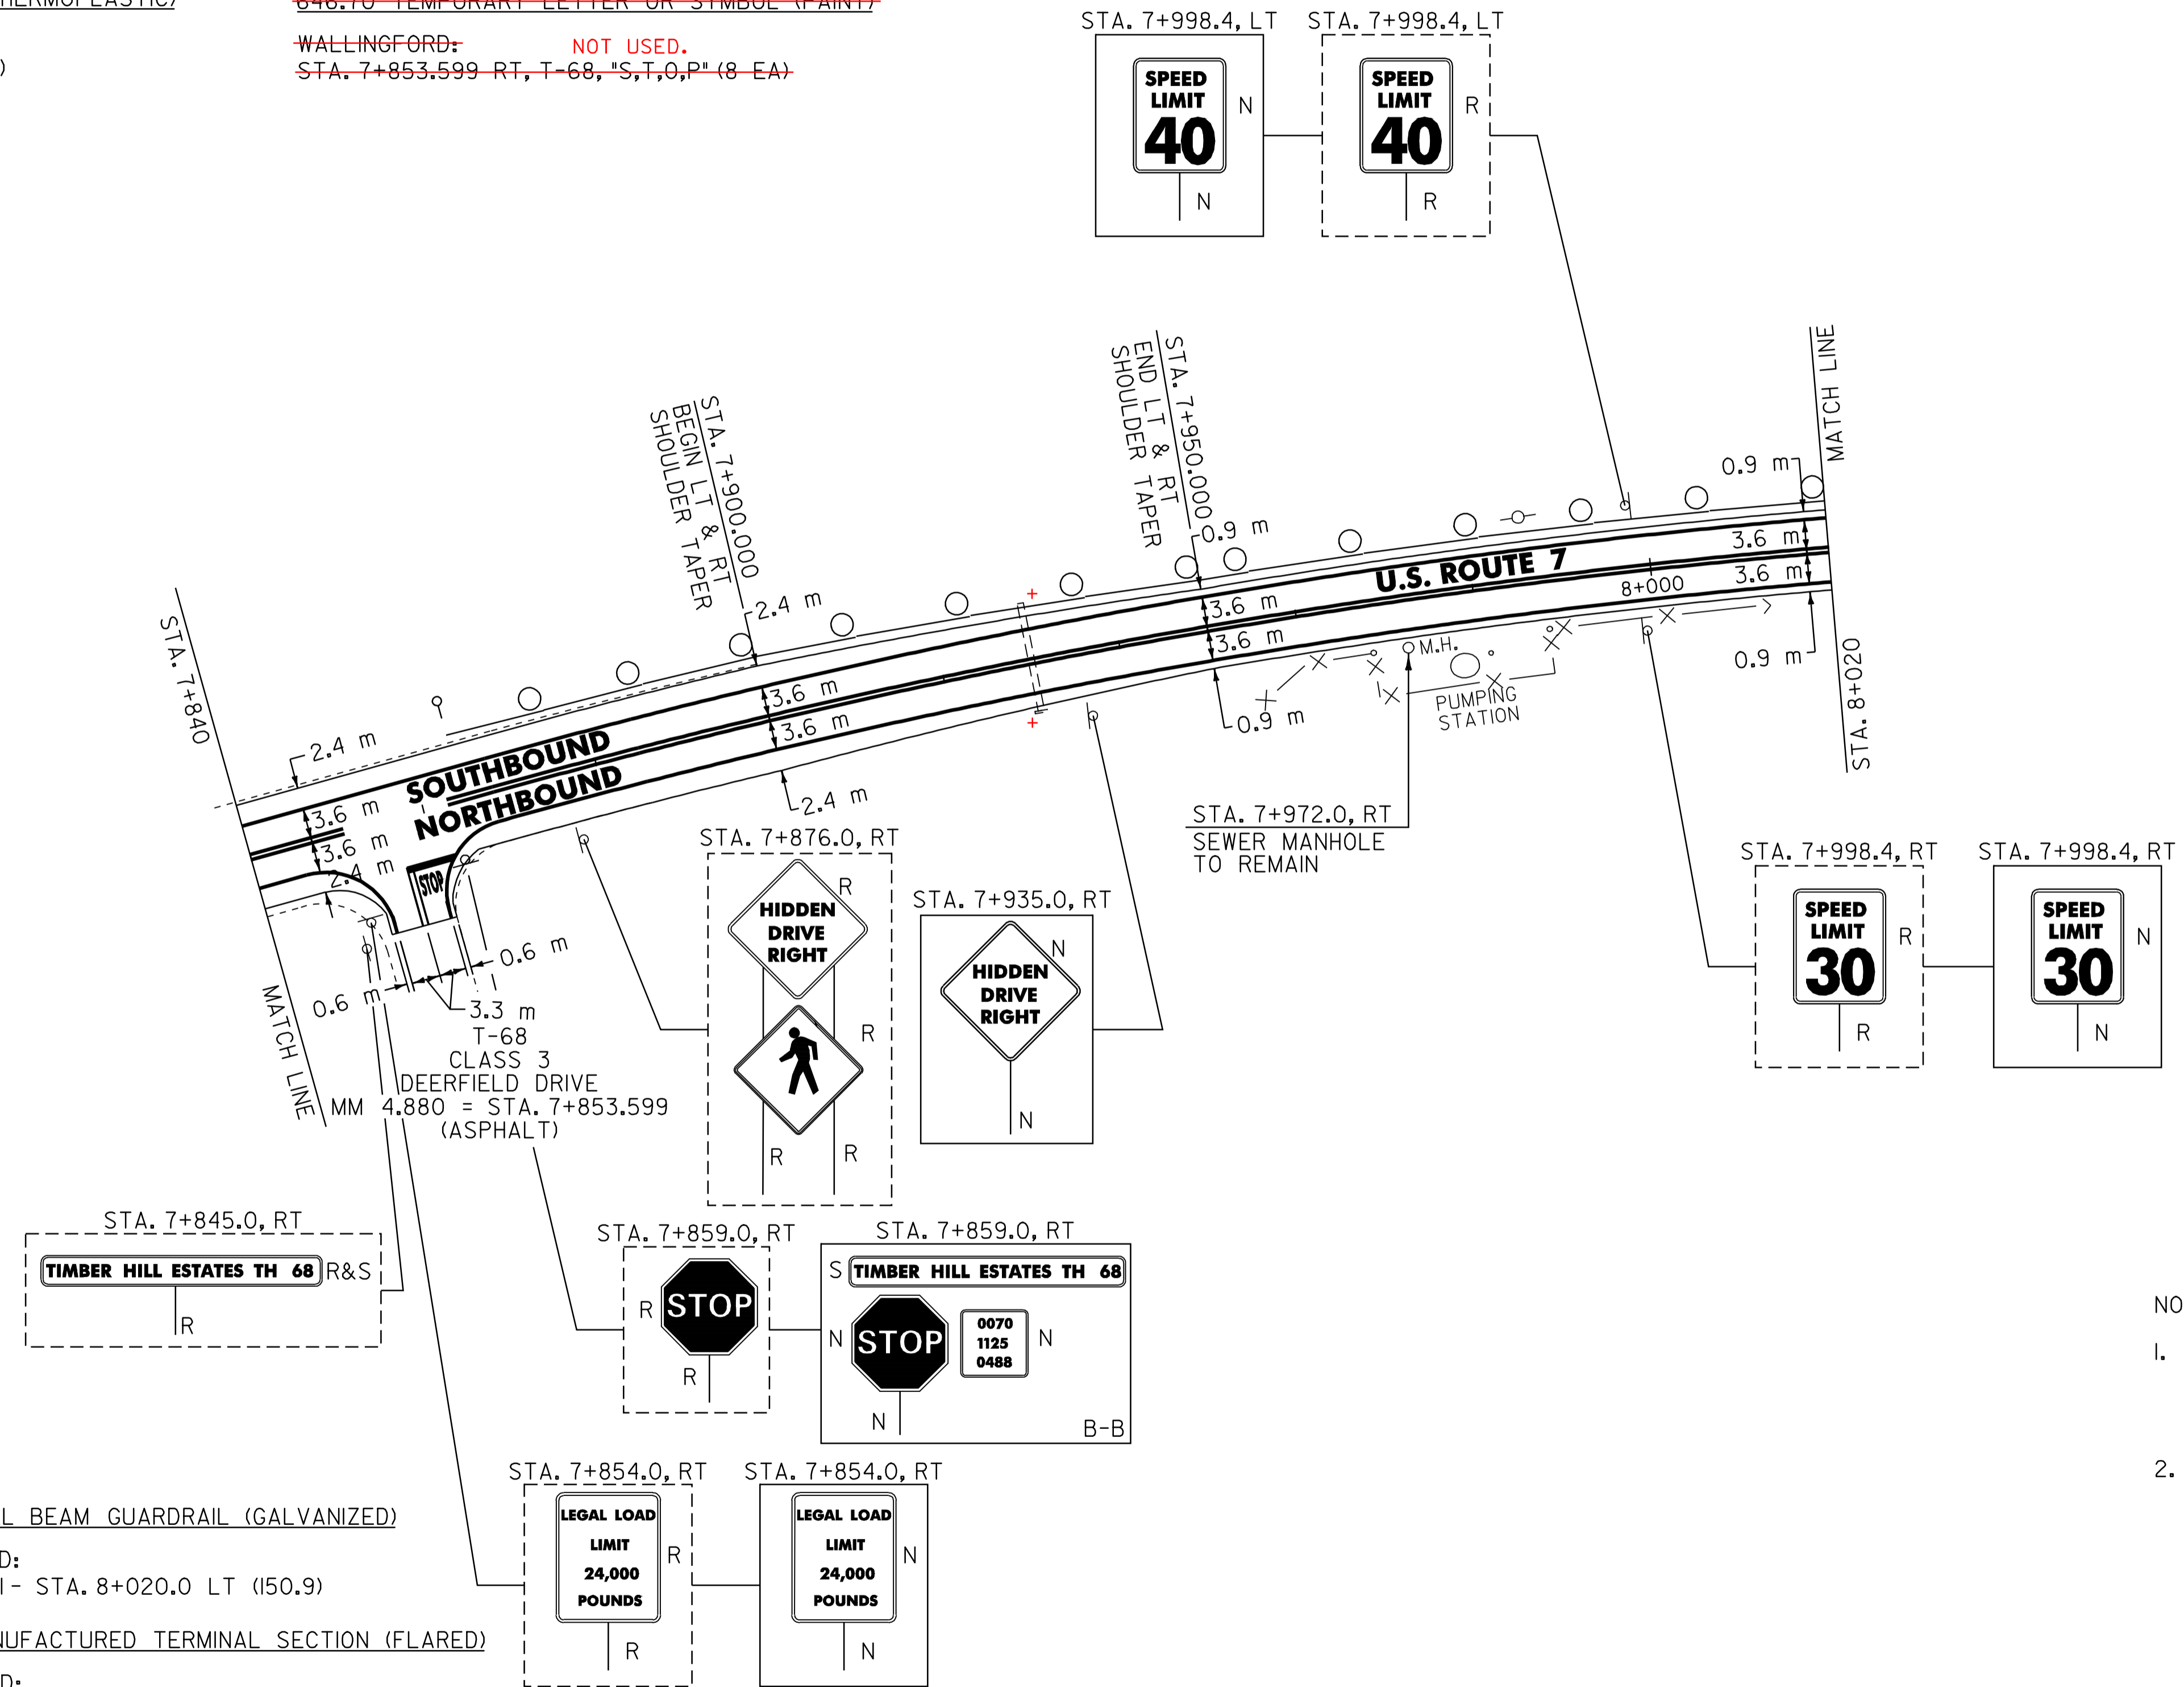

621.20 STEEL BEAM GUARDRAIL (GALVANIZED)

WALLINGFORD:
 STA. 7+869.1 - STA. 8+020.0 LT (150.9)

621.505 MANUFACTURED TERMINAL SECTION (FLARED)

WALLINGFORD:
 STA. 7+857.7 - STA. 7+869.1, LT

621.80 REMOVAL AND DISPOSAL OF GUARDRAIL

WALLINGFORD:
 STA. 7+859.0 - STA. 8+020.0 LT (161.0 m)

676.10 DELINEATORS WITH STEEL POSTS

WALLINGFORD:
 TYPE I WHITE
 STA. 7+857.7 LT

NOTES:

- PAVING LIMIT ON ALL TOWN HIGHWAYS SHALL BE MEASURED 8 m BACK FROM U.S. ROUTE 7 EDGE OF SHOULDER UNLESS DENOTED OTHERWISE ON THE PLANS OR AS DIRECTED BY THE RESIDENT ENGINEER.
- THE CONTRACTOR SHOULD BE AWARE THAT EXISTING BURIED UTILITIES (SUCH AS PHONE CABLE, FIBER OPTIC CABLE, SEWER LINES, ETC.) ARE LOCATED ADJACENT TO U.S. ROUTE 7 WITHIN THE PROJECT LIMITS. THE CONTRACTOR IS RESPONSIBLE FOR CONTACTING "DIG SAFE" AT 1-888-344-7233 TO DETERMINE THE EXACT LOCATIONS OF THESE UTILITIES PRIOR TO INSTALLING GUARDRAIL, CLEANING DITCHES OR PERFORMING ANY OTHER OPERATIONS THAT MAY DISTURB THE EXISTING SUBSURFACE CONDITIONS.

SIGN LEGEND
 R= REMOVE
 S= SALVAGE
 N= NEW
 RET= RETAIN
 B-B= BACK TO BACK
 EXISTING= -----
 NEW= _____
 ⊕ = SIGN TO BE RETURNED TO THE TOWN OF WALLINGFORD

PAVING PROJECT LAYOUT # 22

SURVEYED BY	N/A	DATE	N/A
DRAWN BY	C.A.K.	DATE	8/05
SQUAD LEADER	D.E.G.		
DESIGN FILE NO.	/pave/98b098/pb098.dgn		
IPARM FILE	pb098i2.1	DATE PLOTTED	02-JUL-2007 15
PROJ. NAME	WALLINGFORD		
PROJ. NO.	NH_2108(1)S_&_SIP_EHQ4(6)		
SHEET	42	OF	110
SHEETS	_____		

DATUM	
VERTICAL	N/A
HORIZONTAL	N/A