

646.40 DURABLE 100 mm WHITE LINE (THERMOPLASTIC)
 (ALL LINES WILL INCLUDE EDGE LINE BREAKS AND RADIUS FOR TOWN HIGHWAYS)
 WALLINGFORD:
 STA. 9+100.0 - STA. 9+200.0 LT & RT
 646.41 DURABLE 100 mm YELLOW LINE (THERMOPLASTIC)
 (ALL LINES WILL INCLUDE C/L BREAKS FOR TOWN HIGHWAYS) S=SOLID, D=DASHED
 WALLINGFORD:
 STA. 9+100.0 - STA. 9+200.0 LT S C RT S
 STA. 9+171.651 DOUBLE SOLID LT, T-64



646.42 DURABLE 200 mm WHITE LINE (THERMOPLASTIC)
 WALLINGFORD:
 STA. 9+160.1 - STA. 9+163.9 LT, SHOULDER HATCHING (12.9 m)
 STA. 9+185.0 - STA. 9+200.0 RT, SHOULDER HATCHING (13.6 m)
 646.46 DURABLE 600 mm STOP BAR (THERMOPLASTIC)

WALLINGFORD:
 STA. 9+171.651 LT, T-64
 656.35 DECIDUOUS SHRUB (LIGUSTRUM AMURENSE)
 WALLINGFORD:
 STA. 9+125.0 - STA. 9+128.0, LT (9 EA)
 2 @ STA. 9+138 LT

646.60 TEMPORARY 100 mm WHITE LINE (PAINT)
 (ALL LINES WILL INCLUDE EDGE LINE BREAKS AND RADIUS FOR TOWN HIGHWAYS)
 WALLINGFORD:
 STA. 9+100.0 - STA. 9+200.0 LT & RT
 646.61 TEMPORARY 100 mm YELLOW LINE (PAINT)
 (ALL LINES WILL INCLUDE C/L BREAKS FOR TOWN HIGHWAYS) S=SOLID, D=DASHED
 WALLINGFORD:
 STA. 9+100.0 - STA. 9+200.0 LT S C RT S
 STA. 9+171.651 DOUBLE SOLID LT, T-64
 646.66 TEMPORARY 600 mm STOP BAR (PAINT)
 WALLINGFORD:
 STA. 9+171.651 LT, T-64



646.50 DURABLE LETTER OR SYMBOL (THERMOPLASTIC)
 WALLINGFORD:
 STA. 9+171.651 LT, T-64 "S,T,O,P" (4 EA)
 646.70 TEMPORARY LETTER OR SYMBOL (PAINT)
 WALLINGFORD: **NOT USED**
 STA. 9+171.651 LT, T-64 "S,T,O,P" (8 EA)

646.51 DURABLE CROSSWALK MARKINGS W/DIAGONALS (MOD.) (THERMOPLASTIC)
 WALLINGFORD:
 STA. 9+171.651 LT, T-64
 646.71 TEMPORARY CROSSWALK MARKINGS W/DIAGONALS (MOD.) (PAINT)
 WALLINGFORD: **NOT USED**
 STA. 9+171.651 LT, T-64
 675.50 REMOVING SIGNS
 AS SHOWN - 14
 675.60 ERECTING SALVAGED SIGNS
 AS SHOWN - 2

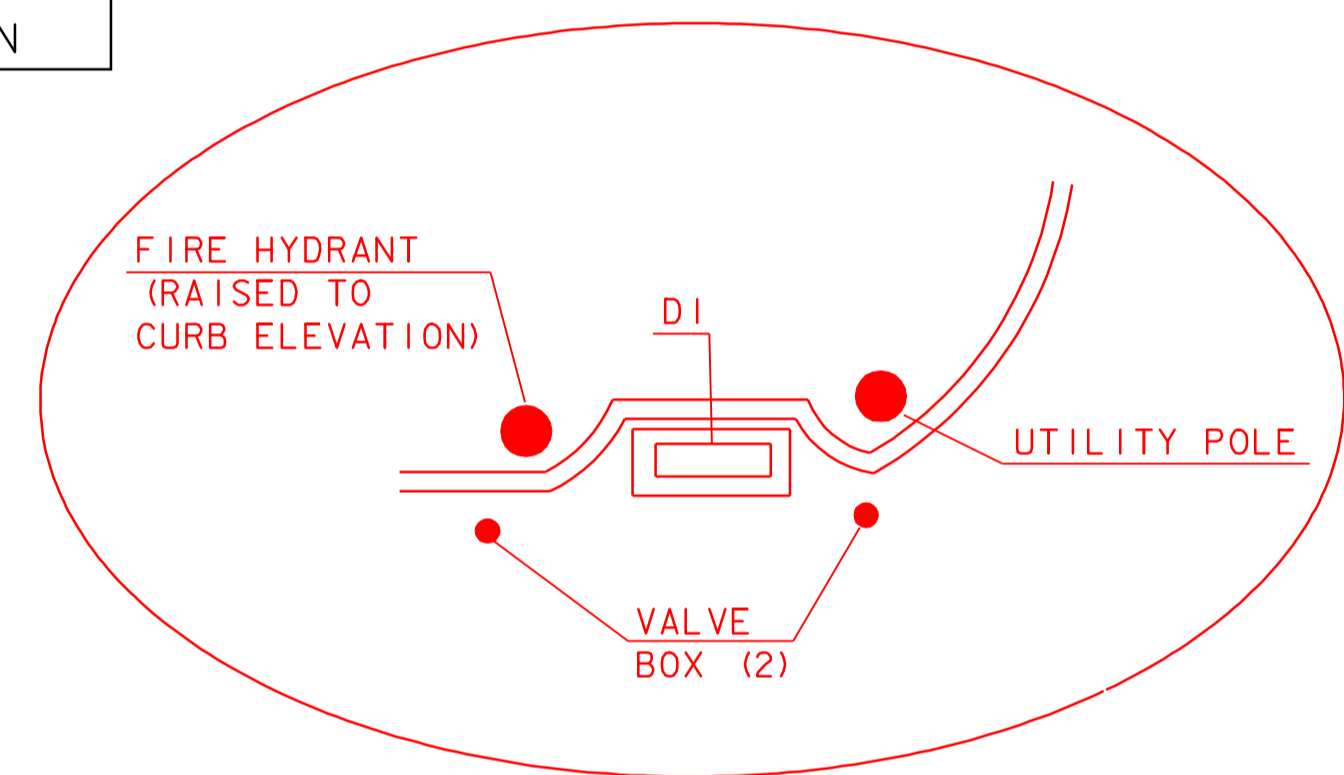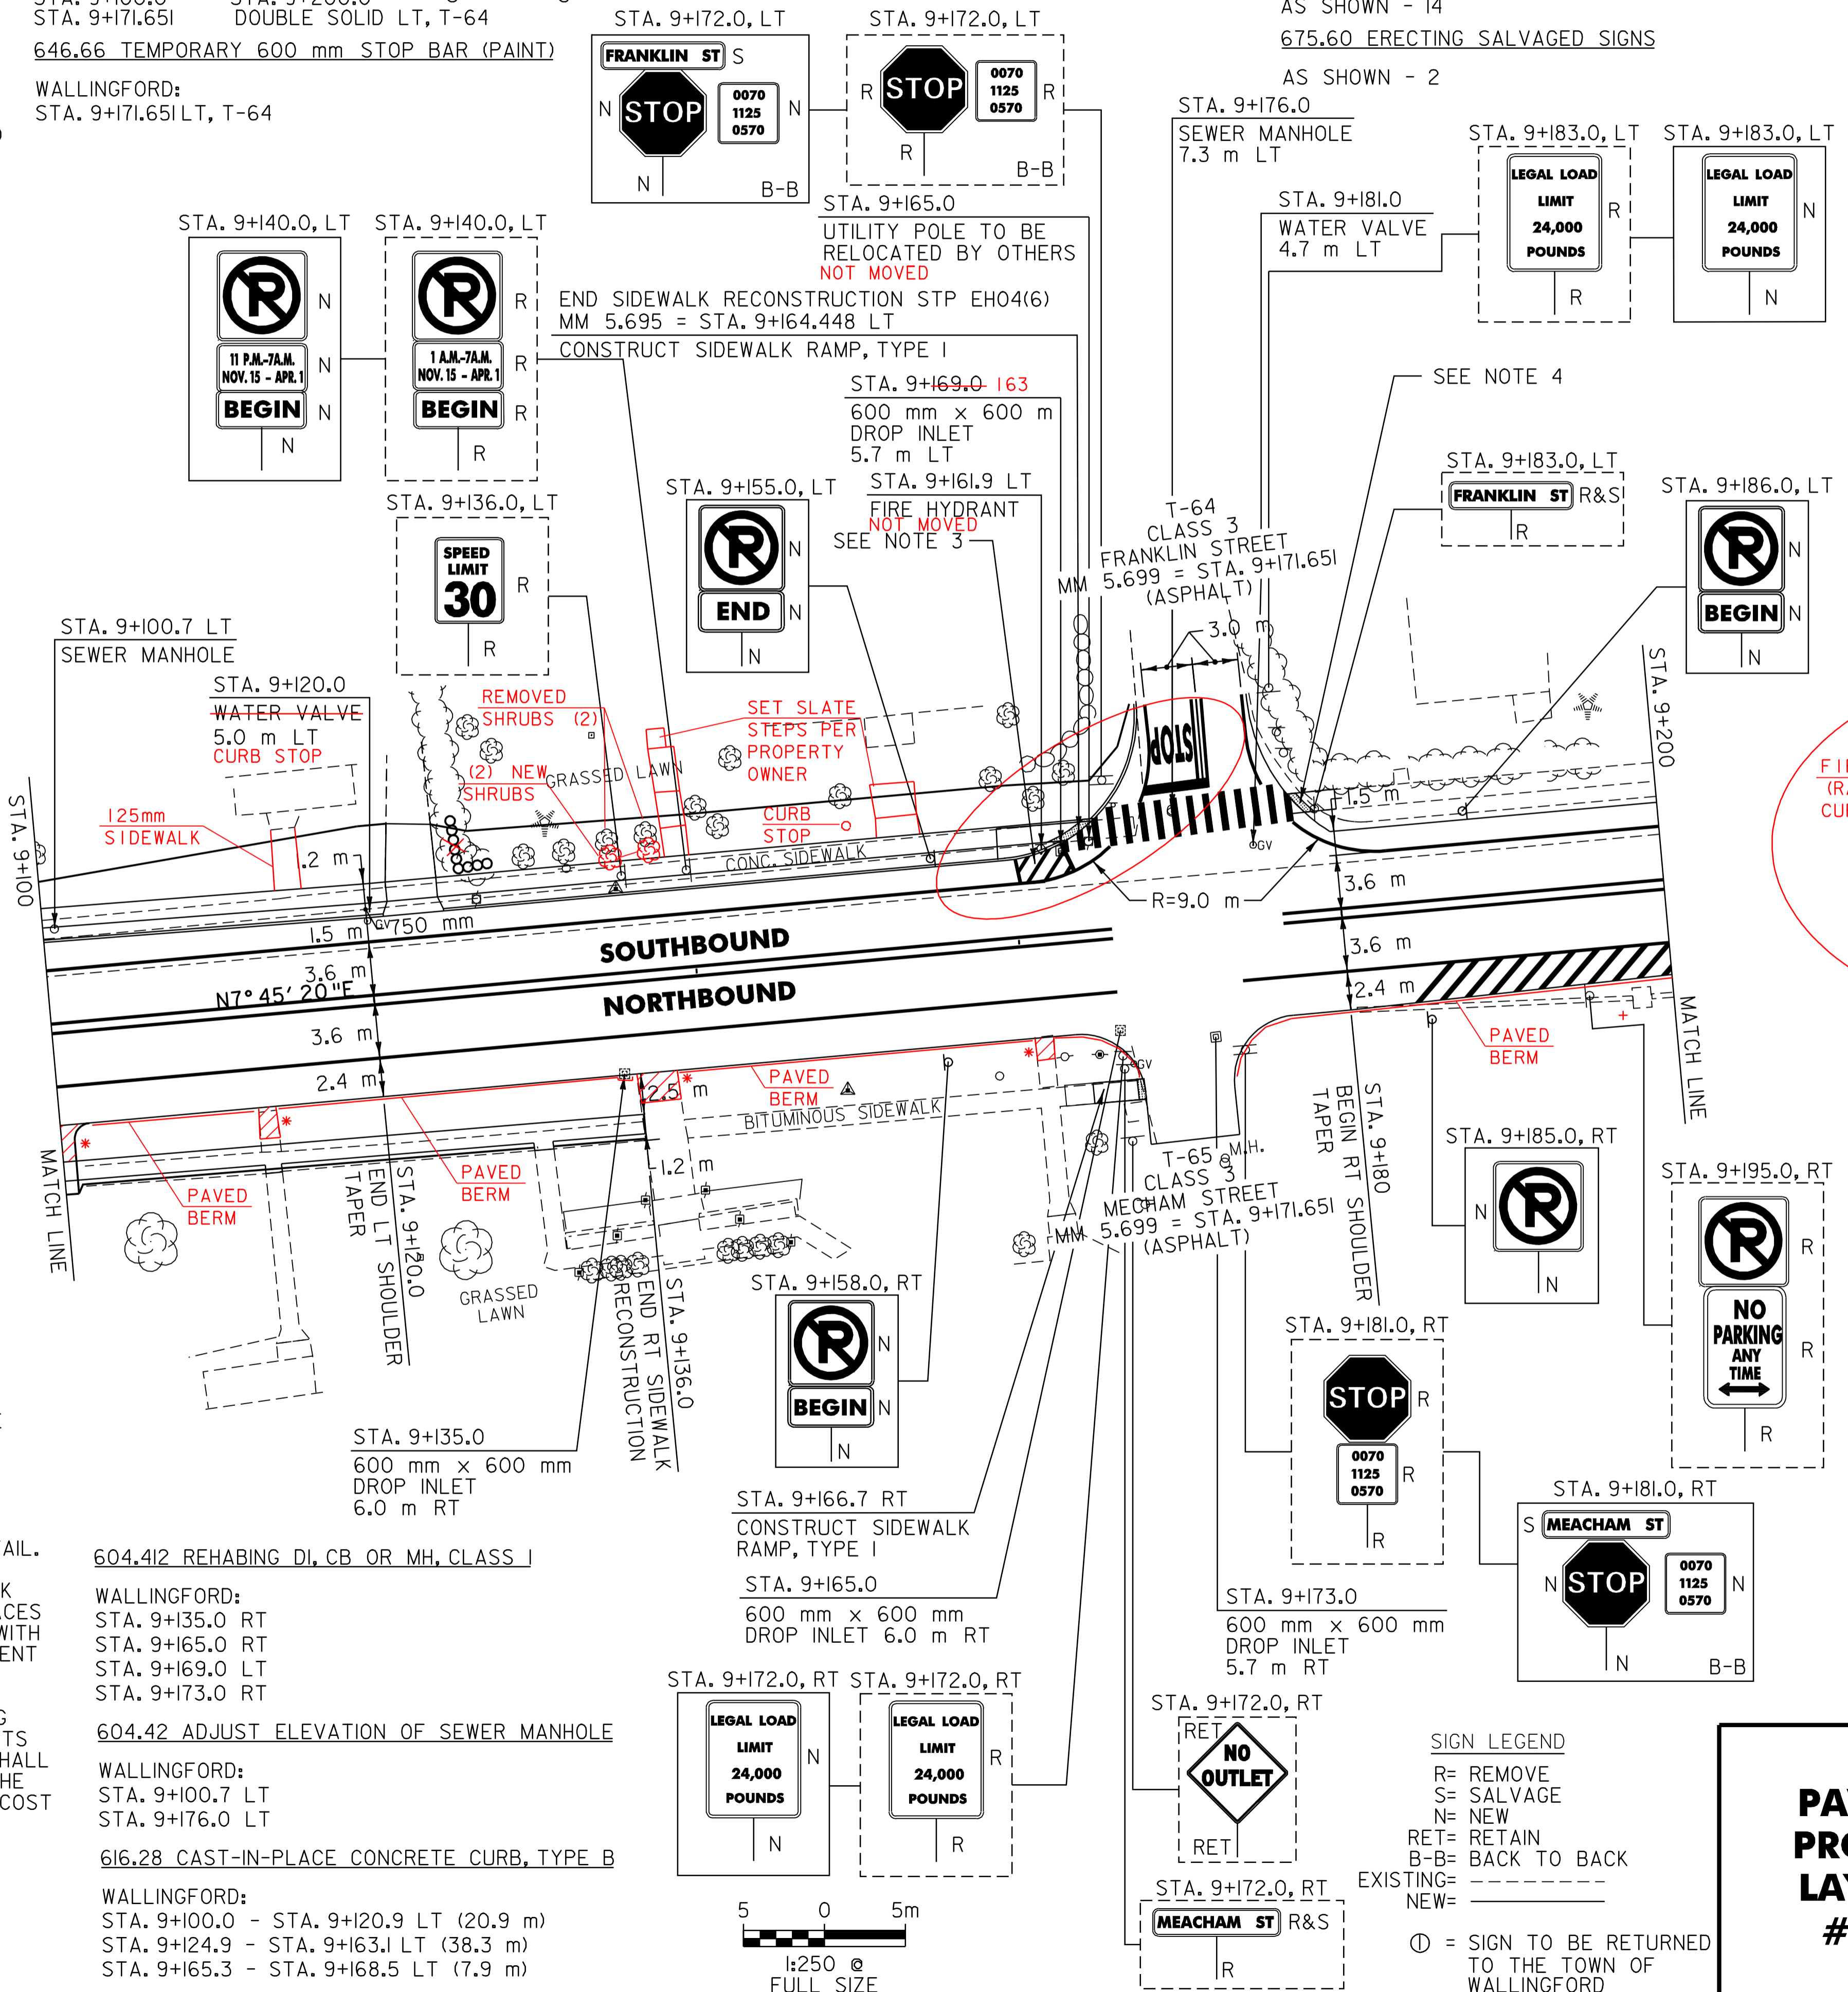

- NOTES:
- PAVING LIMIT ON ALL TOWN HIGHWAYS SHALL BE MEASURED 8 m BACK FROM U.S. ROUTE 7 EDGE OF SHOULDER UNLESS DENOTED OTHERWISE ON THE PLANS OR AS DIRECTED BY THE RESIDENT ENGINEER.
 - THE CONTRACTOR SHOULD BE AWARE THAT EXISTING BURIED UTILITIES (SUCH AS PHONE CABLE, FIBER OPTIC CABLE, SEWER LINES, ETC.) ARE LOCATED ADJACENT TO U.S. ROUTE 7 WITHIN THE PROJECT LIMITS. THE CONTRACTOR IS RESPONSIBLE FOR CONTACTING "DIG SAFE" AT 1-888-344-7233 TO DETERMINE THE EXACT LOCATIONS OF THESE UTILITIES PRIOR TO INSTALLING GUARDRAIL, CLEANING DITCHES OR PERFORMING ANY OTHER OPERATIONS THAT MAY DISTURB THE EXISTING SUBSURFACE CONDITIONS.
 - SEE SHEET 86 OF 110 FOR HYDRANT PAVEMENT MARKING DETAIL.
 - THE CONTRACTOR SHALL RECONSTRUCT THE EXISTING SIDEWALK RAMP BY REMOVING THE EXISTING EXPOSED AGGREGATE SURFACES AND INSTALL A NEW PORTLAND CEMENT CONCRETE SURFACE WITH A DETECTABLE WARNING SURFACE AS DIRECTED BY THE RESIDENT ENGINEER.
 - THE CONTRACTOR SHALL PROTECT AND MAINTAIN ALL EXISTING LANDSCAPING AND FENCING LOCATED WITHIN THE PROJECT LIMITS AS DIRECTED BY THE RESIDENT ENGINEER. THE CONTRACTOR SHALL REPAIR OR REPLACE ANY DAMAGED ITEMS LOCATED BEYOND THE EARTHWORK LIMITS DEPICTED IN THE PLANS AT HIS/HER OWN COST AS DIRECTED BY THE RESIDENT ENGINEER.

604.412 REHABING DI, CB OR MH, CLASS 1
 WALLINGFORD:
 STA. 9+135.0 RT
 STA. 9+165.0 RT
 STA. 9+169.0 LT
 STA. 9+173.0 RT
 604.42 ADJUST ELEVATION OF SEWER MANHOLE
 WALLINGFORD:
 STA. 9+100.7 LT
 STA. 9+176.0 LT
 616.28 CAST-IN-PLACE CONCRETE CURB, TYPE B
 WALLINGFORD:
 STA. 9+100.0 - STA. 9+120.9 LT (20.9 m)
 STA. 9+124.9 - STA. 9+163.1 LT (38.3 m)
 STA. 9+165.3 - STA. 9+168.5 LT (7.9 m)

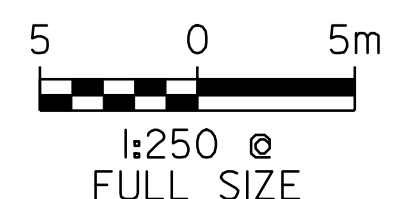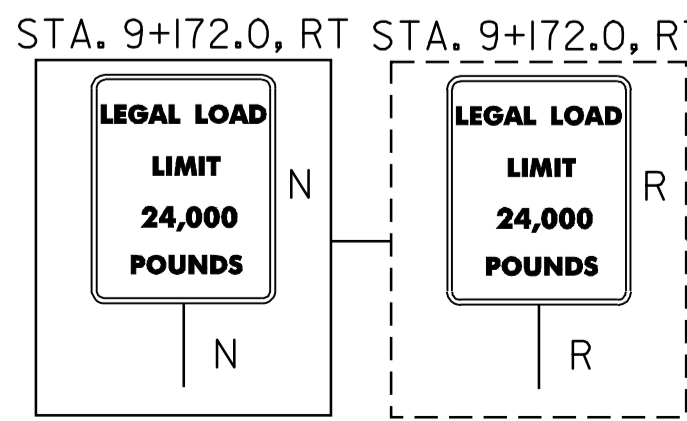

- SIGN LEGEND
 R= REMOVE
 S= SALVAGE
 N= NEW
 RET= RETAIN
 B-B= BACK TO BACK
 EXISTING= ---
 NEW= ---
 ⊙ = SIGN TO BE RETURNED TO THE TOWN OF WALLINGFORD

PAVING PROJECT LAYOUT # 29

- 618.10 PORTLAND CEMENT CONCRETE SIDEWALK, 125 mm
 WALLINGFORD:
 STA. 9+100.0 - STA. 9+164.448 LT (77.4 m²)
 STA. 9+100.0 - STA. 9+136.0 RT (43.8 m²)
 STA. 9+163.2 - STA. 9+166.7 RT (4.2 m²)
 618.30 DETECTABLE WARNING SURFACE
 WALLINGFORD:
 STA. 9+164.4 LT (0.72 m²)
 STA. 9+166.7 RT (0.72 m²)
 STA. 9+179.0 LT (0.72 m²)
 629.20 ADJUST ELEVATION OF VALVE BOX
 WALLINGFORD:
 STA. 9+120.0 LT
 STA. 9+181.0 LT
 629.29 RELOCATE HYDRANT
 WALLINGFORD:
 STA. 9+161.9 LT
 CONSTRUCT DRIVEWAY
 WALLINGFORD:
 STA. 9+122.908 LT

DATUM

VERTICAL	NAVD 88
HORIZONTAL	NAD 83 (1996)

SURVEYED BY	L.R.S.C.	DATE	N/A
DRAWN BY	C.A.K.	DATE	8/05
SQUAD LEADER	D.E.G.		
DESIGN FILE NO.	/pave/98b098/pb098.dgn		
IPARM FILE	pb098i29.1	DATE PLOTTED	08-JUL-2007 15:00
PROJ. NAME	WALLINGFORD		
PROJ. NO.	NH 2108(I)S & STP EHO4(6)		
SHEET	49 OF 110	SHEETS	