

646.40 DURABLE 100 mm WHITE LINE (THERMOPLASTIC)
 (ALL LINES WILL INCLUDE EDGE LINE BREAKS AND RADIUS FOR TOWN HIGHWAYS)
 WALLINGFORD:
 STA. 9+200.0 - STA. 9+320.0 LT & RT

646.60 TEMPORARY 100 mm WHITE LINE (PAINT)
 (ALL LINES WILL INCLUDE EDGE LINE BREAKS AND RADIUS FOR TOWN HIGHWAYS)
 WALLINGFORD:
 STA. 9+200.0 - STA. 9+320.0 LT & RT

646.46 DURABLE 600 mm STOP BAR (THERMOPLASTIC)
 WALLINGFORD:
 STA. 9+284.306 LT, T-2

646.66 TEMPORARY 600 mm STOP BAR (PAINT)
 WALLINGFORD:
 STA. 9+284.306 LT, T-2

675.50 REMOVING SIGNS
 AS SHOWN - 18
 675.60 ERECTING SALVAGED SIGNS
 AS SHOWN - 2


646.41 DURABLE 100 mm YELLOW LINE (THERMOPLASTIC)
 (ALL LINES WILL INCLUDE C/L BREAKS FOR TOWN HIGHWAYS) S=SOLID, D=DASHED
 WALLINGFORD:
 STA. 9+200.0 - STA. 9+320.0 LT S C RT S
 STA. 9+284.306 DOUBLE SOLID LT, T-2

646.61 TEMPORARY 100 mm YELLOW LINE (PAINT)
 (ALL LINES WILL INCLUDE C/L BREAKS FOR TOWN HIGHWAYS) S=SOLID, D=DASHED
 WALLINGFORD:
 STA. 9+200.0 - STA. 9+320.0 LT S C RT S
 STA. 9+284.306 DOUBLE SOLID LT, T-2

646.50 DURABLE LETTER OR SYMBOL (THERMOPLASTIC)
 WALLINGFORD:
 STA. 9+284.306 LT, T-2 "S,T,O,P" (4 EA)

646.70 TEMPORARY LETTER OR SYMBOL (PAINT)
 WALLINGFORD:
 STA. 9+284.306 LT, T-2 "S,T,O,P" (8 EA) **NOT USED**

646.46 DURABLE 200 mm WHITE LINE (THERMOPLASTIC)
 WALLINGFORD:
 STA. 9+200.0 - STA. 9+245.0 RT, SHOULDER HATCHING (34.0 m)

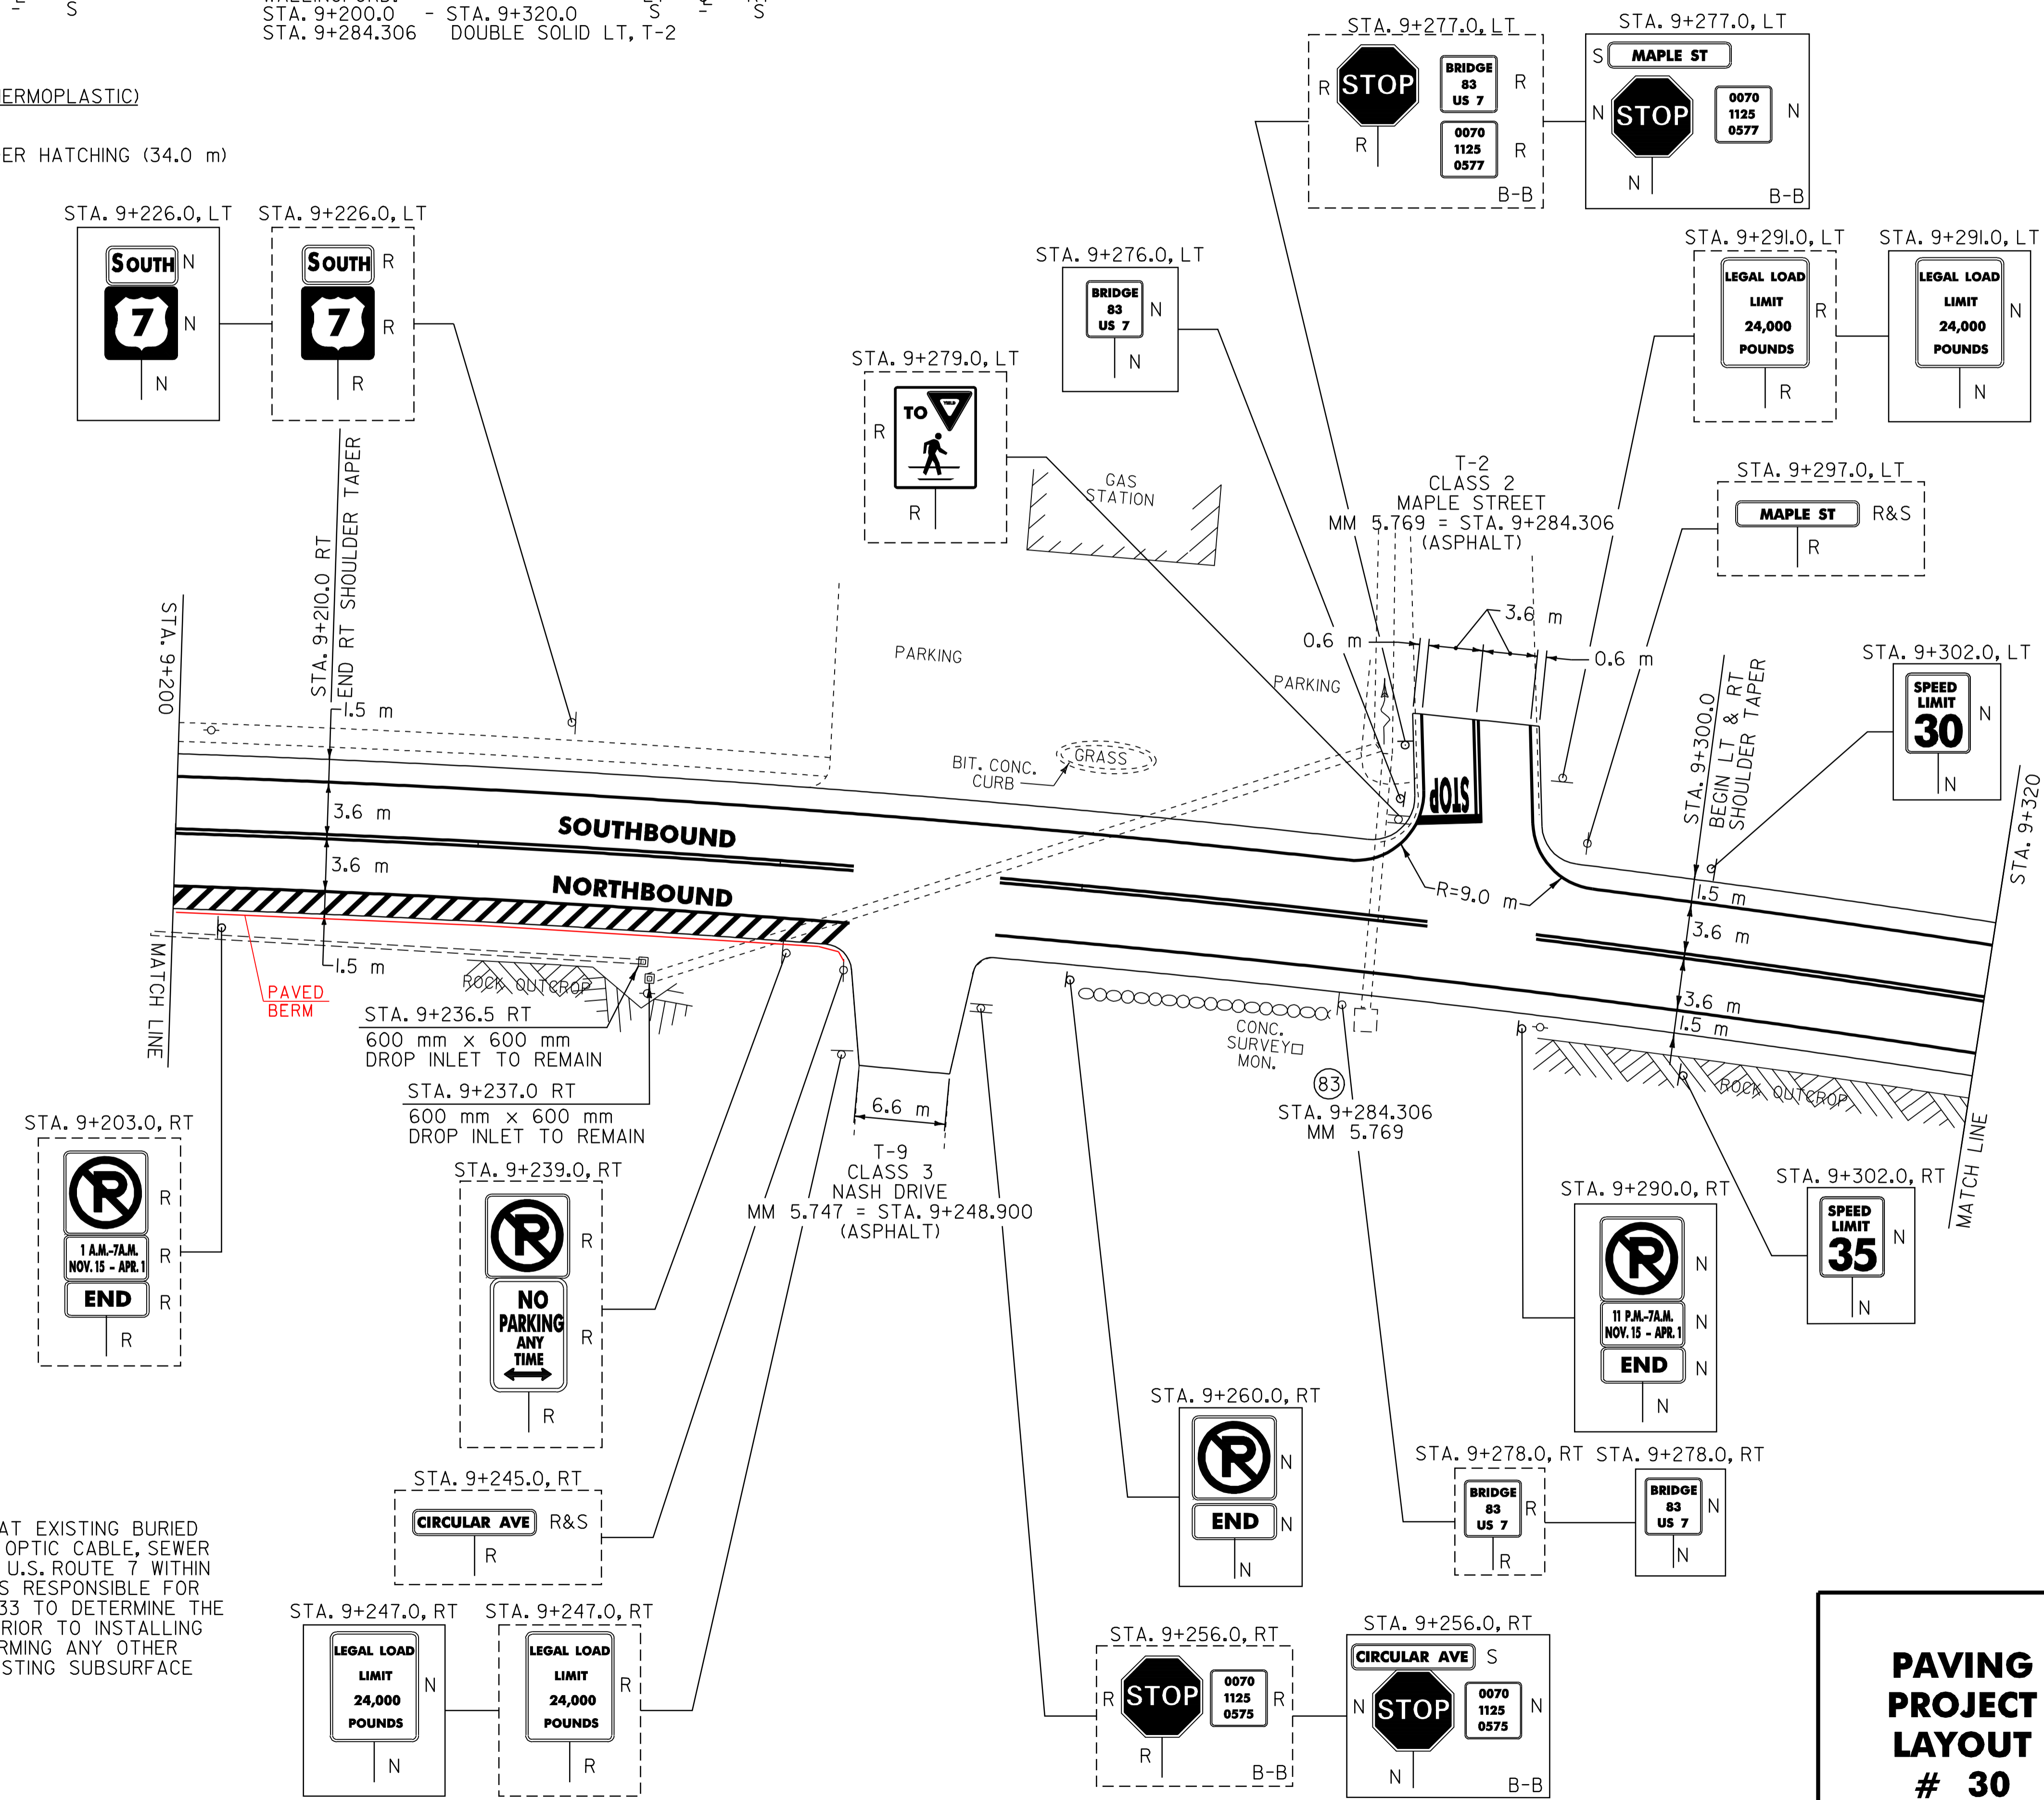

NOTE:
 1. THE CONTRACTOR SHOULD BE AWARE THAT EXISTING BURIED UTILITIES (SUCH AS PHONE CABLE, FIBER OPTIC CABLE, SEWER LINES, ETC.) ARE LOCATED ADJACENT TO U.S. ROUTE 7 WITHIN THE PROJECT LIMITS. THE CONTRACTOR IS RESPONSIBLE FOR CONTACTING "DIG SAFE" AT 1-888-344-7233 TO DETERMINE THE EXACT LOCATIONS OF THESE UTILITIES PRIOR TO INSTALLING GUARDRAIL, CLEANING DITCHES OR PERFORMING ANY OTHER OPERATIONS THAT MAY DISTURB THE EXISTING SUBSURFACE CONDITIONS.

DATUM	
VERTICAL	N/A
HORIZONTAL	N/A

SIGN LEGEND
 R= REMOVE
 S= SALVAGE
 N= NEW
 RET= RETAIN
 B-B= BACK TO BACK
 EXISTING= - - - - -
 NEW= _____
 ⊙ = SIGN TO BE RETURNED TO THE TOWN OF WALLINGFORD

PAVING PROJECT LAYOUT # 30

SURVEYED BY N/A DATE N/A
 DRAWN BY C.A.K. DATE 8/05
 SQUAD LEADER D.E.G.
 DESIGN FILE NO. /pave/98b098/pb098.dgn
 IPARM FILE pb09830.1 DATE 08-JUL-2007 15
 PROJ. NAME WALLINGFORD
 PROJ. NO. NH 2108(I)S & STP EHO4(6)
 SHEET 50 OF 110 SHEETS