


MISTAKENLY INSTALLED AS A TYPE I APPROACH.  
PAID AS TYPE I APPROACH.  
AS APPROVED BY ENGINEER.

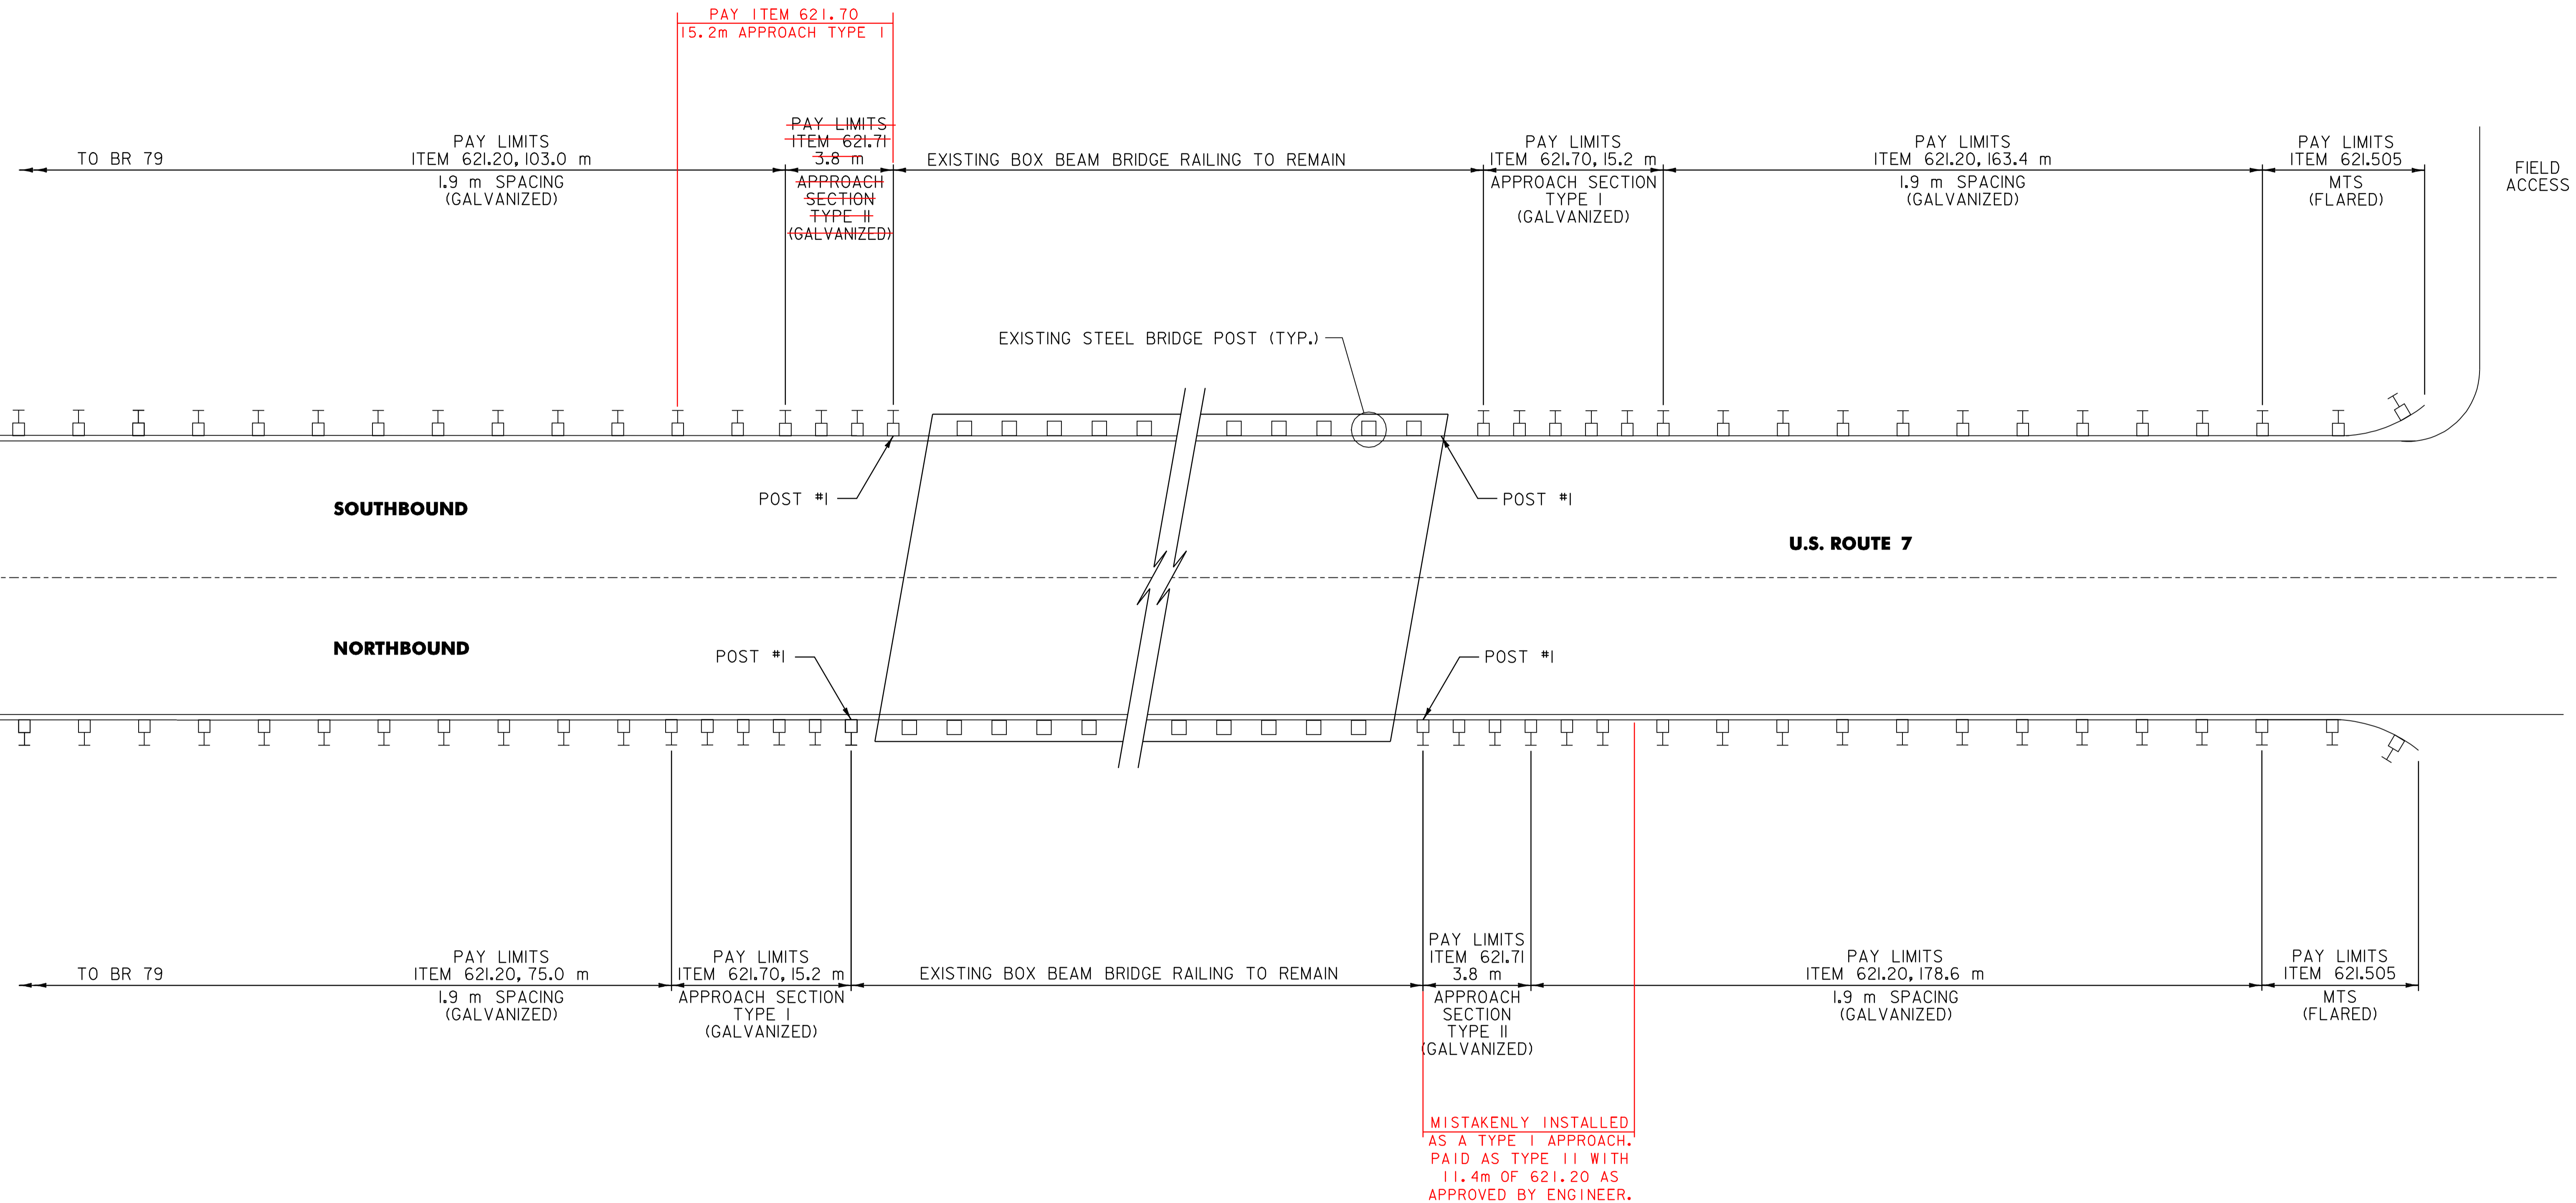

**BR 80 WALLINGFORD MM 4.741 = STA. 7+629.853**  
NOT TO SCALE

DATUM	
VERTICAL	N/A
HORIZONTAL	N/A

<b>BRIDGE DETAIL SHEET #2</b>	SURVEYED BY	N/A	DATE	N/A
	DRAWN BY	C.A.K.	DATE	8/05
	SQUAD LEADER	D.E.G.		
	DESIGN FILE NO.	/pave/98b098/pb098.dgn		
	IPARM FILE	pb098bd2.1	DATE PLOTTED	08-JUL-2007 15
PROJ. NAME	WALLINGFORD			
PROJ. NO.	NH 2108(I)S & STP EHO4(6)			
SHEET	84 OF 110	SHEETS		