


DATUM
VERTICAL NAVD 88
HORIZONTAL NAD 83 (1996)

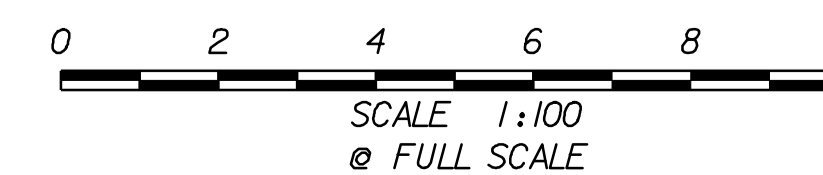

U.S ROUTE 7 CROSS SECTIONS SHEET 1	SURVEYED BY <u>LRSC</u> DATE <u>10/04</u>
	DRAWN BY <u>C.A.K.</u> DATE <u>8/05</u>
	SQUAD LEADER <u>D.E.G.</u>
	DESIGN FILE NO. <u>/pave/98b098/pb098.dgn</u>
	IPARM FILE <u>pb098xsl.i</u> DATE <u>08-JUL-2007 15:00</u>
PROJ. NAME <u>WALLINGFORD</u>	
PROJ. NO. <u>NH 2108(I)S & STP EHO4(6)</u>	
SHEET <u>87</u> OF <u>110</u> SHEETS	