


DATUM  
VERTICAL NAVD 88  
HORIZONTAL NAD 83 (1996)

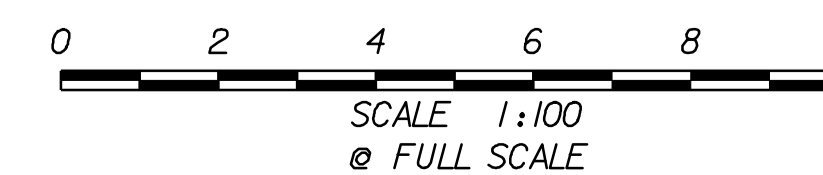

**U.S. ROUTE 7  
CROSS  
SECTIONS  
SHEET 2**

SURVEYED BY LRSC DATE 10/04  
DRAWN BY C.A.K. DATE 8/05  
SQUAD LEADER D.E.G.  
DESIGN FILE NO. /pave/98b098/pb098.dgn  
IPARM FILE pb098xs2.1 DATE PLOTTED 08-JUL-2007 15:00  
PROJ. NAME WALLINGFORD  
PROJ. NO. NH 2108(I)S & STP EHO4(6)  
SHEET 88 OF 110 SHEETS