


DATUM	
VERTICAL	NAVD 88
HORIZONTAL	NAD 83 (1996)

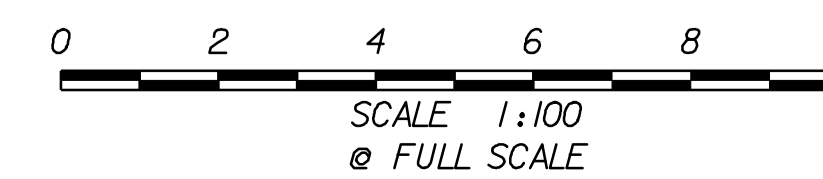

U.S ROUTE 7 CROSS SECTIONS SHEET 3	SURVEYED BY	LRSC	DATE	10/04
	DRAWN BY	C.A.K.	DATE	8/05
	SQUAD LEADER	D.E.G.		
	DESIGN FILE NO.	/pave/98b098/pb098.dgn		
	IPARM FILE	pb098xs3.1	DATE PLOTTED	08-JUL-2007 15
PROJ. NAME	WALLINGFORD			
PROJ. NO.	NH 2108(I)S & STP EHO4(6)			
SHEET 89 OF 110	SHEETS			