


DATUM	
VERTICAL	NAVD 88
HORIZONTAL	NAD 83 (1996)

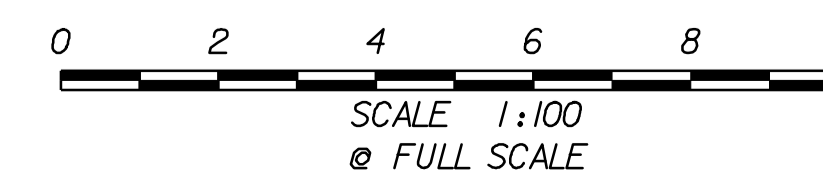

U.S ROUTE 7 CROSS SECTIONS SHEET 4	SURVEYED BY	LRSC	DATE	10/04
	DRAWN BY	C.A.K.	DATE	8/05
	SQUAD LEADER	D.E.G.		
	DESIGN FILE NO.	/pave/98b098/pb098.dgn		
	IPARM FILE	pb098xs4.1	DATE PLOTTED	08-JUL-2007 15:00
	PROJ. NAME	WALLINGFORD		
	PROJ. NO.	NH 2108(I)S & STP EHO4(6)		
	SHEET	90	OF	110
			SHEETS	