


DATUM
VERTICAL NAVD 88
HORIZONTAL NAD 83 (1996)

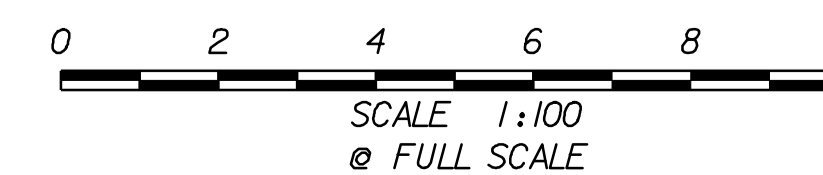

**U.S. ROUTE 7
CROSS
SECTIONS
SHEET 7**

SURVEYED BY LRSC DATE 10/04
DRAWN BY C.A.K. DATE 8/05
SQUAD LEADER D.E.G.
DESIGN FILE NO. /pave/98b098/pb098.dgn
IPARM FILE pb098xs7.1 DATE PLOTTED 08-JUL-2007 15:00
PROJ. NAME WALLINGFORD
PROJ. NO. NH 2108(I)S & STP EHO4(6)
SHEET 93 OF 110 SHEETS