

BEGIN SIDEWALK RECONSTRUCTION
STP EHO4(6)
MM 5.335 = STA. 8+585.850

T-56
CLASS 3
FLORENCE AVENUE
MM 5.332 = STA. 8+581.022
(ASPHALT)

ROARING BROOK
MM 5.351 = STA. 8+611.600

SAVERY,
RICHARD & HELEN

BUSHEY,
ROBERT & PATRICIA

PEET, BARBARA

KREBS,
ALBERT & GAIL

GILBERT HART
LIBRARY

SOUTHBOUND

NORTHBOUND

U.S. ROUTE 7

MATCH LINE


HCTRL #1
N 107873.255
E 461369.275
ELEV. 182.970

HCTRL #2
N 107923.576
E 461378.447
ELEV. 183.213

T-II
CLASS 3
MILL STREET
MM 5.324 = STA. 8+568.147
(ASPHALT)

13B

13B

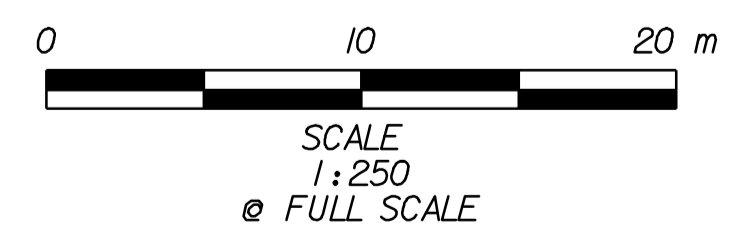

DATUM	
VERTICAL	NAVD 88
HORIZONTAL	NAD 83 (1996)

LEGEND	
XXX	MAP UNIT TYPE (SEE SHEET 95 OF 110 FOR DETAILS)
--- VEG ---	SOIL LINE BOUNDARY
	WETLAND / RIPARIAN BOUNDARY
	WETLAND BUFFER
	RIPARIAN BUFFER

**FINAL
CONDITIONS
PLAN #1**

SURVEYED BY	L.R.S.C.	DATE	10/04
DRAWN BY	C.A.K.	DATE	4/05
SQUAD LEADER	D.E.G.		
DESIGN FILE NO.	/pave/98b098/pb098.dgn		
IPARM FILE	pb098126.1	DATE PLOTTED	\$DATE\$
PROJ. NAME	WALLINGFORD		
PROJ. NO.	NH 2108(I)S & STP EHO4(6)		
SHEET	107 OF 110	SHEETS	