

TEMPORARY AND DURABLE 100 mm YELLOW LINE

STA 3+850 TO 4+200 SOLID LT & RT


TEMPORARY AND DURABLE 100 mm WHITE LINE

STA 3+850 TO 4+200 SOLID LT & RT

~~CHANGING ELEV. OF DI, CB OR MH~~

REHABILITATION OF DI, CB OR MH, CLASS I

STA 3+887 LT ✓

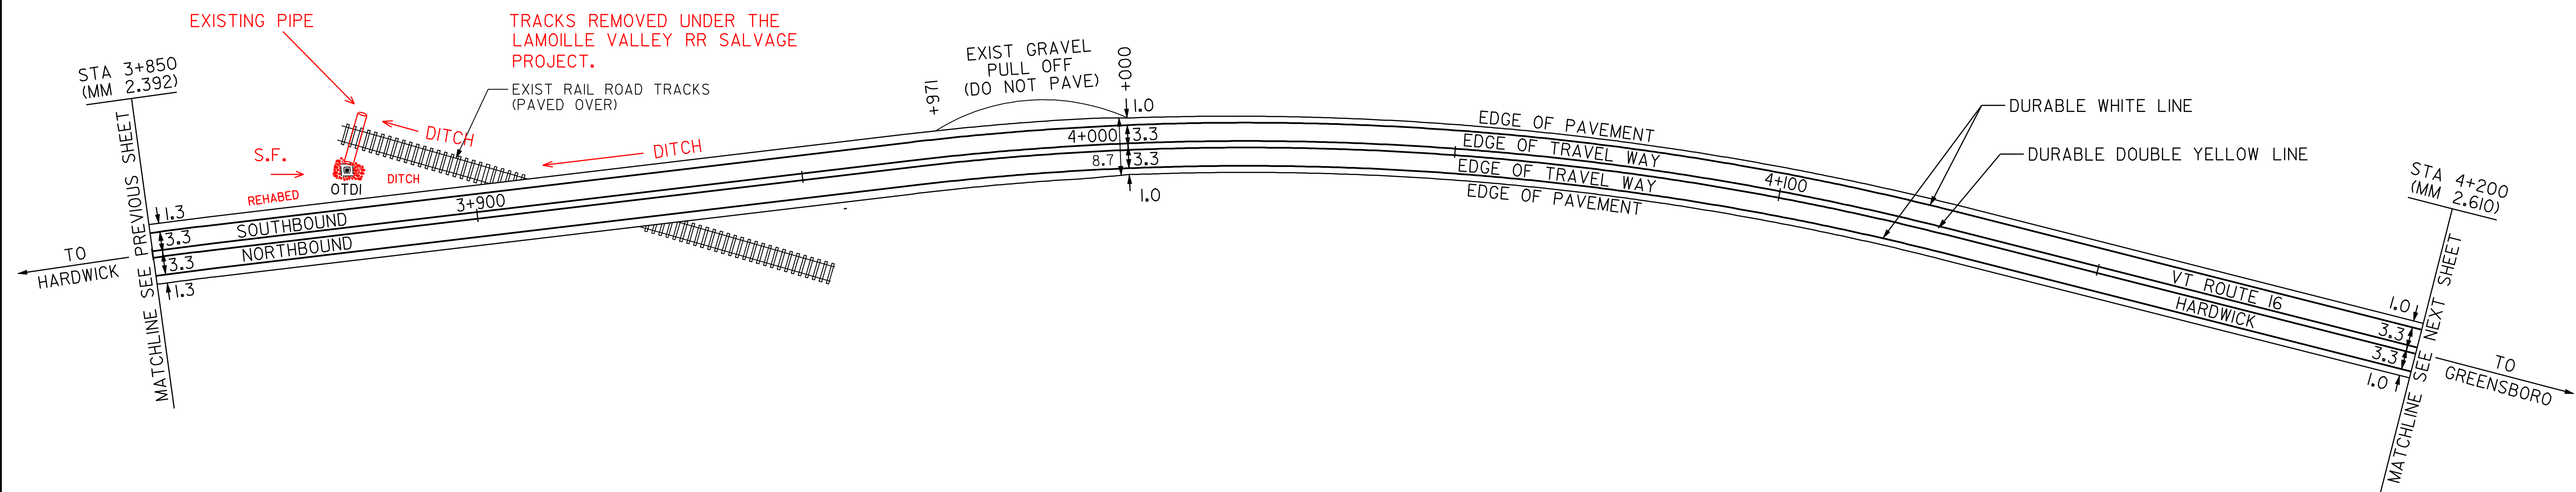

DATUM	
VERTICAL	N/A
HORIZONTAL	N/A

NOT TO SCALE

LEGEND

- R = REMOVE EXISTING
- S = SALVAGE
- R&S = REMOVE AND SALVAGE
- N = NEW
- RET = RETAIN
- B-B = BACK TO BACK
- NEW RAIL = NEW RAIL
- EXISTING RAIL = EXISTING RAIL
- BORING LOCATION = BORING LOCATION
- S.F. = STONE FILL

NOTE: ALL DIMENSIONS IN METERS EXCEPT AS INDICATED

PAVING PROJECT LAYOUT #4

PROJECT:	HARDWICK-GREENSBORO	PROJECT No.:	STP 2112(I)S
DESIGN FILE NAME:	pave/98b106/pbl06.dgn	PLOT DATE:	10-JUL-2006 13:50
IPARM FILE NAME:	pbl061a04.i	SURVEY DATE:	6/99
SURVEYED BY:	CLD ENGINEERS, INC.	DRAWN BY:	JPC
SQUAD LEADER:	WRH	SHEET:	13 OF 43