

TEMPORARY AND DURABLE 100 mm YELLOW LINE
 STA 4+200 TO 4+900 SOLID LT & RT

TEMPORARY AND DURABLE 100 mm WHITE LINE
 STA 4+200 TO 4+900 SOLID LT & RT


MANUFACTURED TERMINAL SECTION (FLARED)
 STA 4+650.0 RT ~ 4+661.43 RT
 4+878.6 STA 4+873.6 RT ~ 4+885.0 RT 4+890.03

~~CHANGING ELEV. OF DI, CB OR MH~~
 REHABILITATION OF DI, CB OR MH, CLASS I
 STA 4+887 LT ✓

STEEL BEAM GUARDRAIL
 STA 4+661.43 ~ 4+873.6 RT
 4+878.6

RELOCATE MAILBOX SINGLE SUPPORT
 STA 4+650 RT

REMOVAL & DISP. OF GUARDRAIL
 STA 4+650.0 ~ 4+885.0 RT
 4+890.03

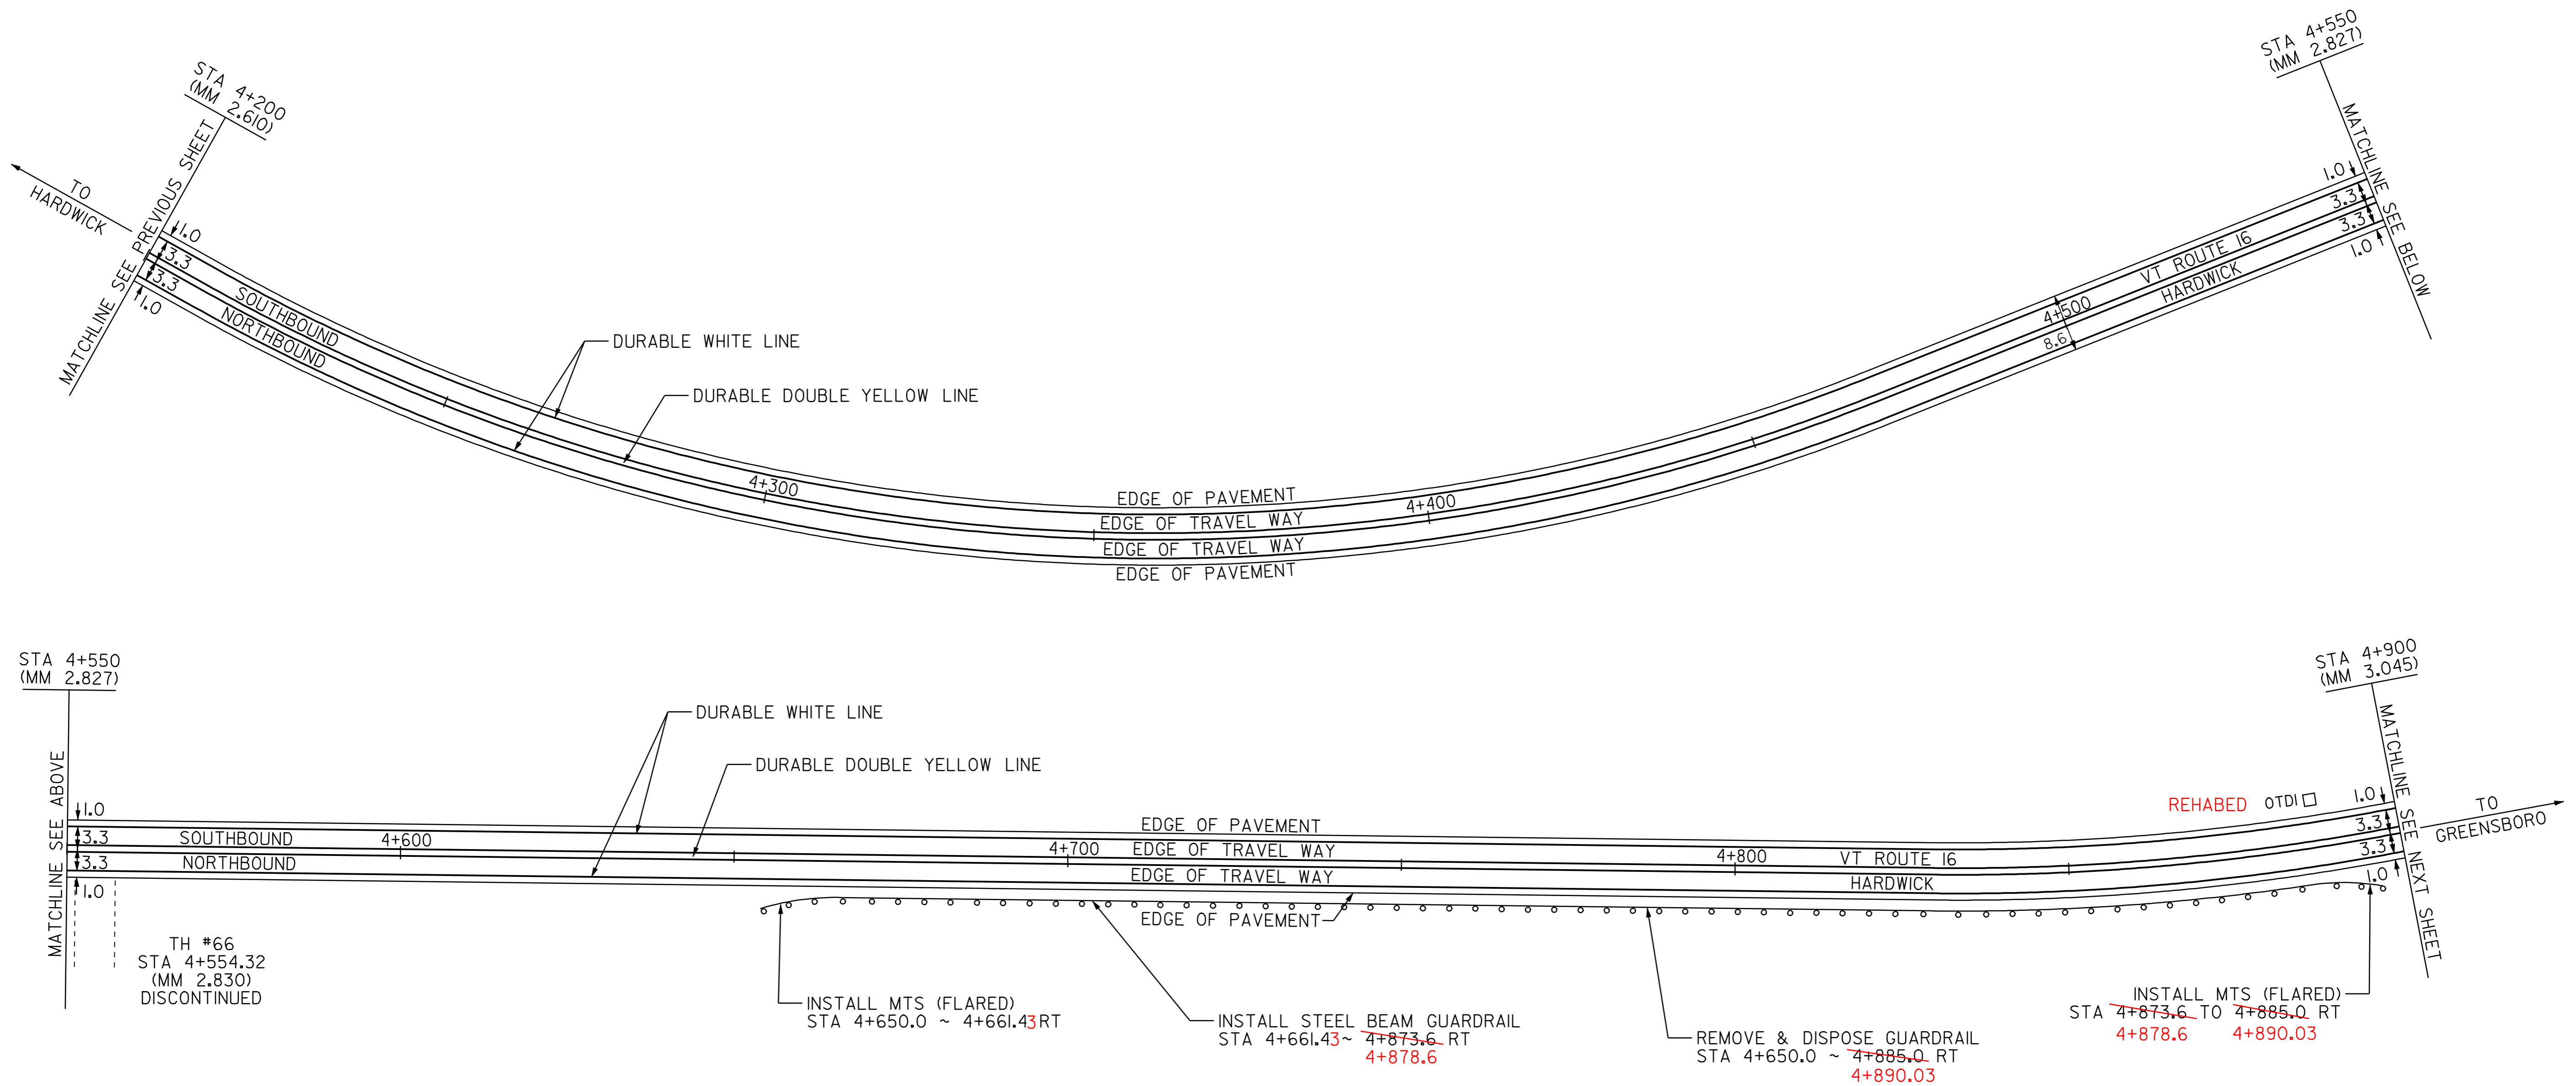

STA 4+550 (MM 2.827)
 MATCHLINE SEE ABOVE
 1.0
 3.3 SOUTHBOUND
 3.3 NORTHBOUND
 1.0
 TH #66
 STA 4+554.32 (MM 2.830)
 DISCONTINUED

INSTALL MTS (FLARED)
 STA 4+650.0 ~ 4+661.43 RT

INSTALL STEEL BEAM GUARDRAIL
 STA 4+661.43 ~ 4+873.6 RT
 4+878.6

REMOVE & DISPOSE GUARDRAIL
 STA 4+650.0 ~ 4+885.0 RT
 4+890.03

INSTALL MTS (FLARED)
 STA 4+873.6 TO 4+885.0 RT
 4+878.6 4+890.03

REHABED OTDI

LEGEND

- R = REMOVE EXISTING
- S = SALVAGE
- R&S = REMOVE AND SALVAGE
- N = NEW
- RET = RETAIN
- B-B = BACK TO BACK
- = NEW RAIL
- - - EXISTING RAIL
- ⊗ = BORING LOCATION

NOTE: ALL DIMENSIONS IN METERS EXCEPT AS INDICATED

DATUM	
VERTICAL	N/A
HORIZONTAL	N/A

NOT TO SCALE

PAVING PROJECT LAYOUT #5

PROJECT: HARDWICK-GREENSBORO	PROJECT NO.: STP 2112(IIS)
DESIGN FILE NAME: pave/98b106/pb106.dgn	PLOT DATE: 10-JUL-2006 13:50
IPARM FILE NAME: pb1061a05-1	SURVEY DATE: 6/99
SURVEYED BY: CLD ENGINEERS, INC.	DRAWN BY: JPC
SQUAD LEADER: WRH	SHEET: 14 OF 43