


TEMPORARY AND DURABLE 100 mm YELLOW LINE
 STA 0+600 TO 1+250 SOLID LT & RT
 TEMPORARY AND DURABLE 100 mm WHITE LINE
 STA 0+600 TO 1+250 SOLID LT & RT

~~CHANGING ELEV. OF DI, CB OR MH~~
~~REHABILITATION OF DI, CB OR MH, CLASS I~~
 STA ~~0+887 LT~~ NO WORK REQUIRED
 STA 1+023 LT

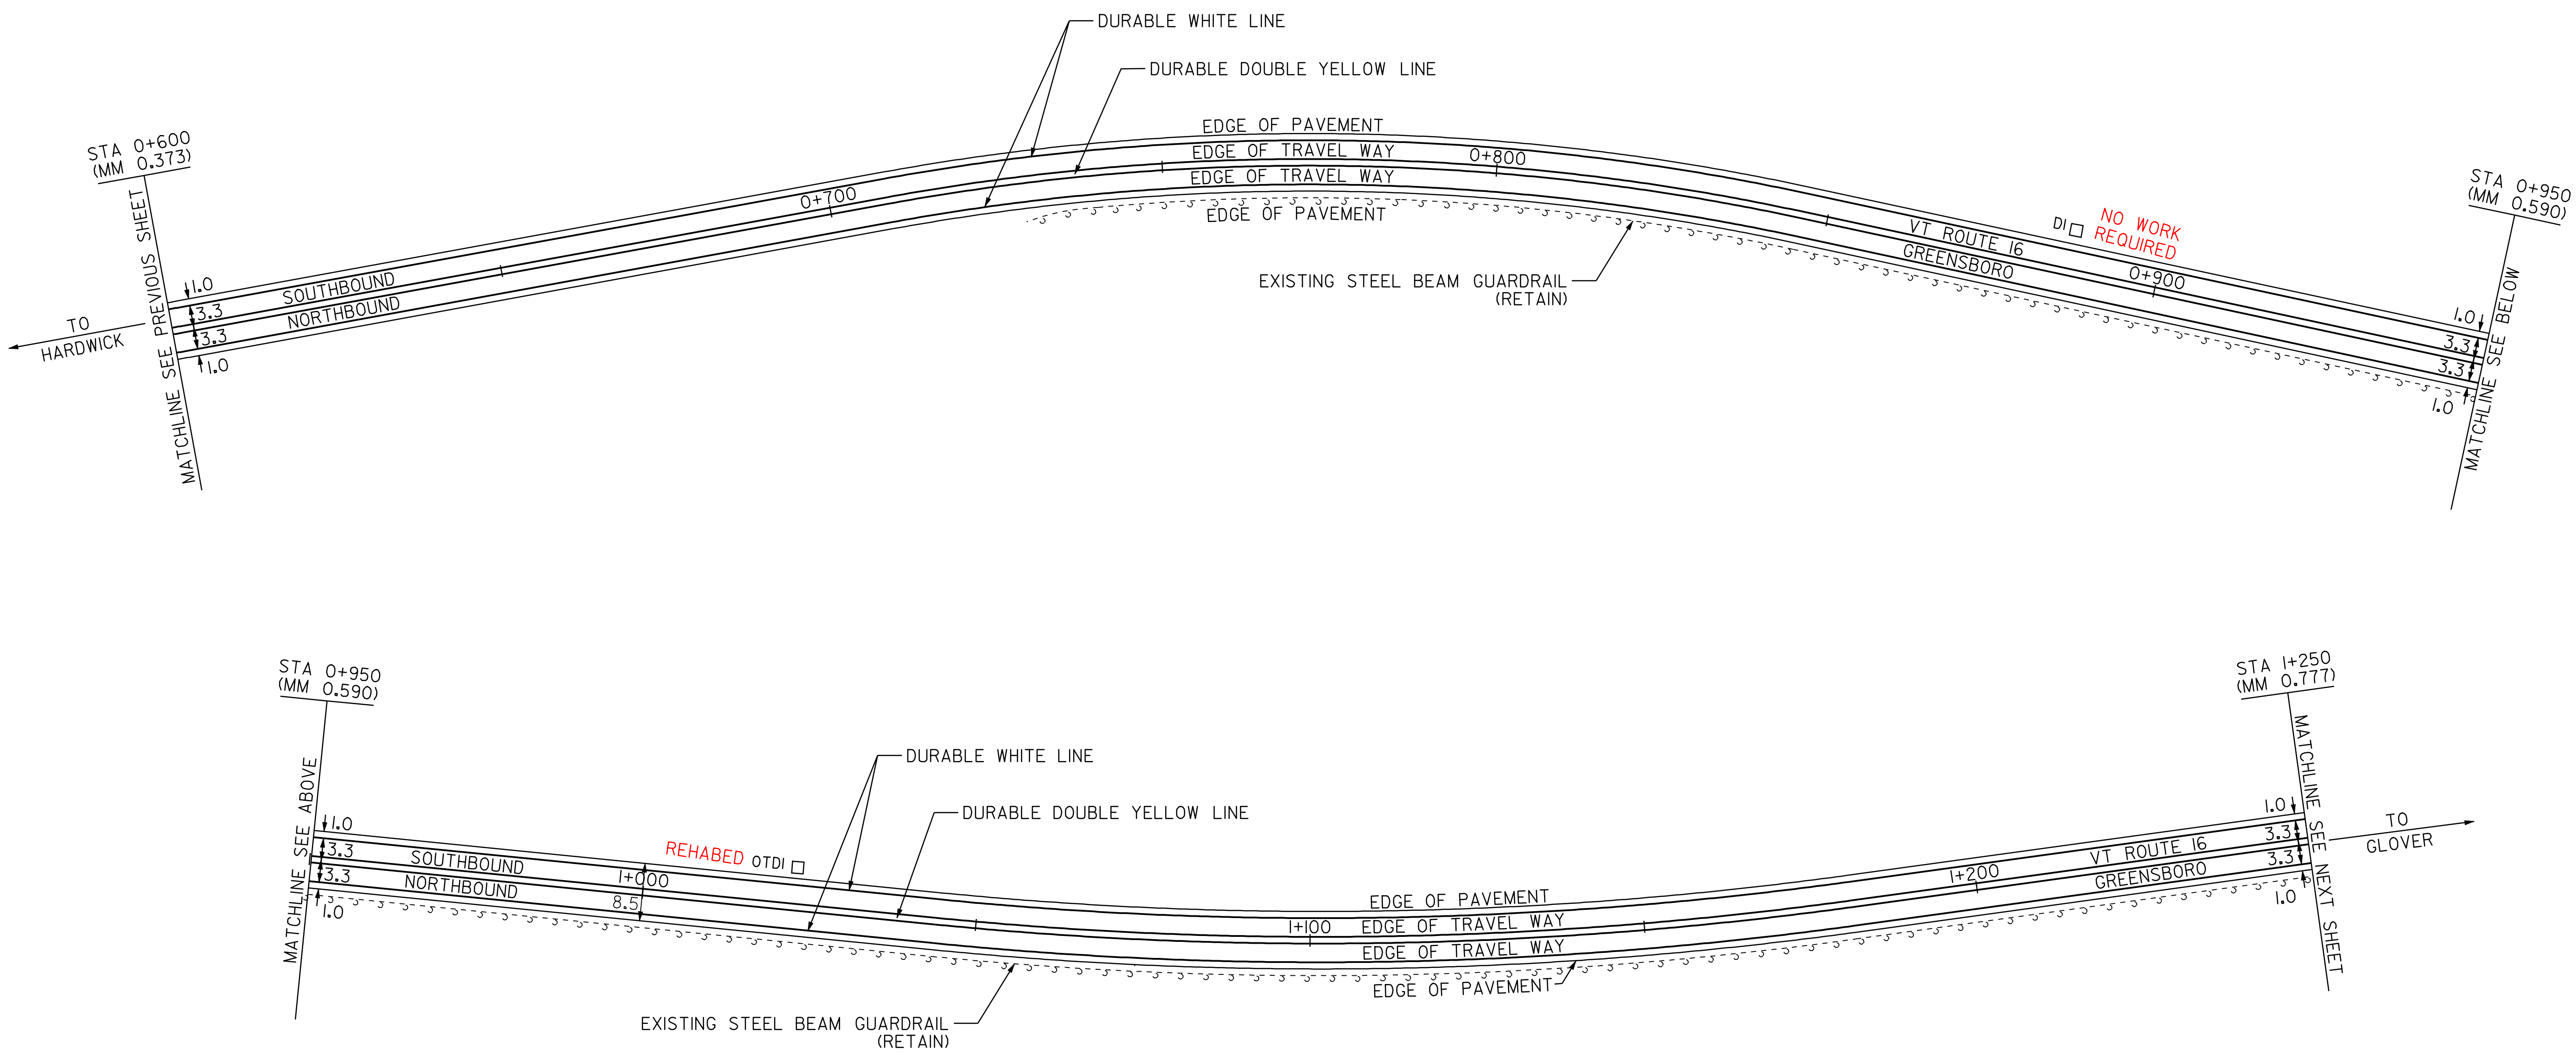

STA	TOTAL DEPTH (MM)	PCC
7 STA 0+869 RT	180	NO

DATUM
 VERTICAL N/A
 HORIZONTAL N/A

LEGEND

- R = REMOVE EXISTING
- S = SALVAGE
- R&S = REMOVE AND SALVAGE
- N = NEW
- RET = RETAIN
- B-B = BACK TO BACK
- = NEW RAIL
- - - = EXISTING RAIL
- ⊗ = BORING LOCATION

NOTE: ALL DIMENSIONS IN METERS EXCEPT AS INDICATED

NOT TO SCALE

PAVING PROJECT LAYOUT #13

PROJECT: HARDWICK-GREENSBORO	PROJECT NO.: STP 2112(1)S
DESIGN FILE NAME: pqve/98b106/pbl06.dgn	PLOT DATE: 10-JUL-2006 13:51
IPARM FILE NAME: pbl061a13.1	SURVEY DATE: 6/99
SURVEYED BY: CLD ENGINEERS, INC.	DRAWN BY: JPC
SQUAD LEADER: WRH	SHEET: 22 OF 43