

TEMPORARY AND DURABLE 100 mm YELLOW LINE  
 STA 3+600 TO 4+250 SOLID LT & RT


TEMPORARY AND DURABLE 100 mm WHITE LINE  
 STA 3+600 TO 4+250 SOLID LT & RT

MANUFACTURED TERMINAL SECTION (FLARED)

STA 3+750.0 ~ 3+761.43 RT  
 STA 3+870.0 ~ 3+881.4 LT  
 3+933.57 STA 3+933.6 ~ 3+945.0 RT  
 3+968.57 STA 3+968.6 ~ 3+980.0 LT

REMOVAL & DISP. OF GUARDRAIL

STA 3+750.0 ~ 3+761.43 RT  
 STA 3+870.0 ~ 3+881.43 LT  
 3+932.96 STA 3+933.6 ~ 3+945.0 RT 3+944.39  
 3+968.57 STA 3+968.6 ~ 3+980.0 LT

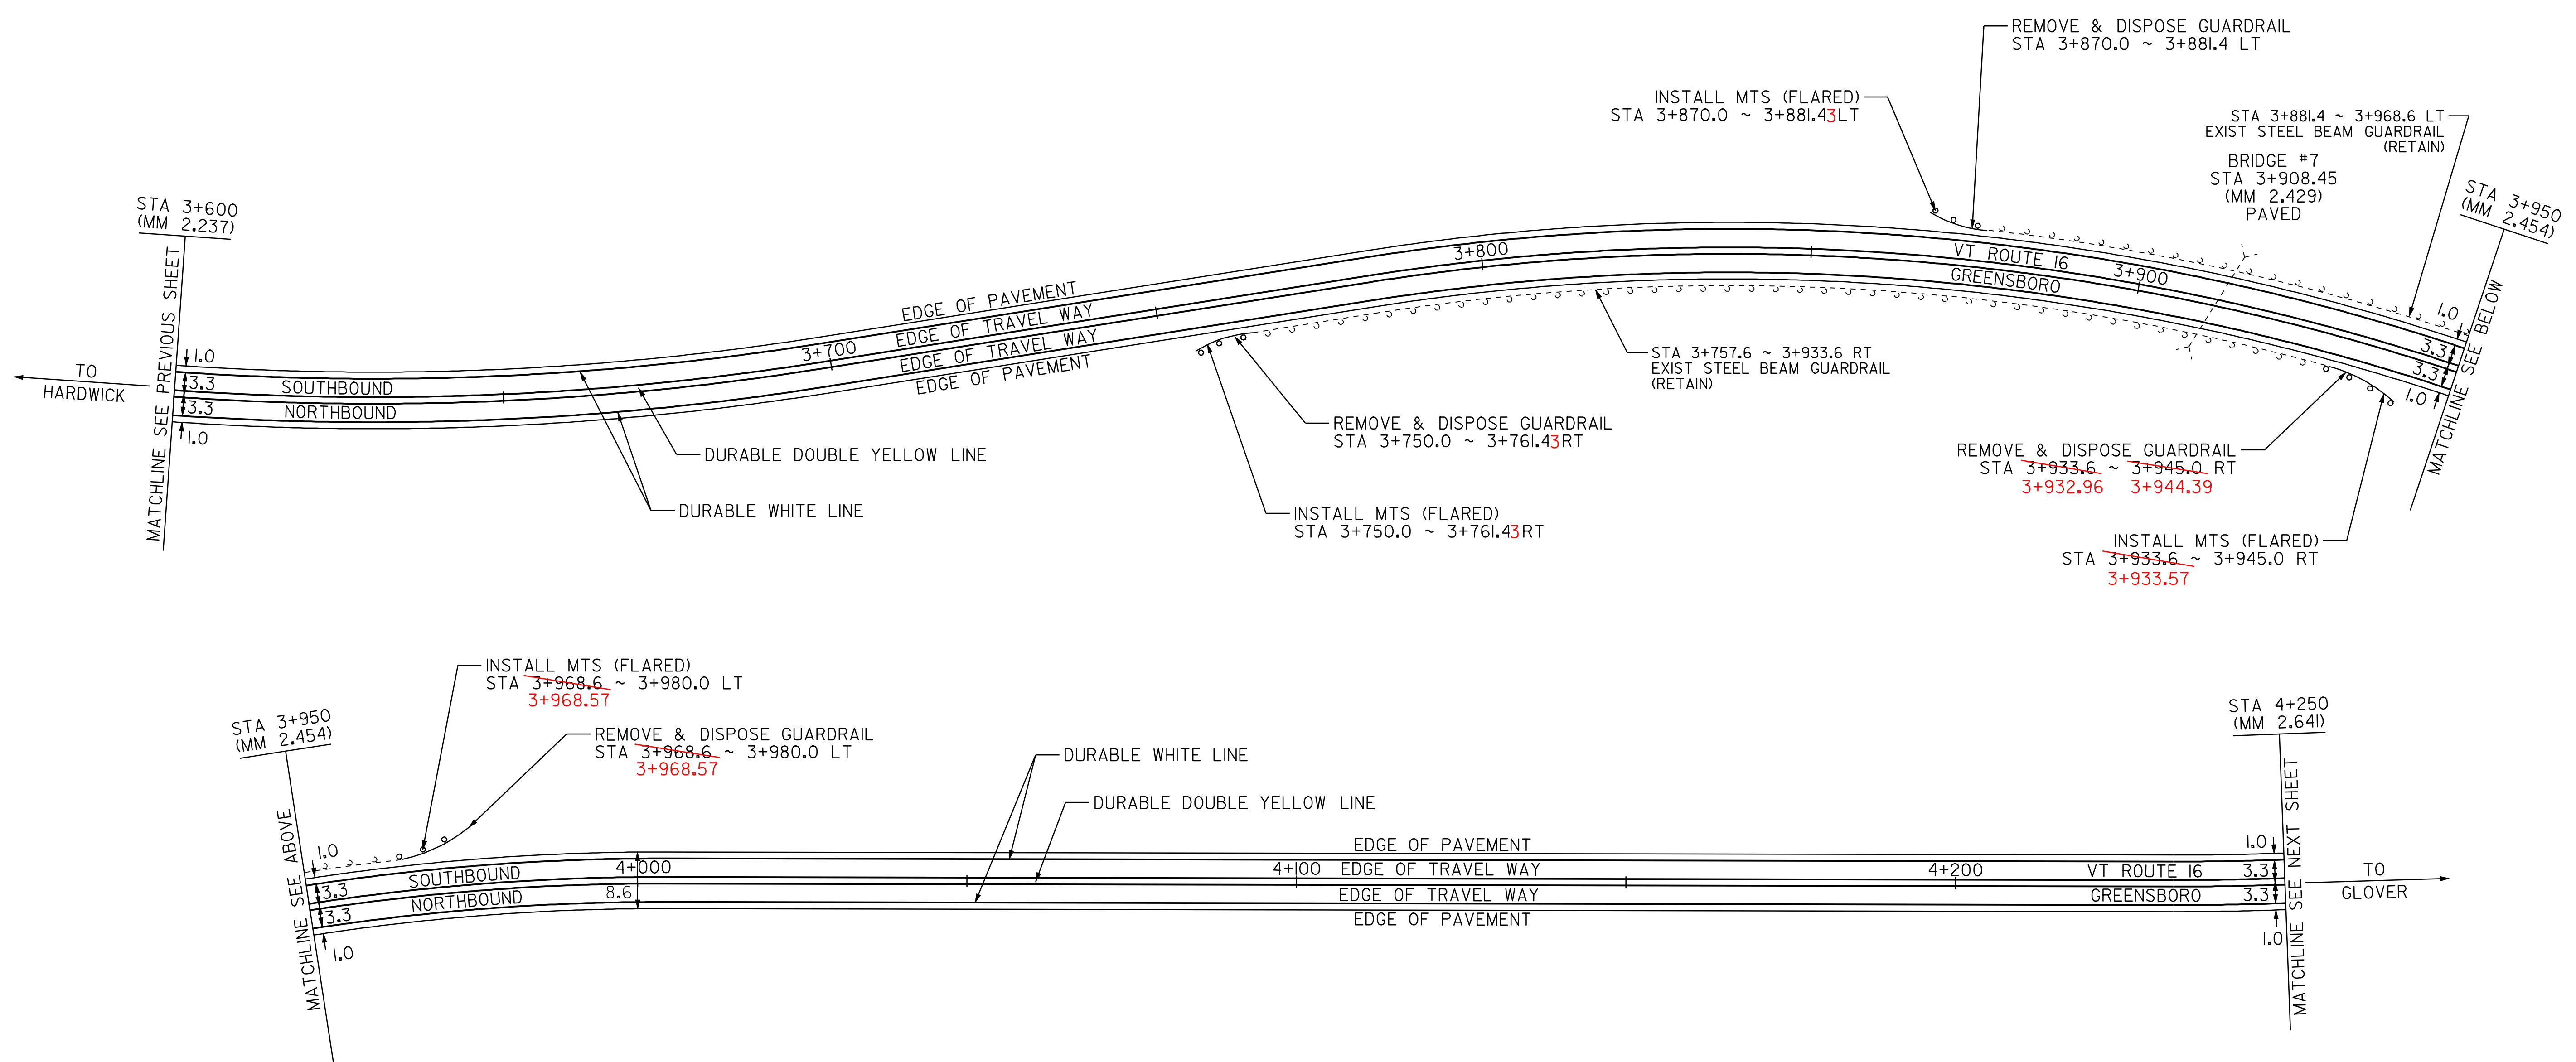

DATUM	
VERTICAL	N/A
HORIZONTAL	N/A

NOT TO SCALE

LEGEND

- R = REMOVE EXISTING
- S = SALVAGE
- R&S = REMOVE AND SALVAGE
- N = NEW
- RET = RETAIN
- B-B = BACK TO BACK
- = NEW RAIL
- - - = EXISTING RAIL
- ⊗ = BORING LOCATION

NOTE: ALL DIMENSIONS IN METERS EXCEPT AS INDICATED

<b>PAVING PROJECT LAYOUT #19</b>	PROJECT: HARDWICK-GREENSBORO	PROJECT NO.: STP 2112(1)S
	DESIGN FILE NAME: pave/98b106/pbl06.dgn	
	IPARM FILE NAME: pbl061d19.1	PLOT DATE: 10-JUL-2006 13:50
	SURVEYED BY: CLD ENGINEERS, INC.	SURVEY DATE: 6/99
SQUAD LEADER: WRH	DRAWN BY: JPC	
		SHEET: 28 OF 43