


TEMPORARY AND DURABLE 100 mm YELLOW LINE
 STA 4+250 TO 4+600 SOLID LT & RT

TEMPORARY AND DURABLE 100 mm WHITE LINE
 STA 4+250 TO 4+600 SOLID LT & RT

~~CHANGING ELEV. OF DI, CB OR MH~~
 REHABILITATION OF DI, CB OR MH, CLASS J
 STA 4+436 LT
 STA ~~4+576 LT~~ NO WORK REQUIRED

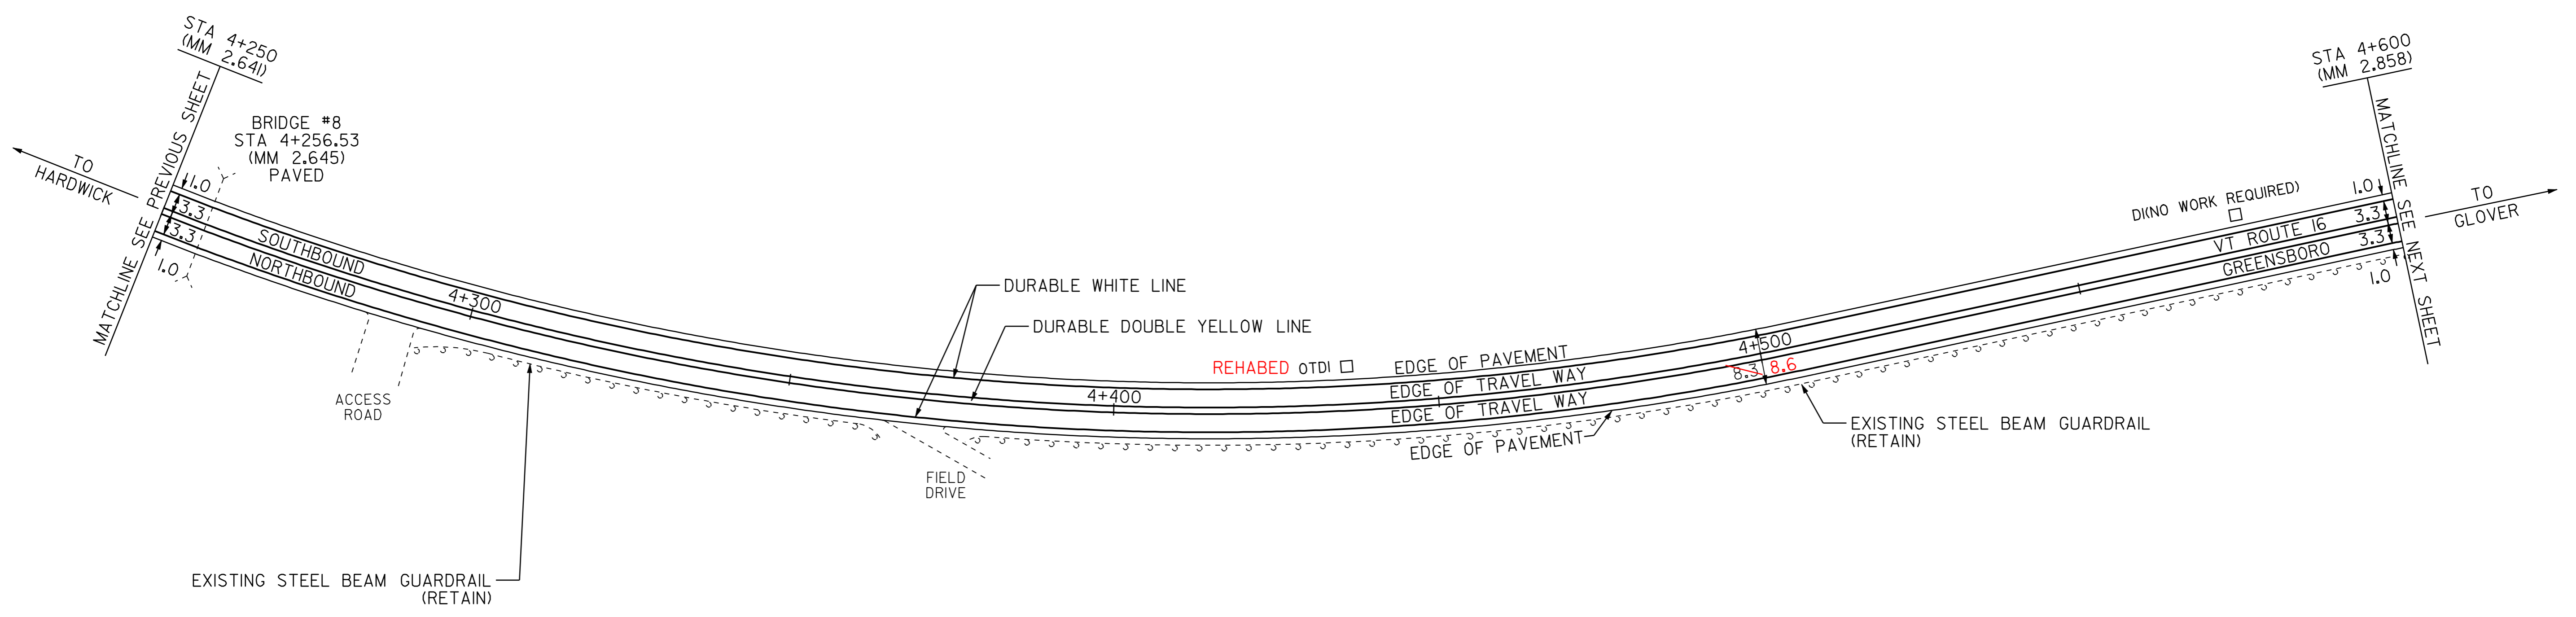

DATUM	
VERTICAL	N/A
HORIZONTAL	N/A

NOT TO SCALE

LEGEND

- R = REMOVE EXISTING
- S = SALVAGE
- R&S = REMOVE AND SALVAGE
- N = NEW
- RET = RETAIN
- B-B = BACK TO BACK
- = NEW RAIL
- - - = EXISTING RAIL
- ⊗ = BORING LOCATION

NOTE: ALL DIMENSIONS IN METERS EXCEPT AS INDICATED

PAVING PROJECT LAYOUT #20	PROJECT: HARDWICK-GREENSBORO	PROJECT NO.: STP 2112(1)S
	DESIGN FILE NAME: pave/98b106/pb106.dgn	PLOT DATE: 10-JUL-2006 13:50
	IPARM FILE NAME: pb106a20.i	SURVEY DATE: 6/99
	SURVEYED BY: CLD ENGINEERS, INC.	DRAWN BY: JPC
	SQUAD LEADER: WRH	SHEET: 29 OF 43