


TEMPORARY AND DURABLE 100 mm YELLOW LINE
 STA 4+600 TO 5+200 SOLID LT & RT

TEMPORARY AND DURABLE 100 mm WHITE LINE
 STA 4+600 TO 5+200 SOLID LT & RT

~~CHANGING ELEV. OF DI, CB OR MH~~
~~REHABILITATION OF DI, CB OR MH, CLASS I~~
 STA 4+817 LT
 STA 4+992 LT NO WORK REQUIRED

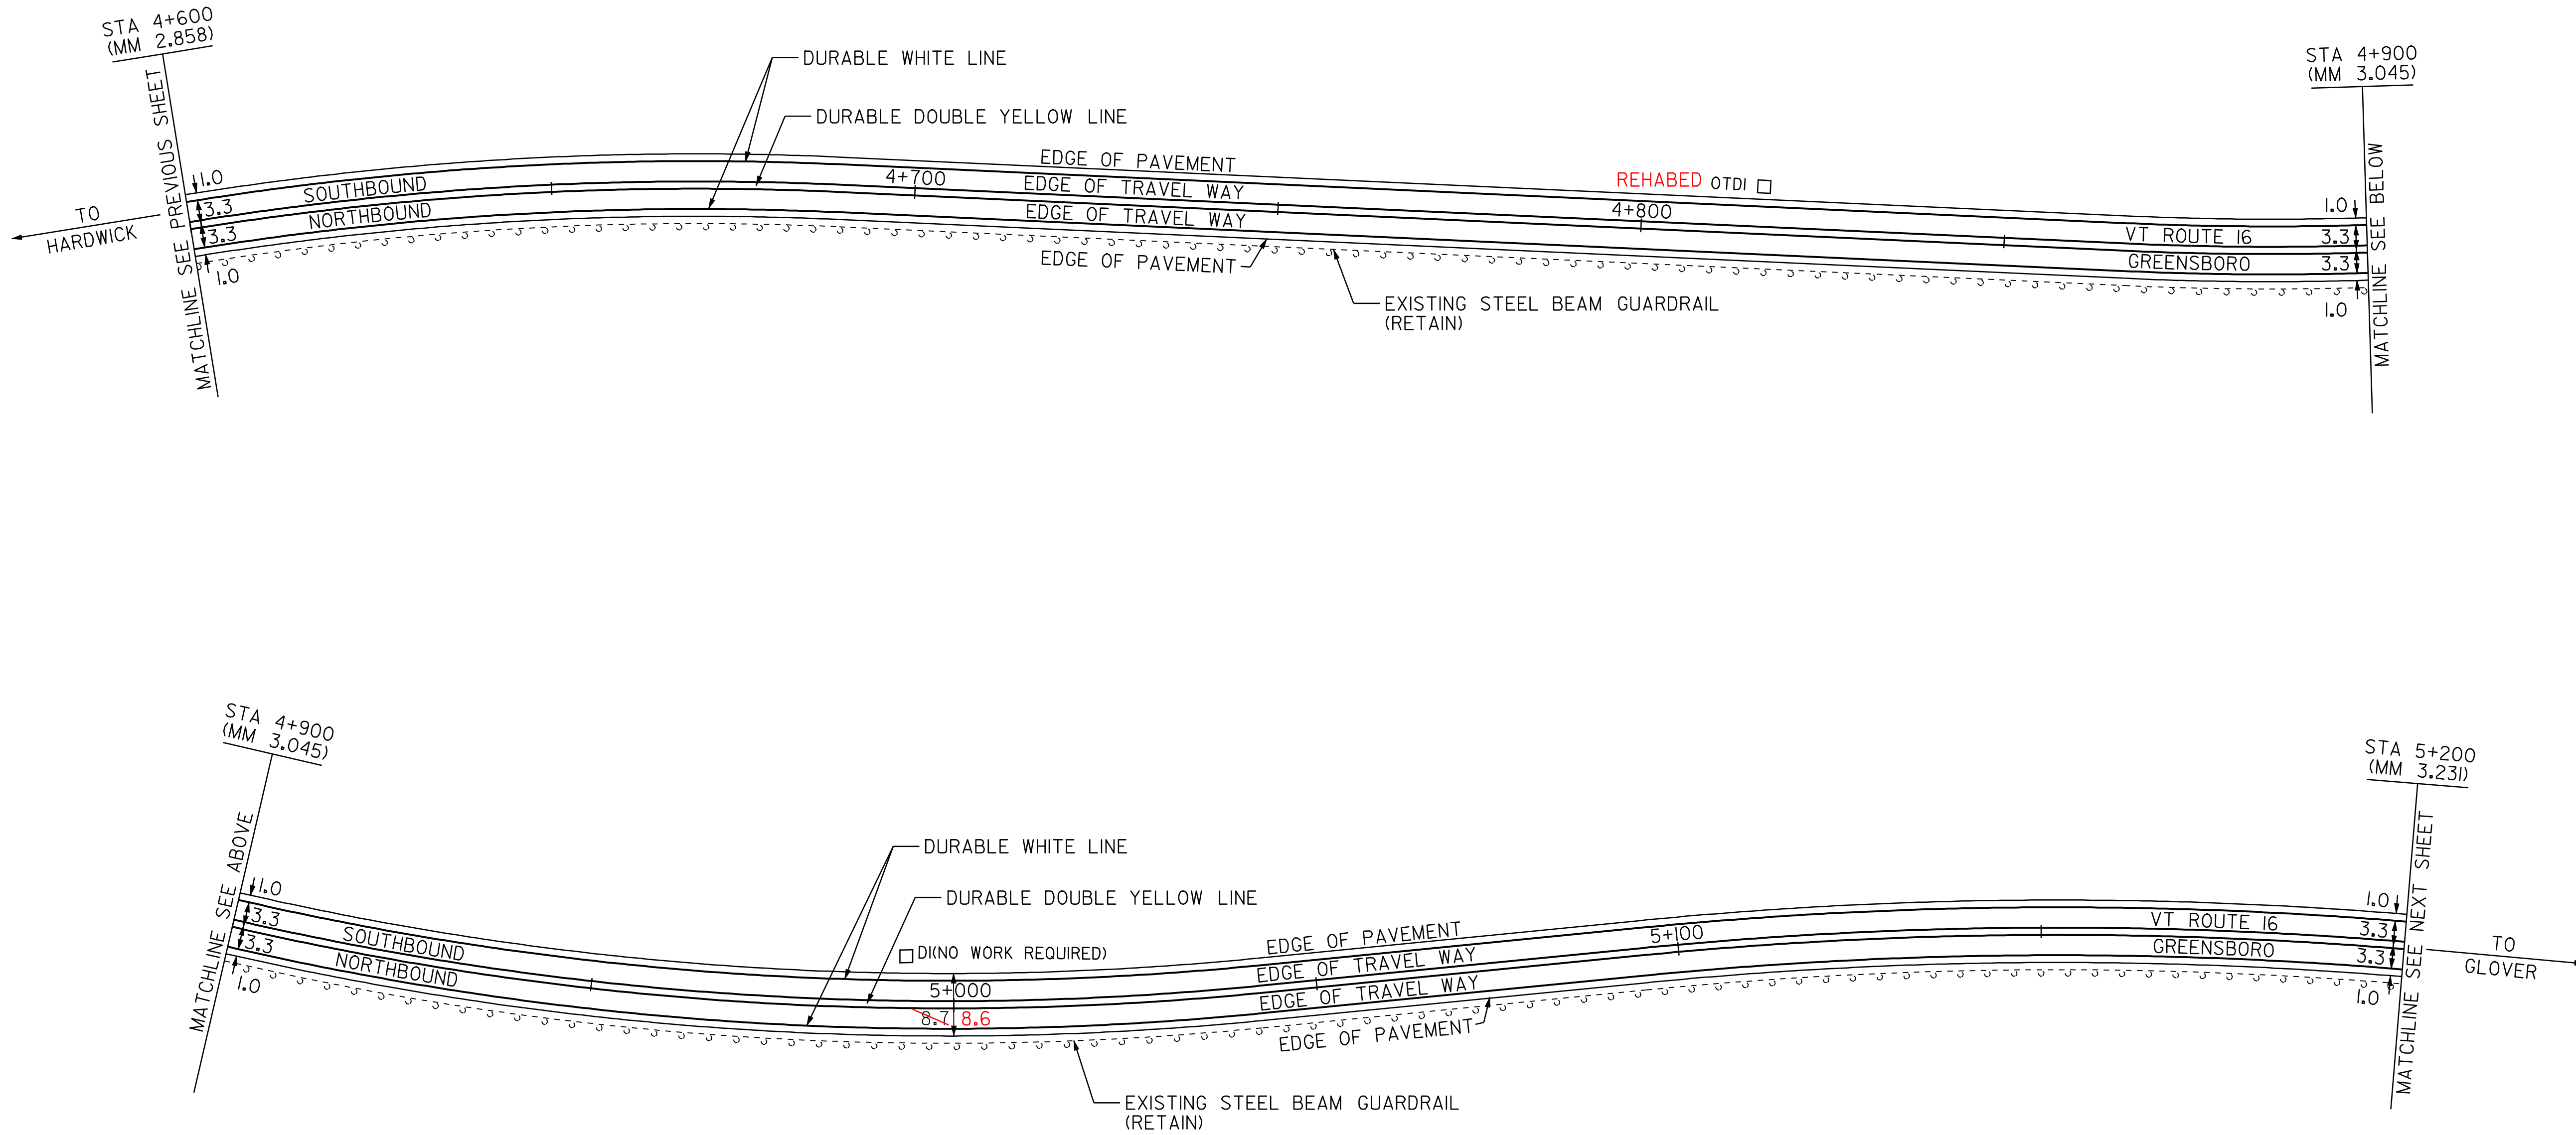

STA	TOTAL DEPTH (MM)	PCC
12 STA 4+949 LT 114		NO

DATUM	
VERTICAL	N/A
HORIZONTAL	N/A

LEGEND

- R = REMOVE EXISTING
- S = SALVAGE
- R&S = REMOVE AND SALVAGE
- N = NEW
- RET = RETAIN
- B-B = BACK TO BACK
- = NEW RAIL
- - - = EXISTING RAIL
- ⊗ = BORING LOCATION

NOTE: ALL DIMENSIONS IN METERS EXCEPT AS INDICATED

PAVING PROJECT LAYOUT #21

PROJECT: HARDWICK-GREENSBORO	PROJECT NO.: STP 2112(1)S
DESIGN FILE NAME: pave/98b106/pbl06.dgn	PLOT DATE: 10-JUL-2006 13:50
IPARM FILE NAME: pbl06a21.i	SURVEY DATE: 6/99
SURVEYED BY: CLD ENGINEERS, INC.	DRAWN BY: JPC
SQUAD LEADER: WRH	SHEET: 30 OF 43

NOT TO SCALE