

TEMPORARY AND DURABLE 100 mm YELLOW LINE  
 STA 6+250 TO 6+464 SOLID LT & RT  
 STA 6+476 TO 6+575 SOLID LT & RT

TEMPORARY AND DURABLE 100 mm WHITE LINE  
 STA 6+250 TO 6+467 SOLID LT & RT  
 STA 6+473 TO 6+575 SOLID LT & RT

REMOVAL & DISP. OF GUARDRAIL  
 6+481.57 STA ~~6+481.0~~ ~ 6+493.0 RT  
 6+511.57 STA ~~6+512.0~~ ~ 6+523.0 LT  
 STA 6+479.0 ~ 6+490.43 RT  
 6+548.57 STA ~~6+548.6~~ ~ 6+560.0 RT


MANUFACTURED TERMINAL SECTION (FLARED)  
 6+478.57 STA ~~6+479.0~~ ~ 6+490.4 RT  
 6+481.57 STA ~~6+482.0~~ ~ 6+493.0 LT  
 6+511.57 STA ~~6+512.0~~ ~ 6+523.0 LT  
 6+548.57 STA ~~6+548.6~~ ~ 6+560.0 RT

REMOVING SIGNS  
 AS SHOWN - 4 II

ERECTING SALVAGE SIGNS  
 8

TEMPORARY AND DURABLE 600 mm STOP BAR  
 STA 6+470 LT (TH #39)  
 STA 6+470 RT (TH #21)

TEMPORARY AND DURABLE LETTER OR SYMBOL  
 STA 6+470 LT - "STOP" (TH #39)  
 STA 6+470 RT - "STOP" (TH #21)

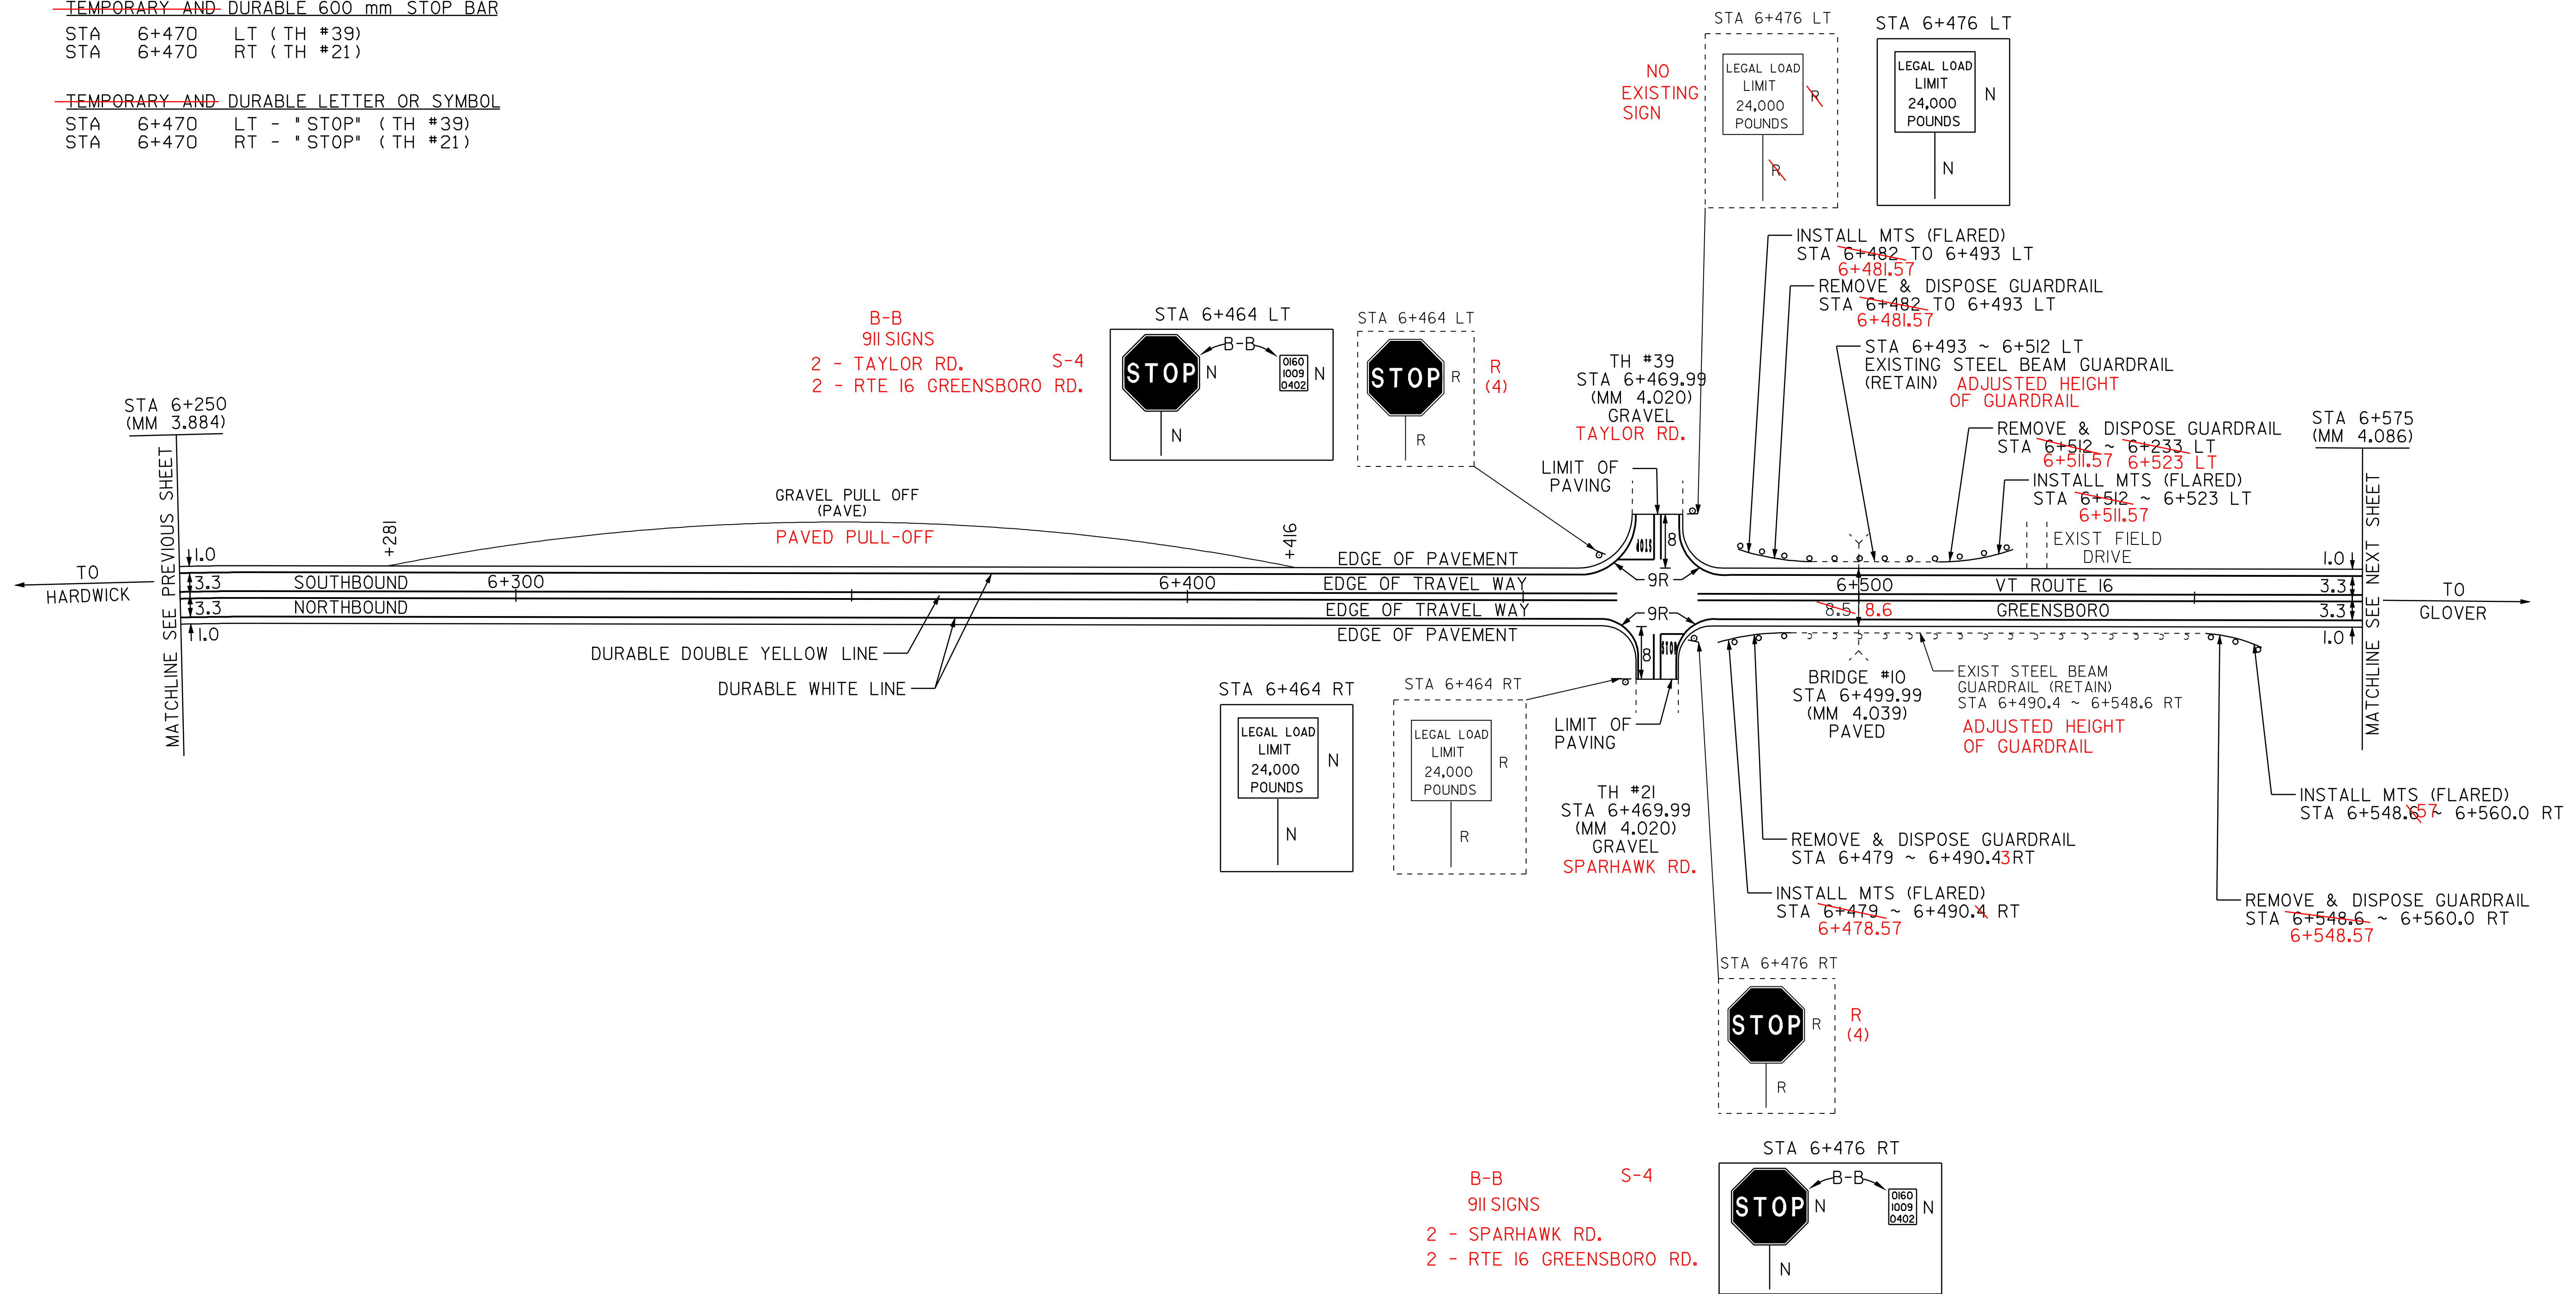

LEGEND

- R = REMOVE EXISTING
- S = SALVAGE
- R&S = REMOVE AND SALVAGE
- N = NEW
- RET = RETAIN
- B-B = BACK TO BACK
- = NEW RAIL
- = EXISTING RAIL
- ⊗ = BORING LOCATION

NOTE: ALL DIMENSIONS IN METERS EXCEPT AS INDICATED

DATUM	
VERTICAL	N/A
HORIZONTAL	N/A

NOT TO SCALE

<b>PAVING PROJECT LAYOUT #24</b>	PROJECT: HARDWICK-GREENSBORO	PROJECT NO.: STP 2112(1)S
	DESIGN FILE NAME: pave/98b106/pbl06.dgn	PLOT DATE: 10-JUL-2006 13:50
	IPARM FILE NAME: pbl061a24.i	SURVEY DATE: 6/99
	SURVEYED BY: CLD ENGINEERS, INC.	DRAWN BY: JPC
	SQUAD LEADER: WRH	SHEET: 33 OF 43