


TEMPORARY AND DURABLE 100 mm YELLOW LINE
 STA 6+575 TO ~~6+917~~ SOLID LT & RT
 6+933

TEMPORARY AND DURABLE 100 mm WHITE LINE
 STA 6+575 TO ~~6+917~~ SOLID LT & RT
 6+933

VT ROUTE 16
~~STA 6+917.00~~ 6+933.00
~~(MM 4.298)~~ 4.308
END PROJECT
STP 2112(1)S

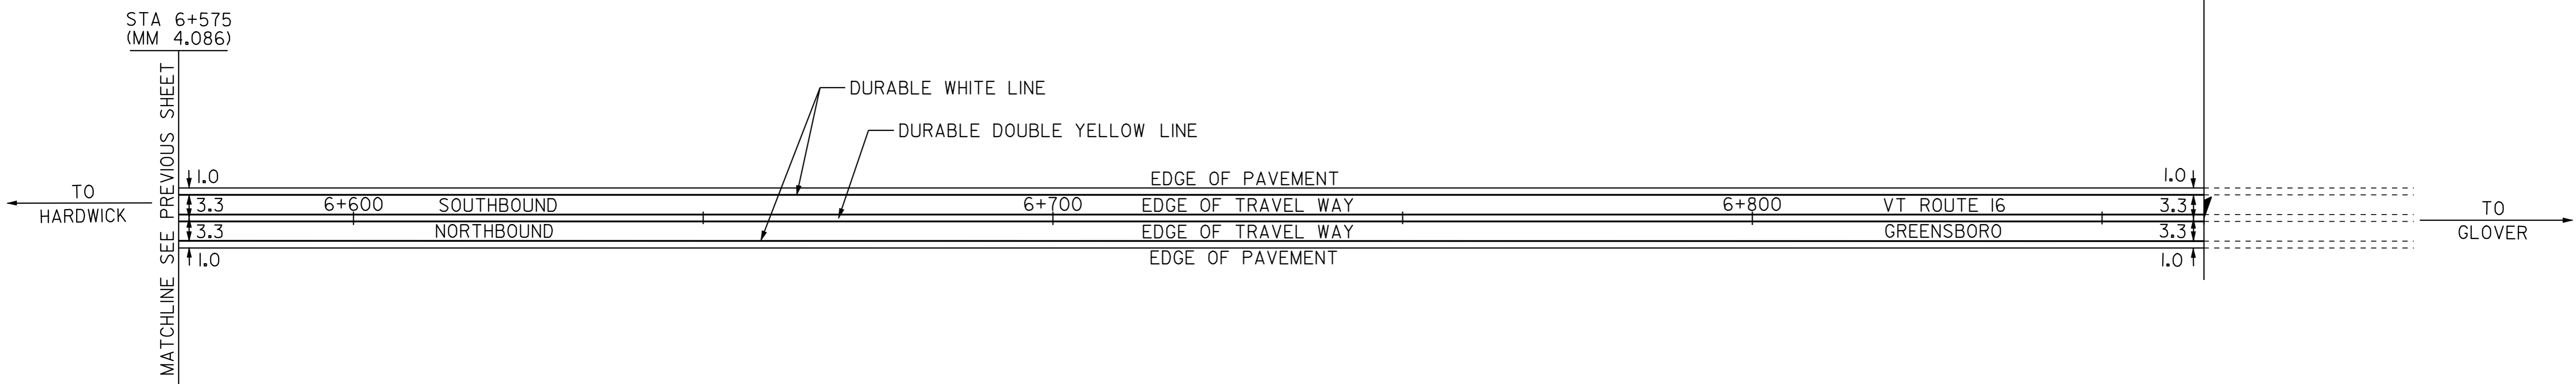

PAVEMENT CORES - ⊗

STA	TOTAL DEPTH (MM)	PCC
15 STA 6+759 RT	108	NO

- LEGEND**
- R = REMOVE EXISTING
 - S = SALVAGE
 - R&S = REMOVE AND SALVAGE
 - N = NEW
 - RET = RETAIN
 - B-B = BACK TO BACK
 - = NEW RAIL
 - = EXISTING RAIL
 - ⊗ = BORING LOCATION

NOTE: ALL DIMENSIONS IN METERS EXCEPT AS INDICATED

PAVING PROJECT LAYOUT #25

PROJECT: HARDWICK-GREENSBORO	PROJECT NO.: STP 2112(1)S
DESIGN FILE NAME: pave/98b106/pbl06.dgn	PLOT DATE: 10-JUL-2006 13
IPARM FILE NAME: pbl061a25.i	SURVEY DATE: 6/99
SURVEYED BY: CLD ENGINEERS, INC.	DRAWN BY: JPC
SQUAD LEADER: WRH	SHEET: 34 OF 43

DATUM

VERTICAL	N/A
HORIZONTAL	N/A

NOT TO SCALE