




**BRIDGE #2
HARDWICK
STA 3+766.41
(MM 2.340)**

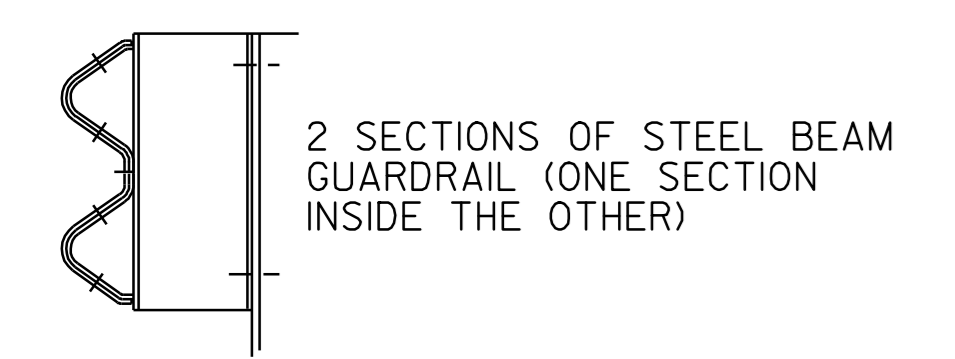

DETAIL A

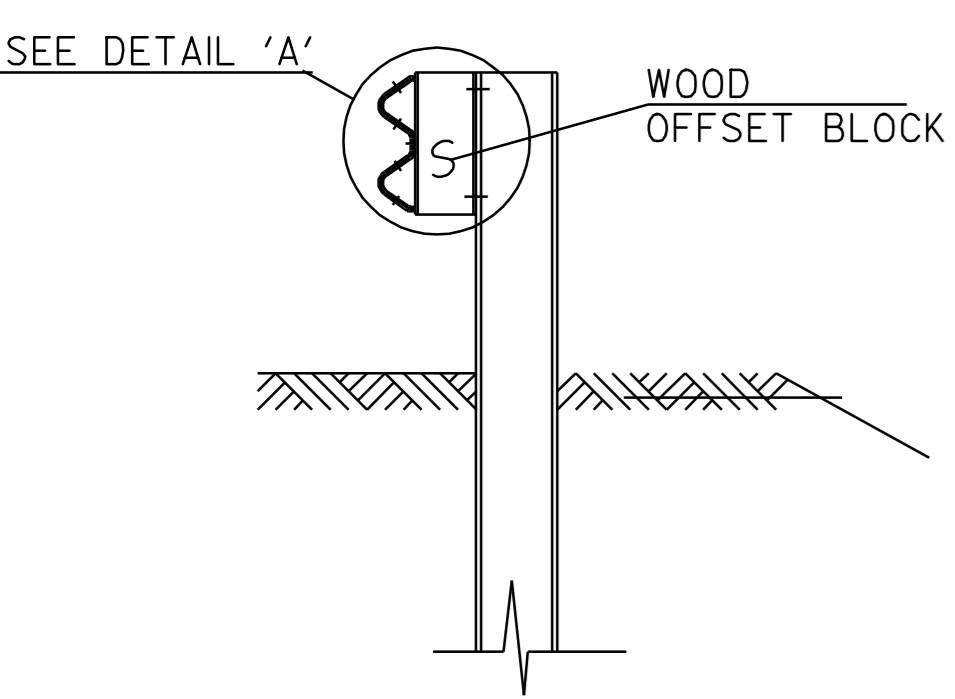

SECTION A-A
NOT TO SCALE

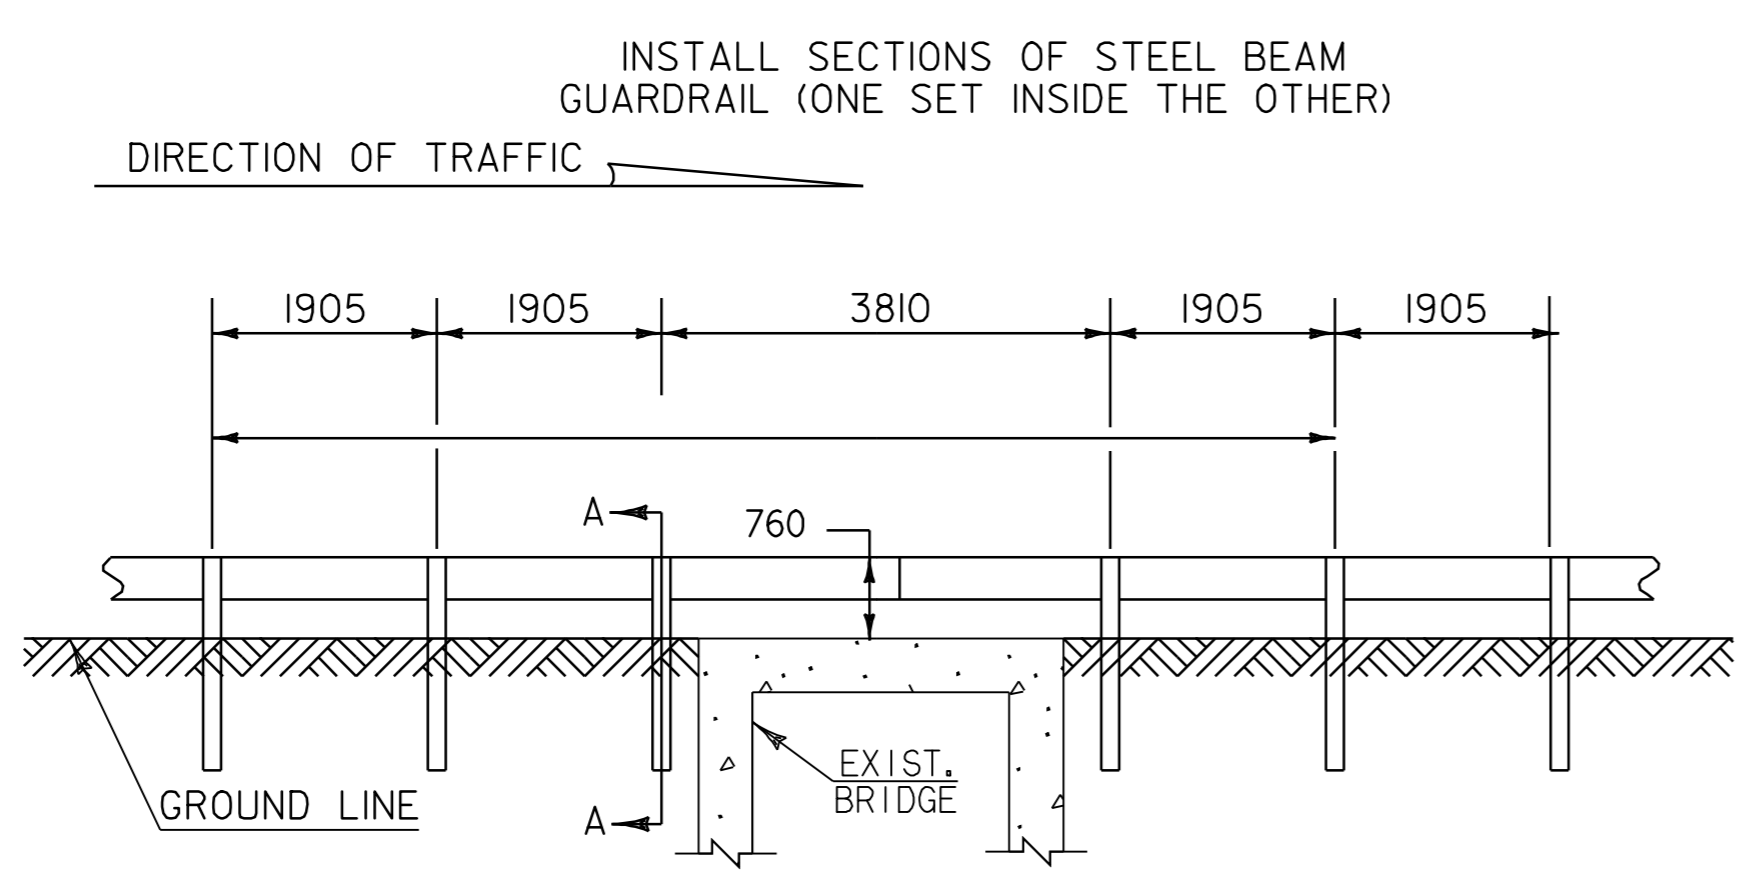


**DETAIL OF STEEL BEAM GUARDRAIL AT
BRIDGE #4 @ STA 1+362.76, GREENSBORO
(MM 0.847)**


NOTES

1. SEE STANDARD G-IM & G-IDM FOR STEEL BEAM GUARDRAIL DETAILS.
2. THIS DETAIL TO BE USED AS INDICATED ON THE ITEM DETAIL SHEET OR AS DIRECTED BY THE ENGINEER.
3. THIS WORK SHALL BE PAID FOR AS STEEL BEAM GUARDRAIL AT A PAY FACTOR OF 1.0.

NOT TO SCALE

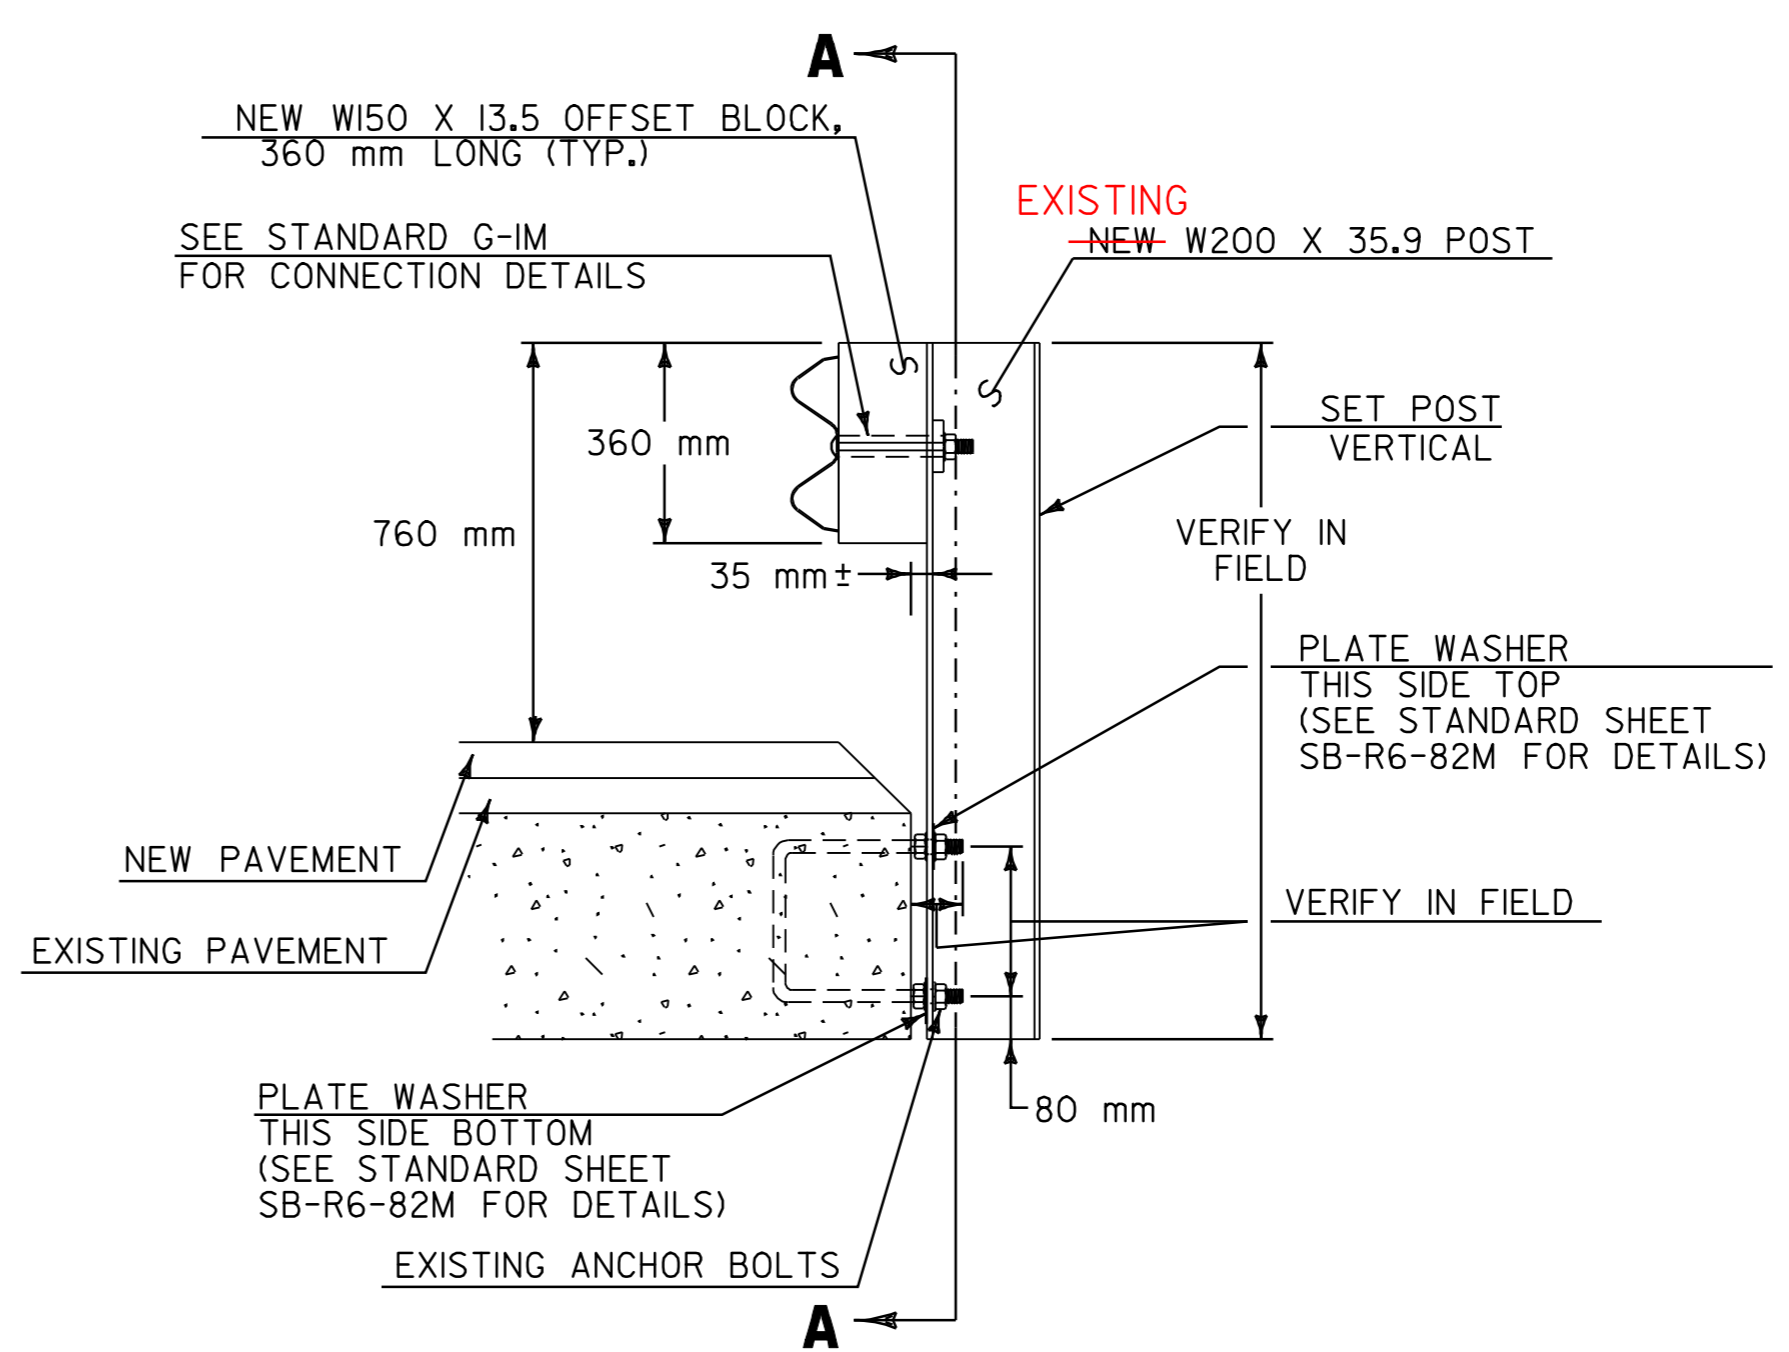

BR 2 BRIDGE POST DETAIL
NOT TO SCALE

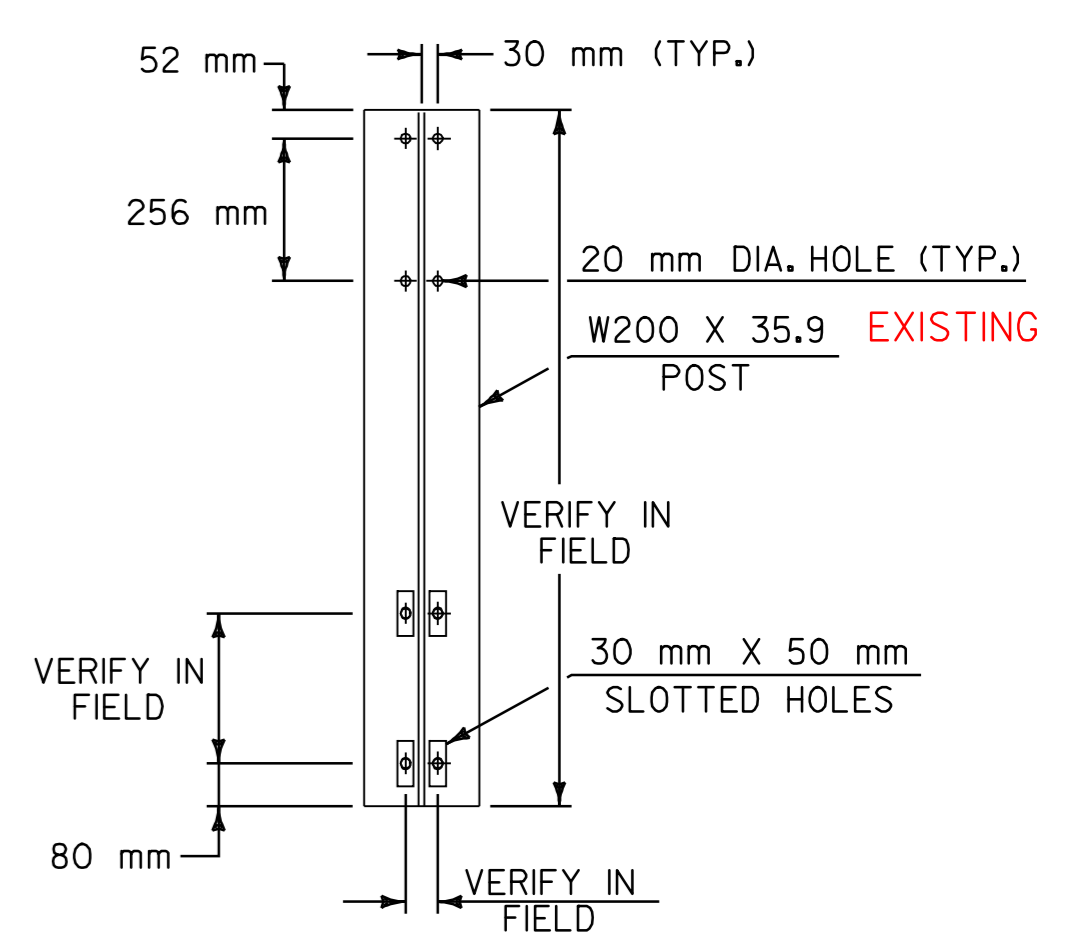

SECTION A-A

NOTE: ALL DIMENSIONS IN METERS EXCEPT AS INDICATED

**BRIDGE
DETAIL
SHEET #2**

PROJECT: HARDWICK - GREENSBORO	PROJECT NO.: STP 2112 (1)S
DESIGN FILE NAME: pave/98b106/pbl06.dgn	PLOT DATE: 10-JUL-2006 13
IPARM FILE NAME: pbl06d105.i	SURVEY DATE: 7/98
SURVEYED BY: CLD ENGINEERS, INC.	DRAWN BY: JPC
SQUAD LEADER: WRH	SHEET: 42 OF 43

DATUM	
VERTICAL	N/A
HORIZONTAL	N/A