




# Profile

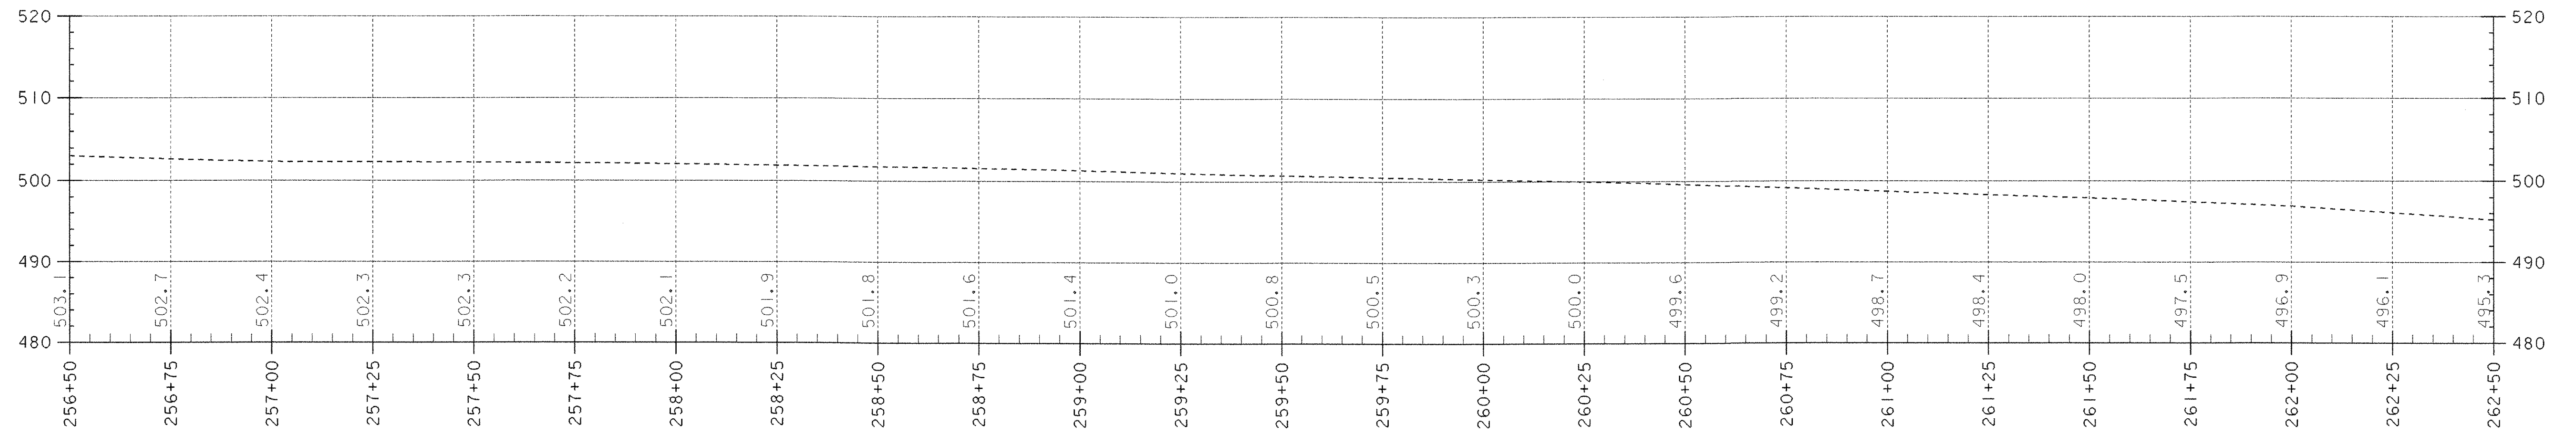

# Profile

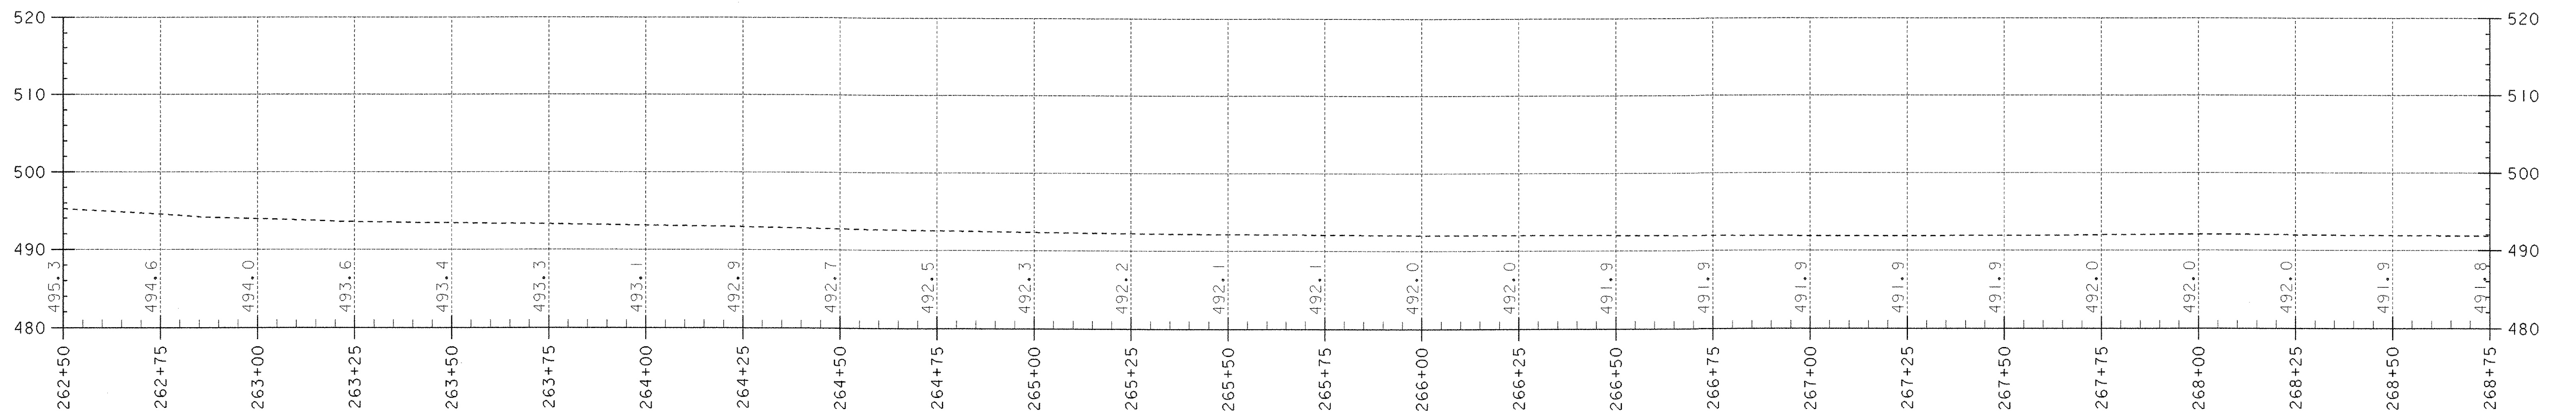

DATUM  
 VERTICAL NAVD 88  
 HORIZONTAL NAD 83 (96)

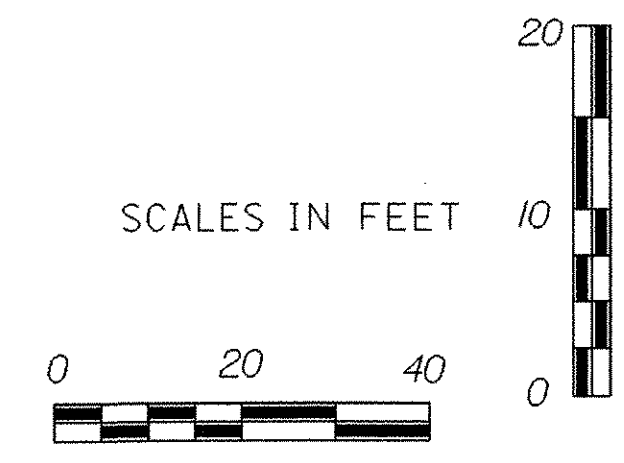

PROJECT: WELLS VT RTE. 30	PROJECT NO.: STP 015-2(7)S
DESIGN FILE NAME: /sqdb/98b160/db160wrk.dgn	PLOT DATE: 01-FEB-2006
IPARM FILE NAME: DB160P02.1	SURVEY DATE:
SURVEYED BY:	DRAWN BY: SODB
SQUAD LEADER: DELLA SANTA	SHEET: 10 OF 32
PROFILE SHEET 2	