
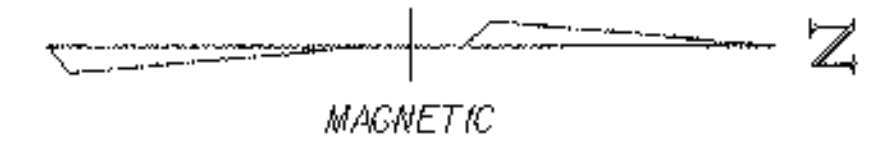



MISCELLANEOUS FENCE (MOD. - SEDIMENT LOG)
 STA. 255+39.75 RT - STA. 256+50.00 RT

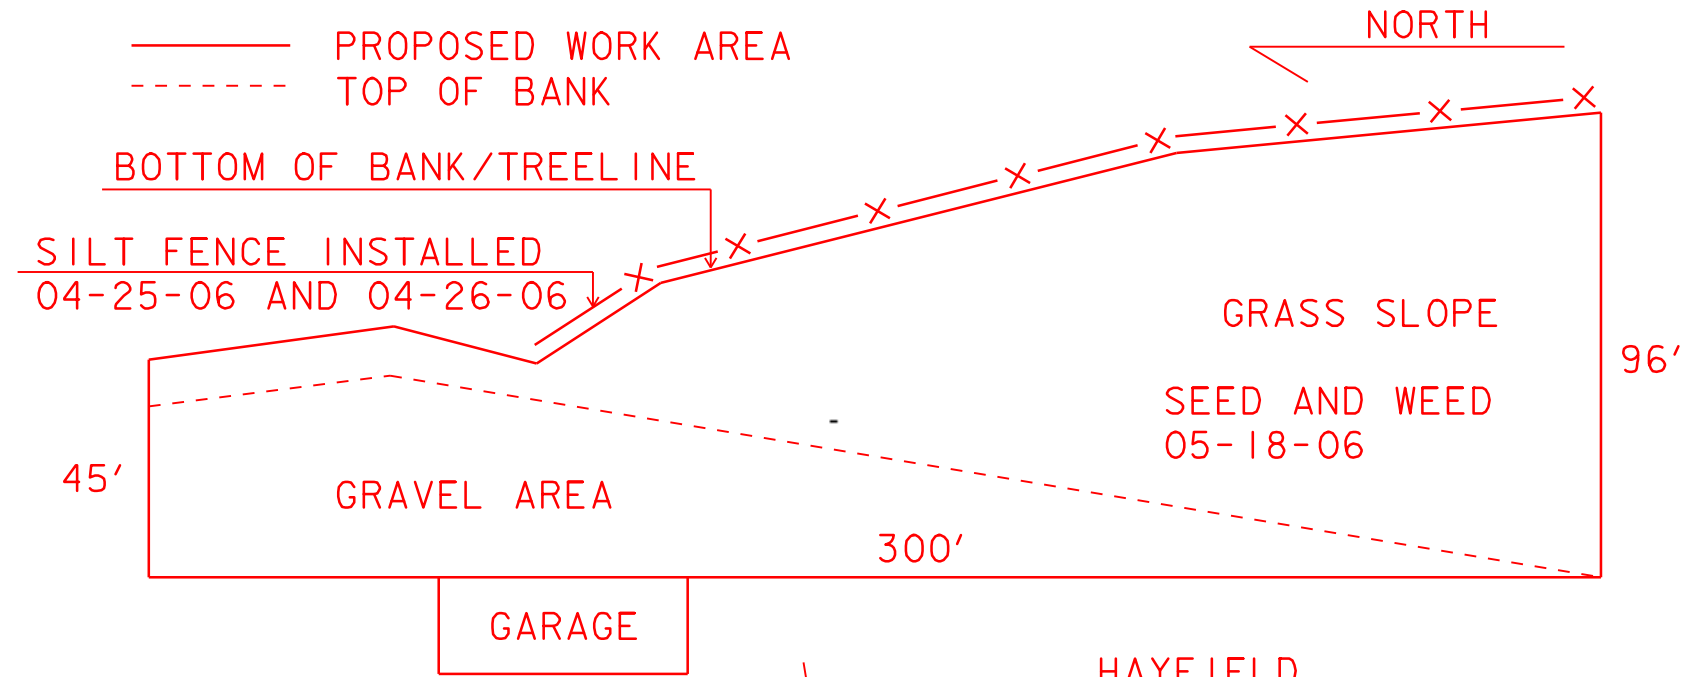

NOTES:
 -PROPOSED WASTE AREA: APPROXIMATELY 21,850 SF
 -NO EARTHWORK IS NECESSARY TO ACCESS THE AREA.
 -MATERIAL DELIVERED TO THIS AREA FROM 05-08-06 TO 05-15-06. TOWN SCREENING MATERIAL FOR THEIR FUTURE USE.

INSTALLED
 05-09-0
 255+00 TO 255+50

INSTALLED SEDIMENT LOG
 04-27-06
 255+50 TO 256+70

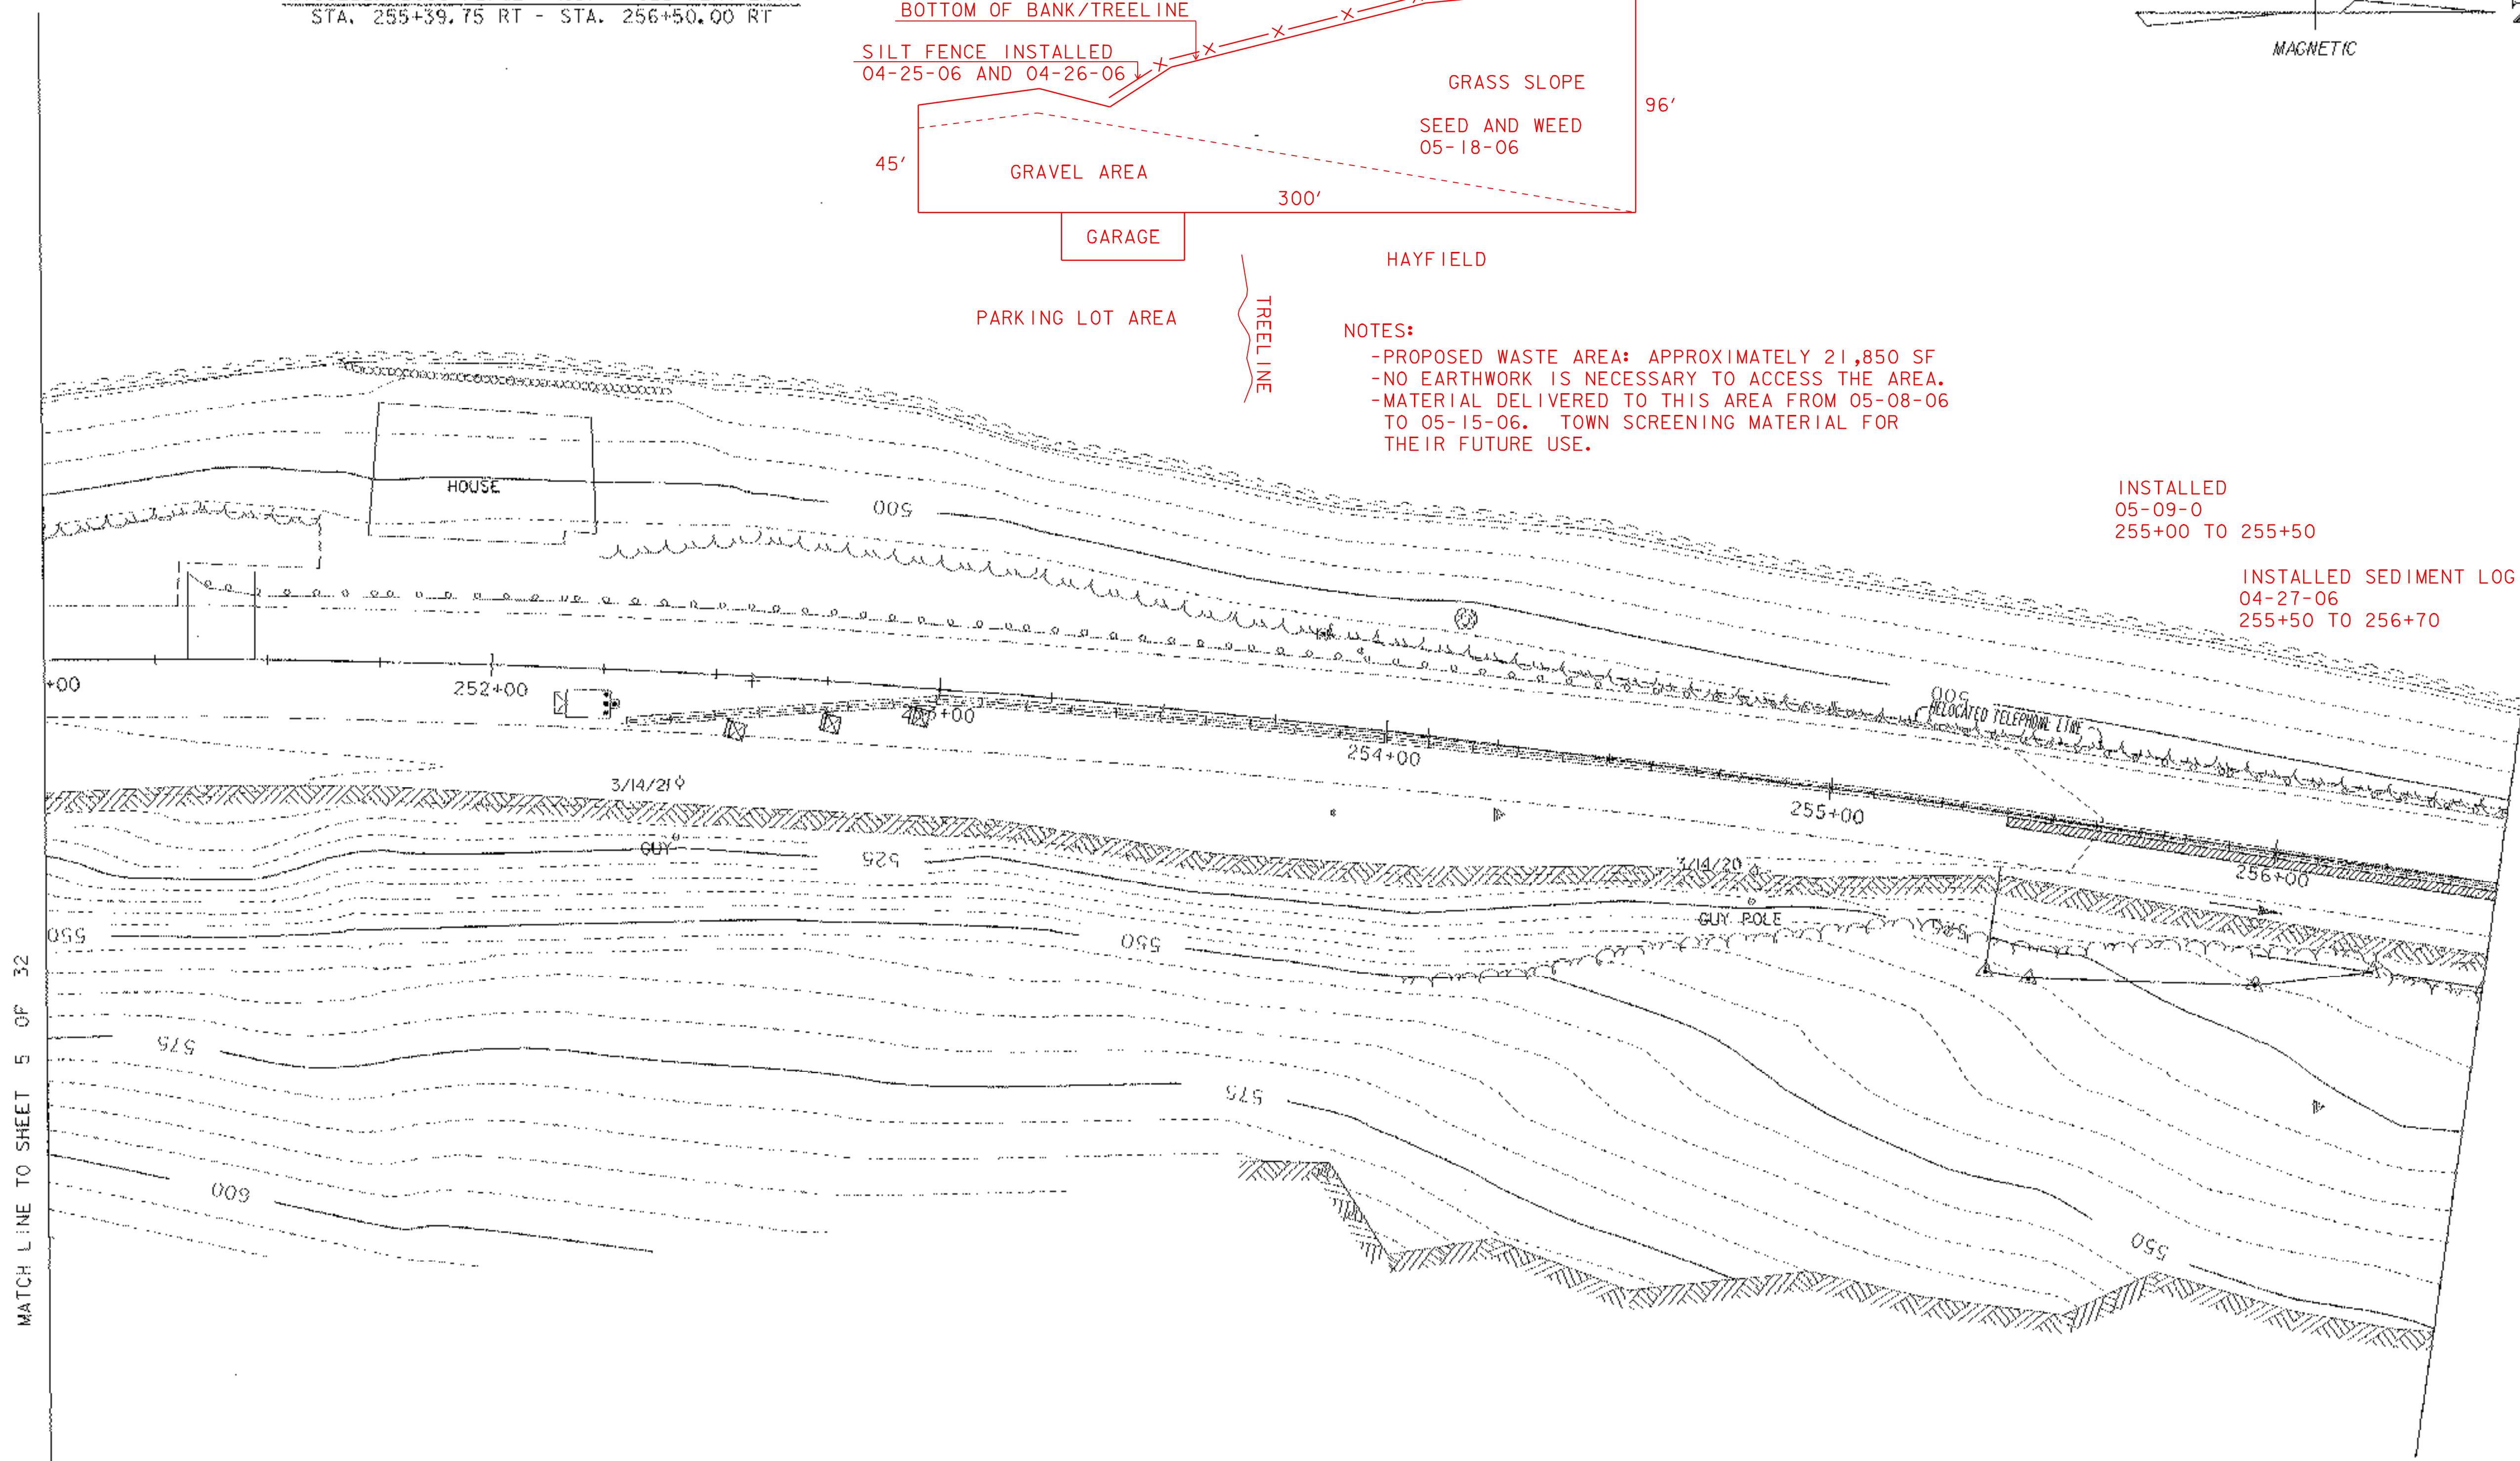


MATCH LINE TO SHEET 5 OF 32

MATCH LINE TO SHEET 14 OF 32

LEGEND	
	SEDIMENT LOG
	EROSION MATTING - DITCH
	STONE CHECK DAM

EROSION CONTROL NOTES:

1. SEDIMENT LOGS WILL BE USED WHEN NECESSARY ALONG THE BARRIER TO INHIBIT SEDIMENT TRANSPORT ACROSS THE ROAD.

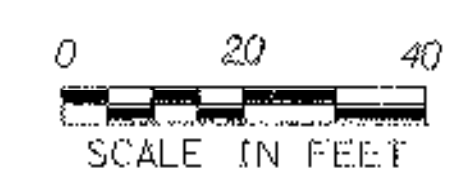

DATUM
 VERTICAL NAVD 88
 HORIZONTAL NAD 83 (96)

EROSION PREVENTION AND SEDIMENT CONTROL PLAN SHEET 1	
PROJECT: WELLS VT RTE 30	PROJECT NO. : STP 015-2(7)S
DESIGN FILE NAME: /sqdb/98b60/db60erobdr.dgn	PLOT DATE: 01-FEB-2006
IPARM FILE NAME: db60x02ero.1	SURVEY DATE:
SURVEYED BY:	DRAWN BY: T. GUAZZONI
SQUAD LEADER: DELLA SANTA	SHEET: 13 OF 32