

MISCELLANEOUS FENCE (MOD. - SEDIMENT LOG)  
STA. 256+50.00 RT - STA. 262+25.00 RT

STONE FILL TYPE I (MOD.) (STONE CHECK DAM)  
STA. 262+00.00 RT


EROSION MATTING (JUTE) (DITCH)  
STA. 261+25.00 RT - STA. 262+00.00 RT



PLACED SEDIMENT LOG  
ON 04-33-06  
STA. 256+70 TO 260+0

PLACED SEDIMENT LOG  
ON 04-25-06  
STA. 260+00 - 262+00

PLACED SEDIMENT LOG  
ON 05-12-06  
STA 262+00 - 262+50

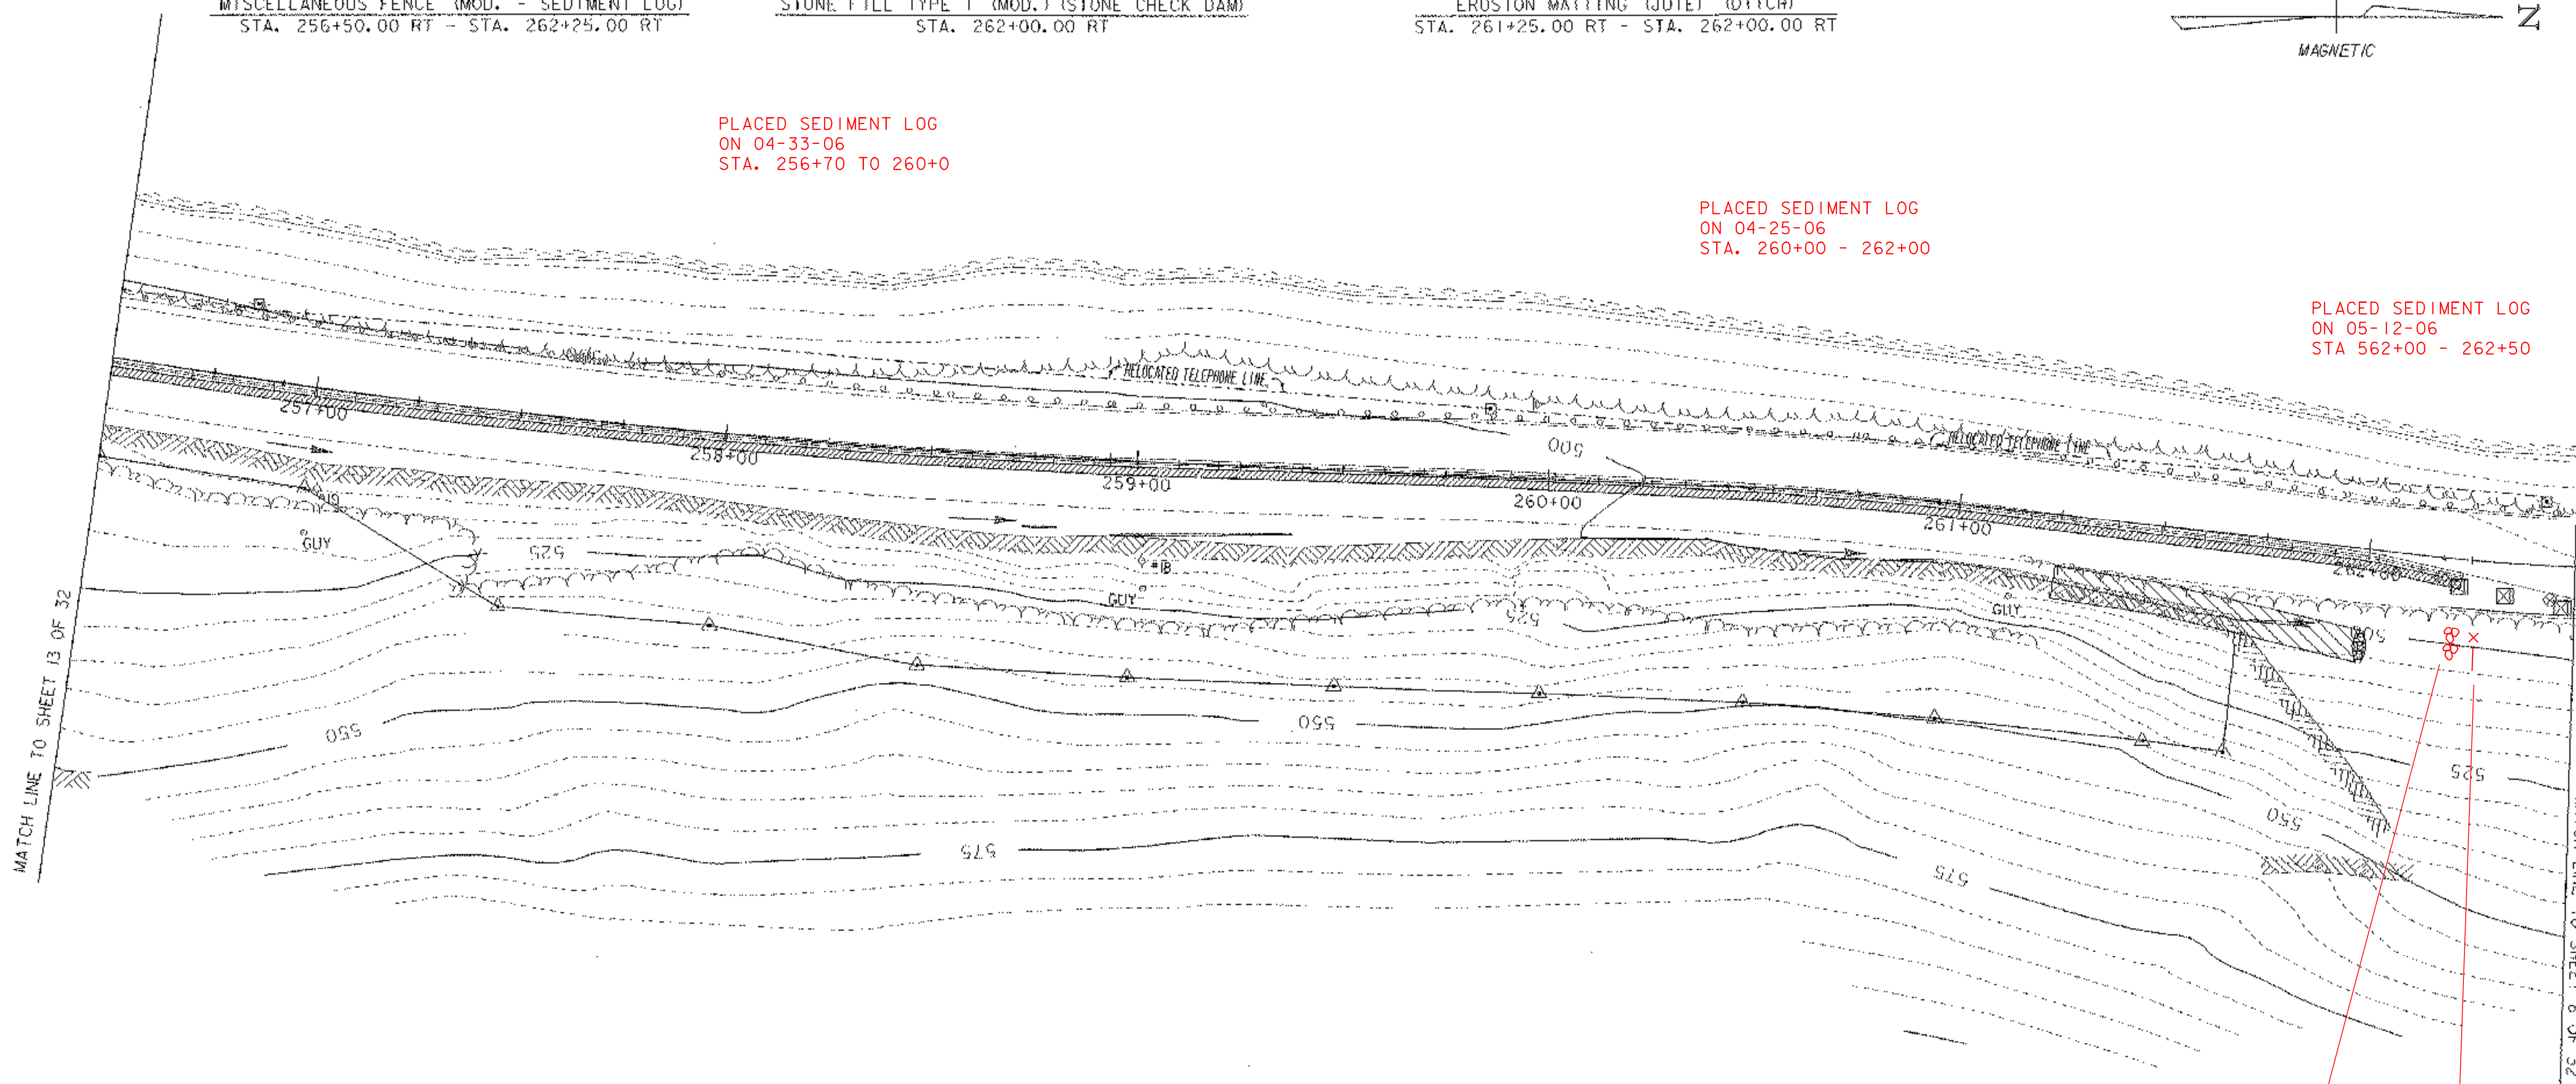


STA. 263+00  
PLACED 04-21-06

SILT FENCE  
STA. 263+14  
PLACED 04-21-06

LEGEND	
	SEDIMENT LOG
	EROSION MATTING - DITCH
	STONE CHECK DAM

**EROSION CONTROL NOTES:**

- SEDIMENT LOGS WILL BE USED WHEN NECESSARY ALONG THE BARRIER TO INHIBIT SEDIMENT TRANSPORT ACROSS THE ROAD.

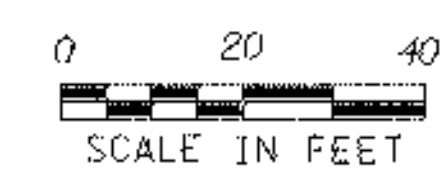

**DATUM**  
VERTICAL NAVD 88  
HORIZONTAL NAD 83 (96)

EROSION PREVENTION AND SEDIMENT CONTROL PLAN SHEET 2

PROJECT: WELLS VT RTE. 30	PROJECT NO.: STP 015-2(7)S
DESIGN FILE NAME: /sqdb/98b160/db160erobdr.dgn	PLOT DATE: 01-FEB-2006
IPARM FILE NAME: db160i3ero.f	SURVEY DATE:
SURVEYED BY:	DRAWN BY: T. GUAZZONI
SQUAD LEADER: DELLA SANTA	SHEET: 14 OF 32