


BEGIN EXCAVATION STA. 255+40RT.

255+40

THE LEDGE LINE IS THE MAXIMUM PROPOSED LIMIT AND DOES NOT DEPICT THE EXPECTED LIMITS OF LEDGE ACTUALLY REMOVED.

DATUM
 VERTICAL _____
 HORIZONTAL _____

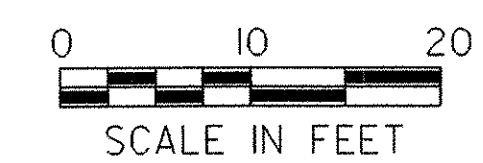

PROJECT: WELLS VT RTE. 30	PROJECT NO.: STP 015-2(7)S
DESIGN FILE NAME: /sqdb/98bl60/dbl60wrk.dgn	PLOT DATE: 01-FEB-2006
IPARM FILE NAME: dbl60xsl	SURVEY DATE:
SURVEYED BY:	DRAWN BY: A. JONES
SQUAD LEADER: DELLA SANTA	SHEET: 17 OF 32
CROSS SECTION SHEET 1	