


THE LEDGE LINE IS THE MAXIMUM PROPOSED LIMIT AND DOES NOT DEPICT THE EXPECTED LIMITS OF LEDGE ACTUALLY REMOVED.

DATUM	
VERTICAL	NAVD 88
HORIZONTAL	NAD 83 (96)

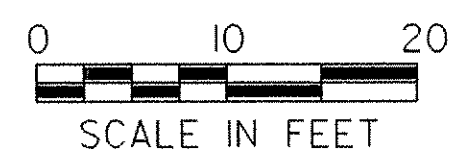

PROJECT: WELLS VT RTE. 30	PROJECT NO.: STP 015-2(7)S
DESIGN FILE NAME: /sqdb/98bi60/dbi60wrk.dgn	PLOT DATE: 01-FEB-2006
IPARM FILE NAME: dbi60xs2.i	SURVEY DATE:
SURVEYED BY:	DRAWN BY: A.JONES
SQUAD LEADER: DELLA SANTA	SHEET: 18 OF 32
CROSS SECTION SHEET 2	