


THE LEDGE LINE IS  
 THE MAXIMUM PROPOSED  
 LIMIT AND DOES NOT  
 DEPICT THE EXPECTED  
 LIMITS OF LEDGE  
 ACTUALLY REMOVED.

**DATUM**  
 VERTICAL NAVD 88  
 HORIZONTAL NAD 83 (96)

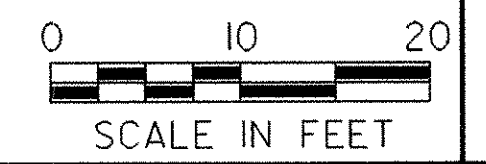

PROJECT: <b>WELLS VT RTE. 30</b>	PROJECT NO.: <b>STP 015-2(7)S</b>
DESIGN FILE NAME: /sqdb/98b160/db160wrk.dgn	PLOT DATE: 01-FEB-2006
IPARM FILE NAME: db160xs5.1	SURVEY DATE:
SURVEYED BY:	DRAWN BY: A.JONES
SQUAD LEADER: DELLA SANTA	SHEET: 21 OF 32
CROSS SECTION SHEET 5	