


DATUM
 VERTICAL NAVD 88
 HORIZONTAL NAD 83 (96)

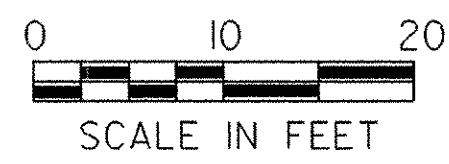

PROJECT: WELLS VT RTE. 30	PROJECT NO.: STP 015-2(7)S
DESIGN FILE NAME: /sqdb/98bl60/dbl60wrk.dgn	PLOT DATE: 01-FEB-2006
IPARM FILE NAME: db160xsl0.1	SURVEY DATE:
SURVEYED BY:	DRAWN BY: A.JONES
SQUAD LEADER: DELLA SANTA	SHEET: 26 OF 32
CROSS SECTION SHEET 10	