


260+00

DATUM
 VERTICAL NAVD 88
 HORIZONTAL NAD 83 (96)

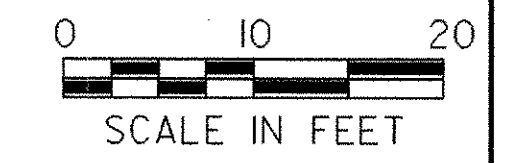

THE LEDGE LINE IS
 THE MAXIMUM PROPOSED
 LIMIT AND DOES NOT
 DEPICT THE EXPECTED
 LIMITS OF LEDGE
 ACTUALLY REMOVED.

PROJECT: WELLS VT RTE. 30	PROJECT NO.: STP 015-2(7)S
DESIGN FILE NAME: /sqdb/98b160/db160wrk.dgn	PLOT DATE: 01-FEB-2006
IPARM FILE NAME: db160xsl.i	SURVEYED BY:
SQUAD LEADER: DELLA SANTA	DRAWN BY: A. JONES
CROSS SECTION SHEET II	SHEET: 27 OF 32