


DATUM
 VERTICAL NAVD 88
 HORIZONTAL NAD 83 (96)

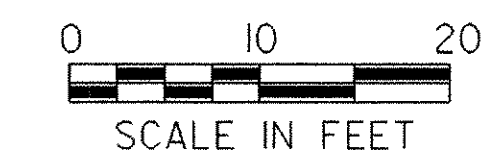

| | |
|---|---------------------------------------|
| PROJECT: WELLS VT RTE. 30 | PROJECT NO.: STP- 015-2(7)S |
| DESIGN FILE NAME: /sqdb/98bi60/dbi60wrk.dgn | PLOT DATE: 01-FEB-2006 |
| IPARM FILE NAME: dbi60xsl2.i | SURVEYED BY: |
| SQUAD LEADER: DELLA SANTA | DRAWN BY: A.JONES |
| CROSS SECTION SHEET 12 | SHEET: 28 OF 32 |