


DATUM
 VERTICAL _____
 HORIZONTAL _____

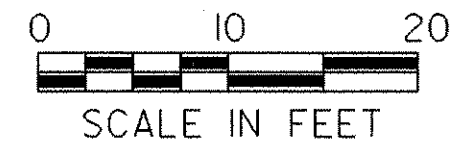

THE LEDGE LINE IS
 THE MAXIMUM PROPOSED
 LIMIT AND DOES NOT
 DEPICT THE EXPECTED
 LIMITS OF LEDGE
 ACTUALLY REMOVED.

PROJECT: WELLS VT RTE. 30	PROJECT NO.: STP 015-2(7)S
DESIGN FILE NAME: /sqdb/98bl60/dbl60wrk.dgn	PLOT DATE: 01-FEB-2006
IPARM FILE NAME: dbl60xsl4.i	SURVEY DATE:
SURVEYED BY:	DRAWN BY: S0DB
SQUAD LEADER: DELLA SANTA	SHEET: 30 OF 32
CROSS SECTION SHEET 14	