

TEMPORARY AND DURABLE 100mm YELLOW LINE

STA. 0+000.00 TO STA. 0+210.0 SOLID LT. AND RT.  
(WITH CENTERLINE BREAK FOR SIDE ROAD)  
STA. 0+048 RT. (MASON HILL ROAD)

TEMPORARY AND DURABLE 100mm WHITE LINE

STA. 0+000.00 TO STA. 0+210.0 SOLID LT. AND RT. (EDGE LINE)  
(WITH EDGE LINE BREAK FOR SIDE ROAD)

TEMPORARY AND DURABLE LETTER OR SYMBOL

STA. 0+048 RT. - "STOP" (MASON HILL ROAD)

REMOVING SIGNS

|| +2 -- AS SHOWN



SHOULDER BERM REMOVAL

STA. 0+000 LT. TO STA. 0+210 LT.  
~~STA. 0+005 RT. TO STA. 0+015 RT.~~

TEMPORARY AND DURABLE 600mm STOP BAR

STA. 0+048 RT. (MASON HILL ROAD)

REHABILITATION OF DI, CB, OR MH, CLASS I

STA. 0+010 LT.  
STA. 0+160 RT.

REMOVAL AND DISPOSAL OF GUARDRAIL

STA. 0+005 RT. TO STA. 0+41.6 RT.

STEEL BEAM GUARDRAIL


STA. 0+005 RT. TO STA. 0+41.6 RT.

DURABLE 100mm YELLOW LINE (POLYUREA)

STA. 0+000 TO STA. 0+210 (LT & RT)

DURABLE 100mm WHITE LINE (POLYUREA)

STA. 0+000 TO STA. 0+210 (EDGE LINE)

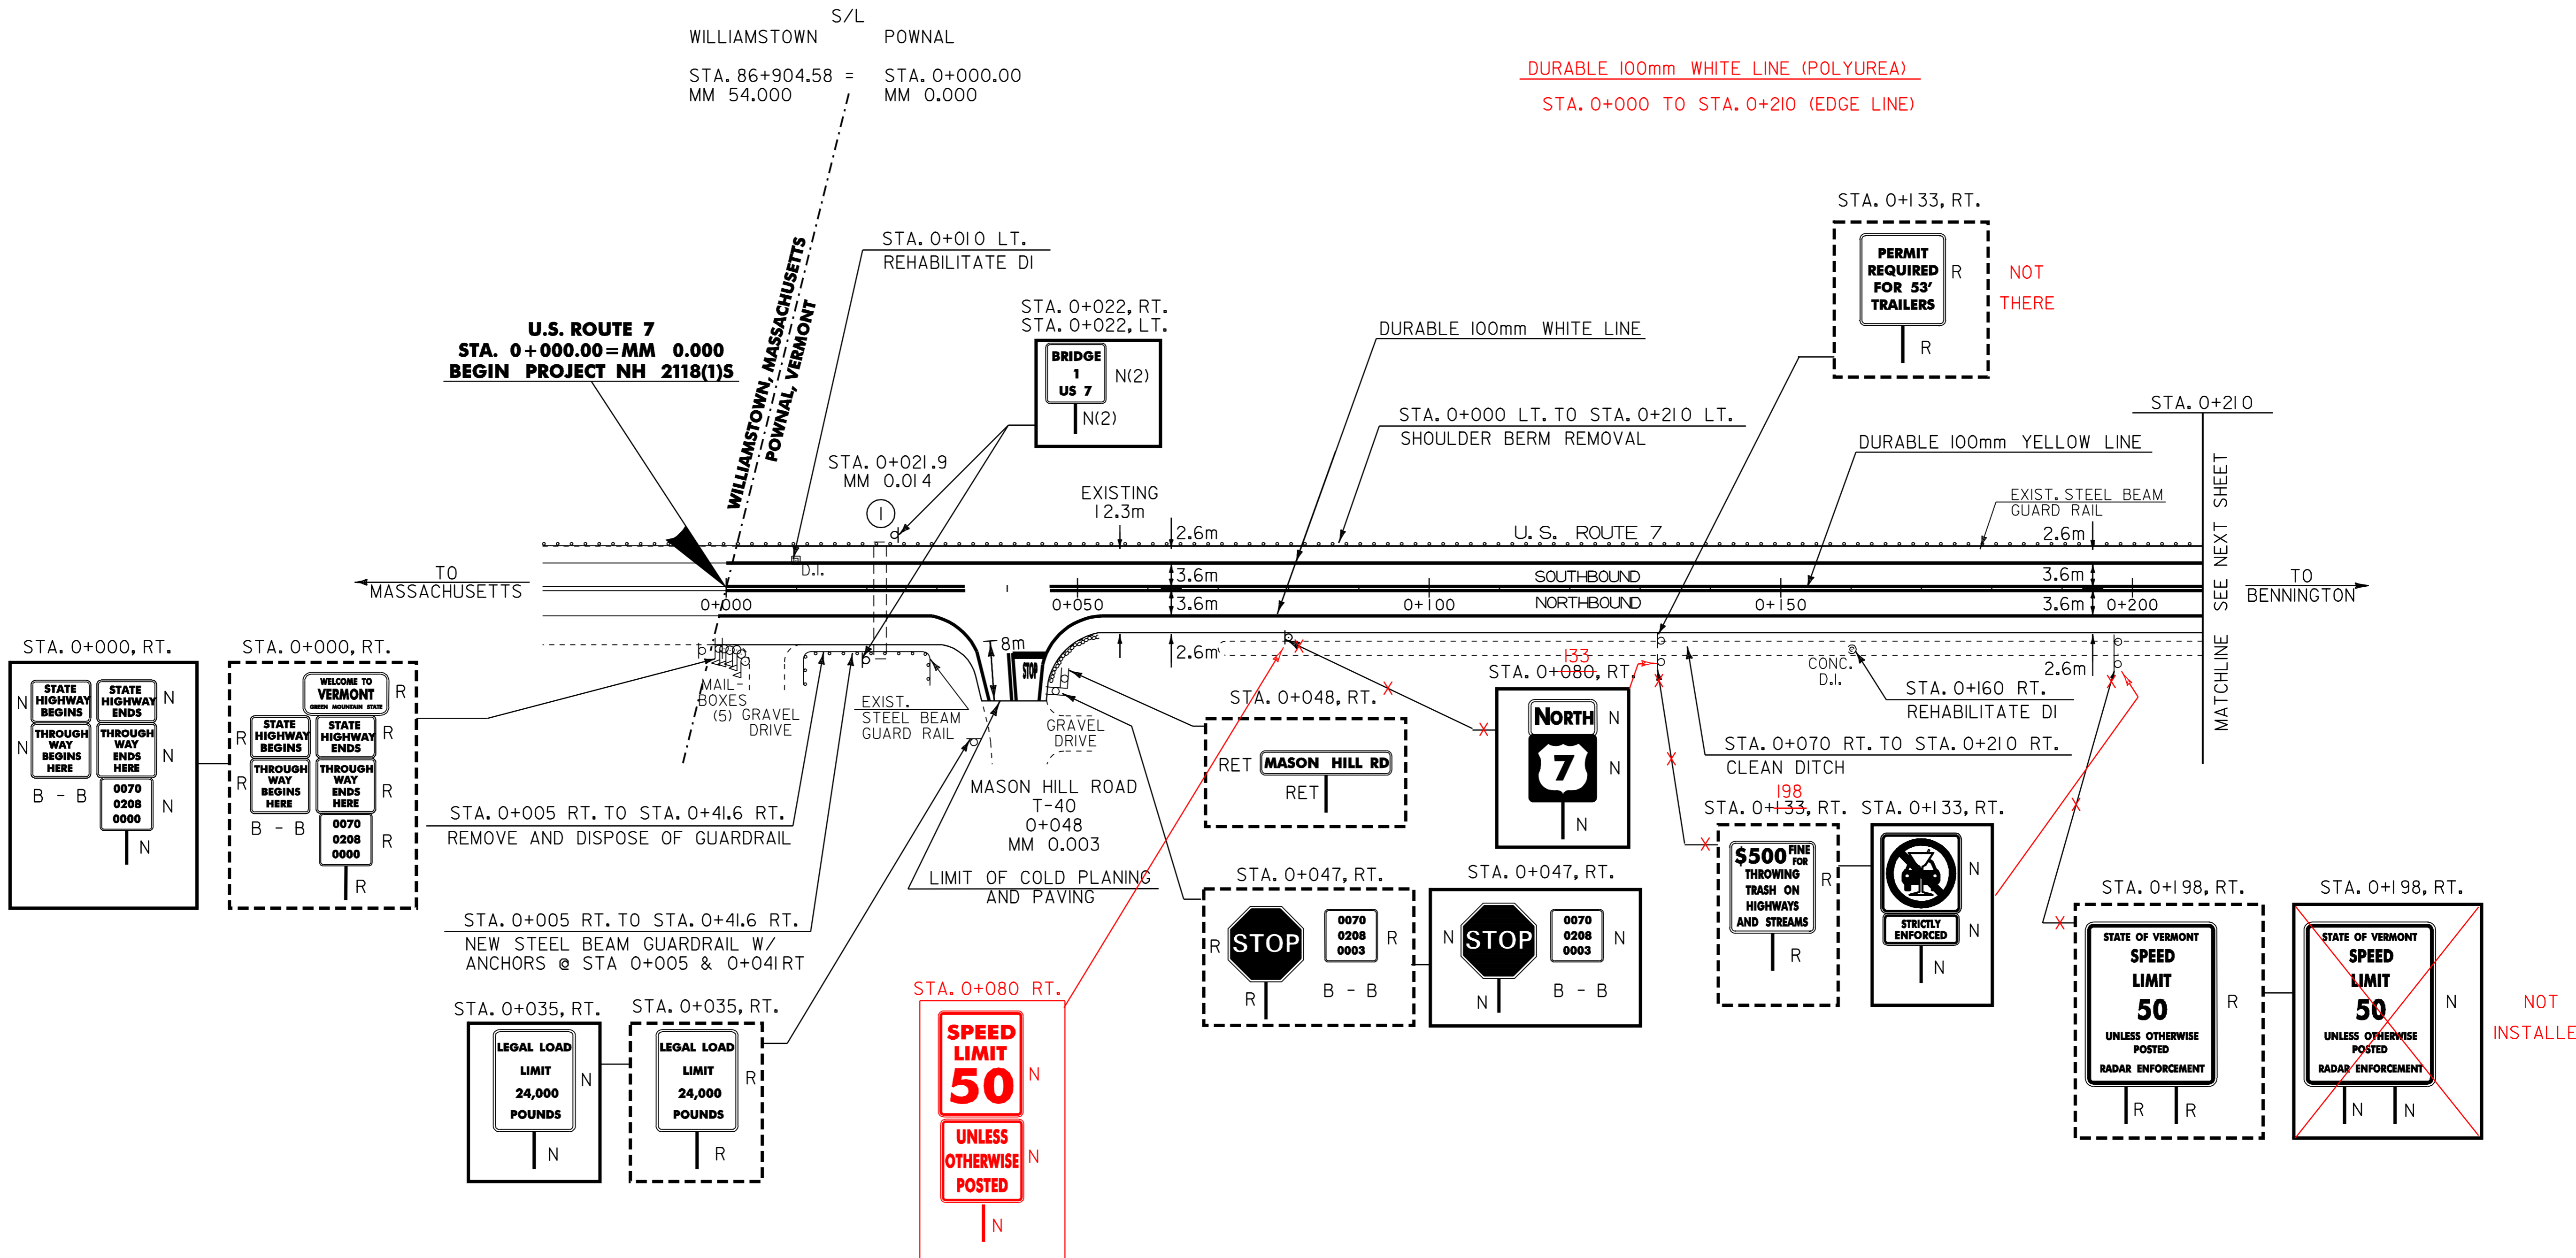

LEGEND  
 N = NEW  
 R = REMOVE  
 R & S = REMOVE AND SALVAGE  
 S = SALVAGE SIGN  
 RET = RETAIN  
 B - B = BACK TO BACK

<b>PAVING PROJECT LAYOUT #1</b>	PROJECT: POWNAL-BENNINGTON	PROJECT NO.: NH 2118(I)S
	DESIGN FILE NAME: /pave/98bl68/pbl68.dgn	PLOT DATE: 17-JAN-2006 14
	IPARM FILE NAME: pbl68I01.I	SURVEY DATE:
	SURVEYED BY: ACT, SJL, RAL	DRAWN BY: ACT
	SQUAD LEADER: JAV	SHEET: 9 OF 65

DATUM  
 VERTICAL N/A  
 HORIZONTAL N/A