

TEMPORARY AND DURABLE 100mm YELLOW LINE
STA. 0+210.00 TO STA. 0+690.0 SOLID LT. AND RT.

REHABILITATION OF DI, CB, OR MH, CLASS I
STA. 0+300 RT.

REMOVAL AND DISPOSAL OF GUARD RAIL
STA. 0+404.6 LT. TO STA. 0+416.0 LT.

REMOVING SIGNS
5-6 -- AS SHOWN

TEMPORARY AND DURABLE 100mm WHITE LINE
STA. 0+210.00 TO STA. 0+690.0 SOLID LT. AND RT. (EDGE LINE)


MANUFACTURED TERMINAL SECTION (FLARED)
STA. 0+404.6 LT. TO STA. 0+416.0 LT.

SHOULDER BERM REMOVAL
STA. 0+210 LT. TO STA. 0+405 LT.

THINNING AND TRIMMING FOR SIGNS
STA. 0+539.0 RT.

DURABLE 100MM YELLOW LINE (POLYUREA)
STA. 0+210 TO STA. 0+690 (LT & RT)

DURABLE 100MM WHITE LINE (POLYUREA)
STA. 0+210 TO STA. 0+690 (EDGE LINE)

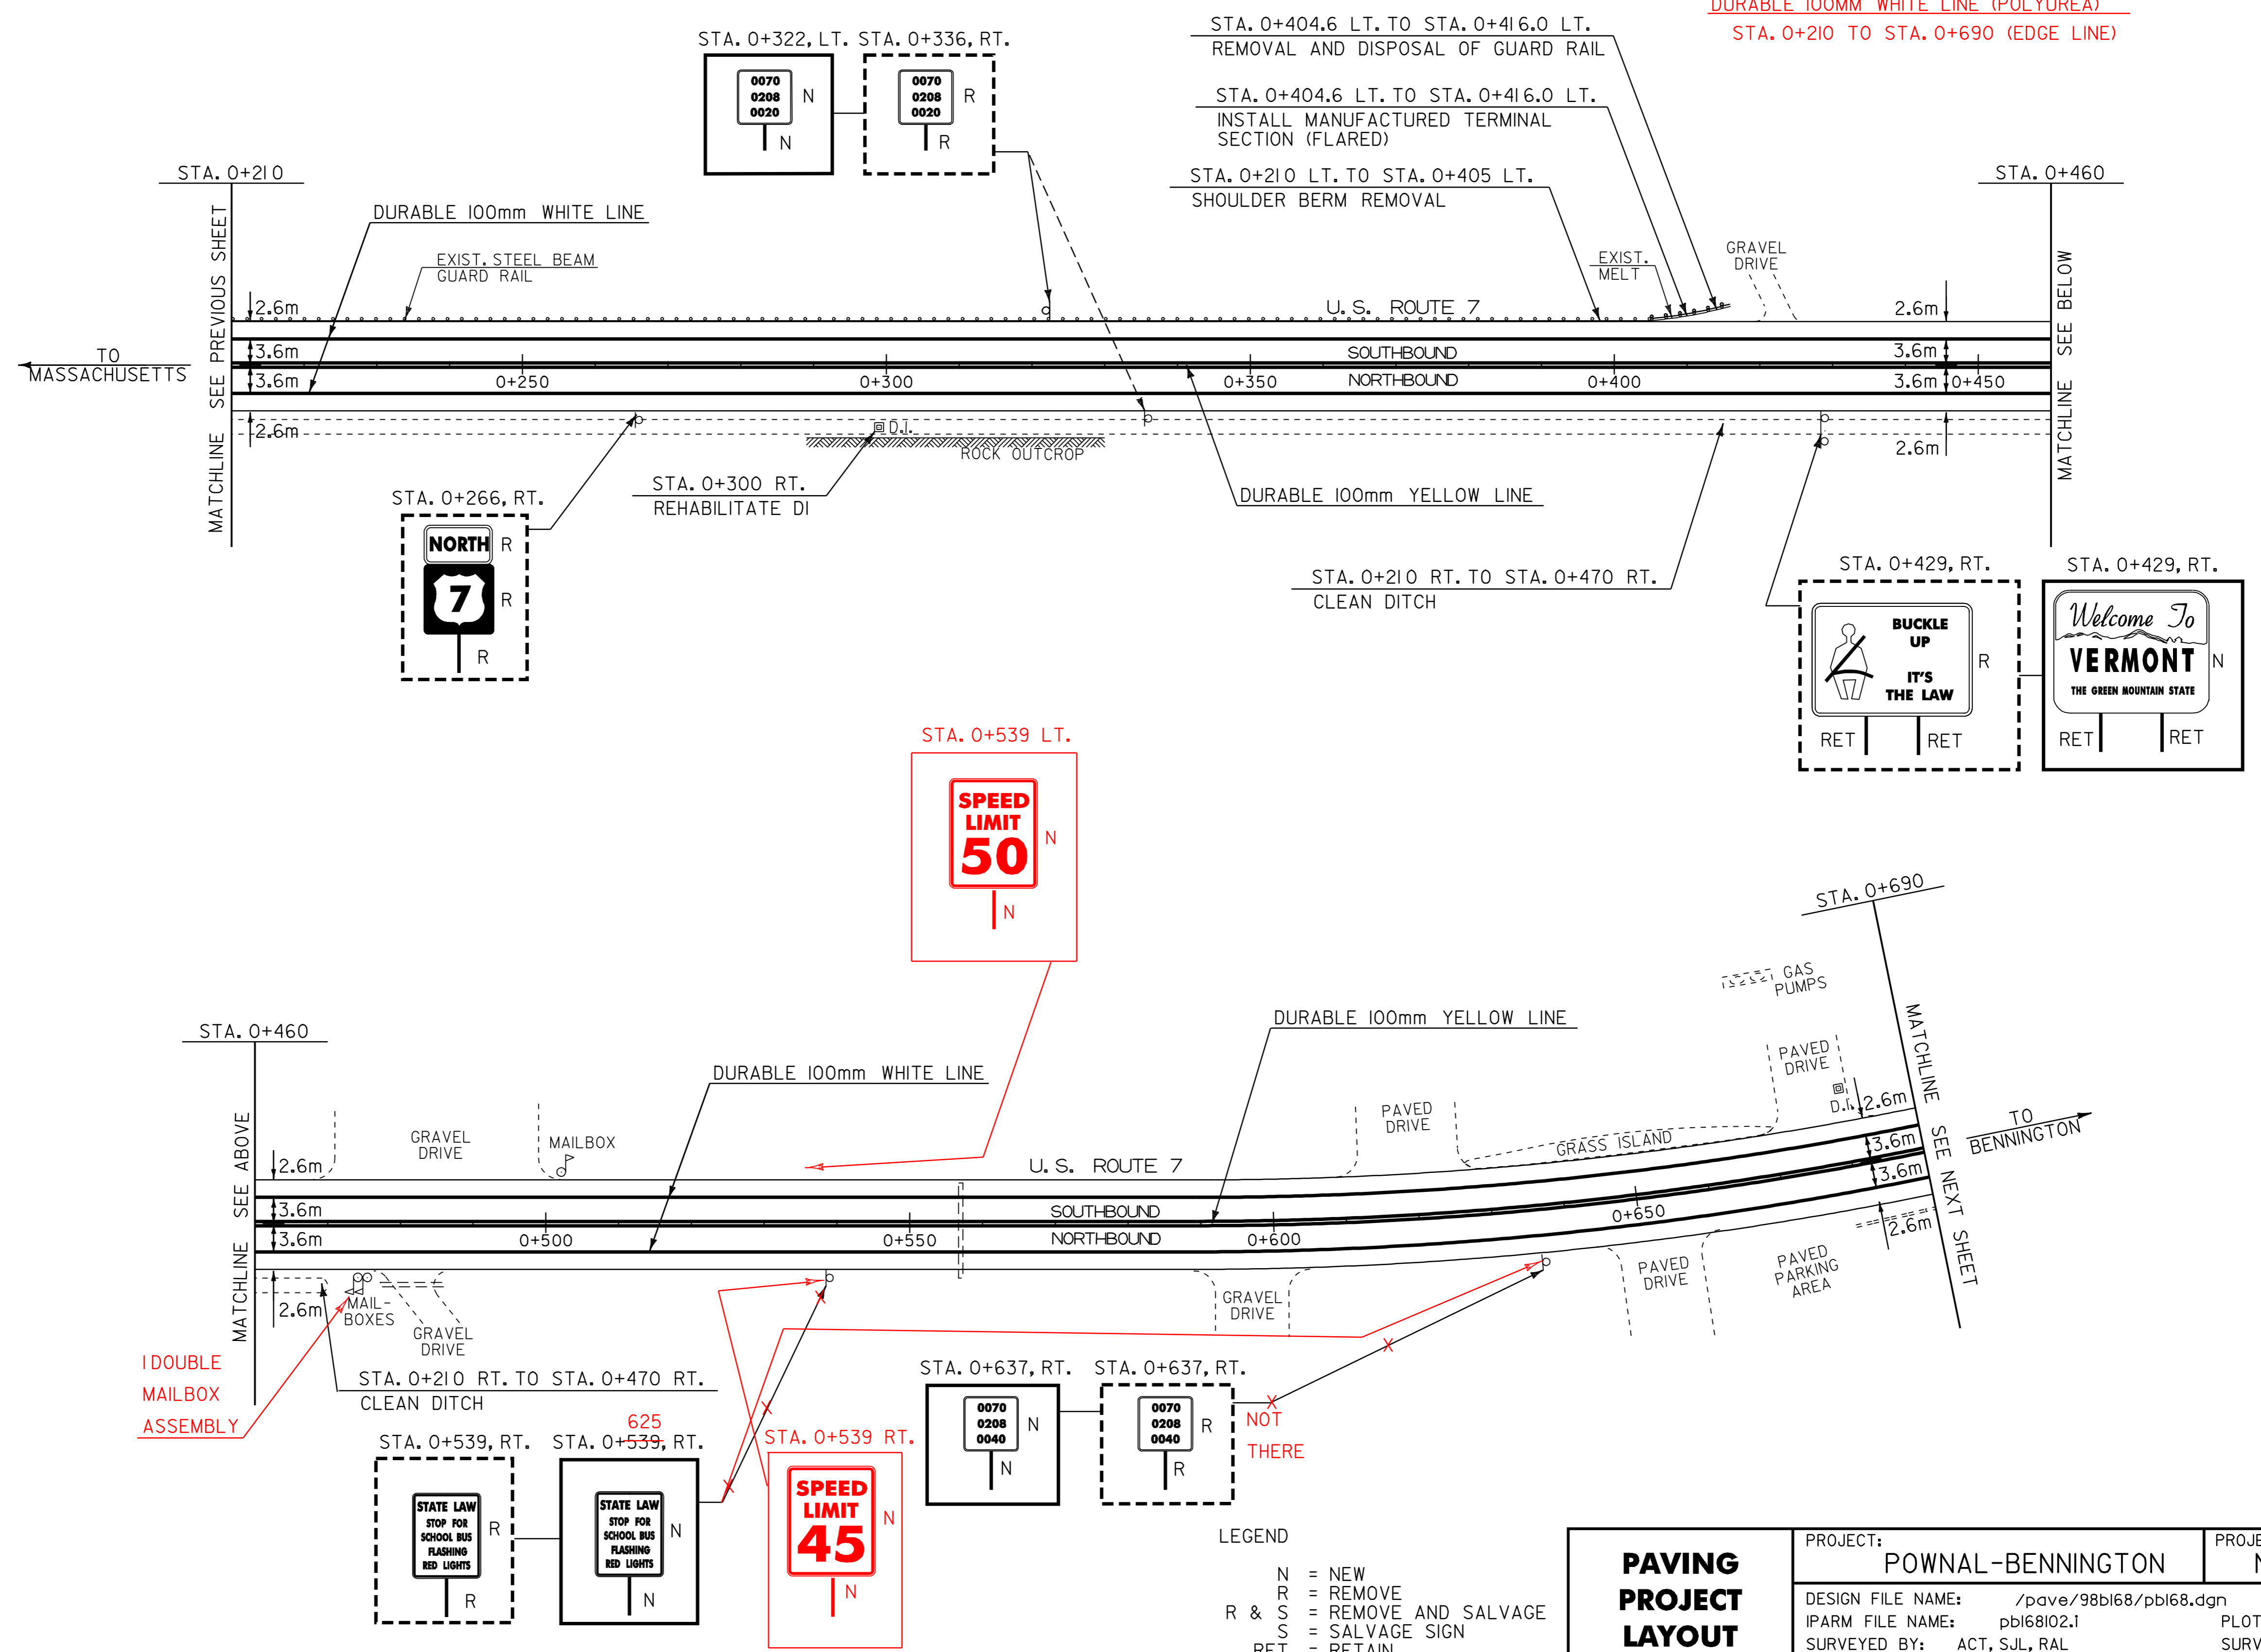

- LEGEND
- N = NEW
 - R = REMOVE
 - R & S = REMOVE AND SALVAGE
 - S = SALVAGE SIGN
 - RET = RETAIN
 - B - B = BACK TO BACK

PAVING PROJECT LAYOUT #2

PROJECT: POWNAL-BENNINGTON	PROJECT NO.: NH 2118(I)S
DESIGN FILE NAME: /pave/98bl68/pbl68.dgn	PLOT DATE: 17-JAN-2006 14
IPARM FILE NAME: pbl68102.1	SURVEY DATE:
SURVEYED BY: ACT, SJL, RAL	DRAWN BY: ACT
SQUAD LEADER: JAV	SHEET: 10 OF 65

DATUM	
VERTICAL	N/A
HORIZONTAL	N/A