

TEMPORARY AND DURABLE 100mm YELLOW LINE

STA. 1+730.0 TO STA. 1+749.4 SOLID DOUBLE LT. AND RT.
STA. 1+749.4 TO STA. 2+430.0 SOLID LT. AND RT.

SHOULDER BERM REMOVAL

~~STA. 1+730 LT. TO STA. 2+135 LT.~~

MANUFACTURED TERMINAL SECTION (FLARED)

STA. 2+134.6 LT. TO STA. 2+146.0 LT.

REMOVING SIGNS

9 +- -- AS SHOWN

TEMPORARY AND DURABLE 100mm WHITE LINE

STA. 1+730.0 TO STA. 2+430.0 SOLID LT. AND RT. (EDGE LINE)

REHABILITATION OF DI, CB, OR MH, CLASS I

STA. 1+878 RT.

REMOVAL AND DISPOSAL OF GUARD RAIL

STA. 1+730.0 LT. TO STA. 2+146.0 LT.

THINNING AND TRIMMING FOR SIGNS

STA. 1+956.0 RT.

STEEL BEAM GUARDRAIL


STA. 1+730 LT. TO STA. 2+134.6 LT.

DURABLE 100mm YELLOW LINE (POLYUREA)

STA. 1+730 TO STA. 2+430 (LT. & RT.)

DURABLE 100mm WHITE LINE (POLYUREA)

STA. 1+730 TO STA. 2+430 (EDGE LINE)

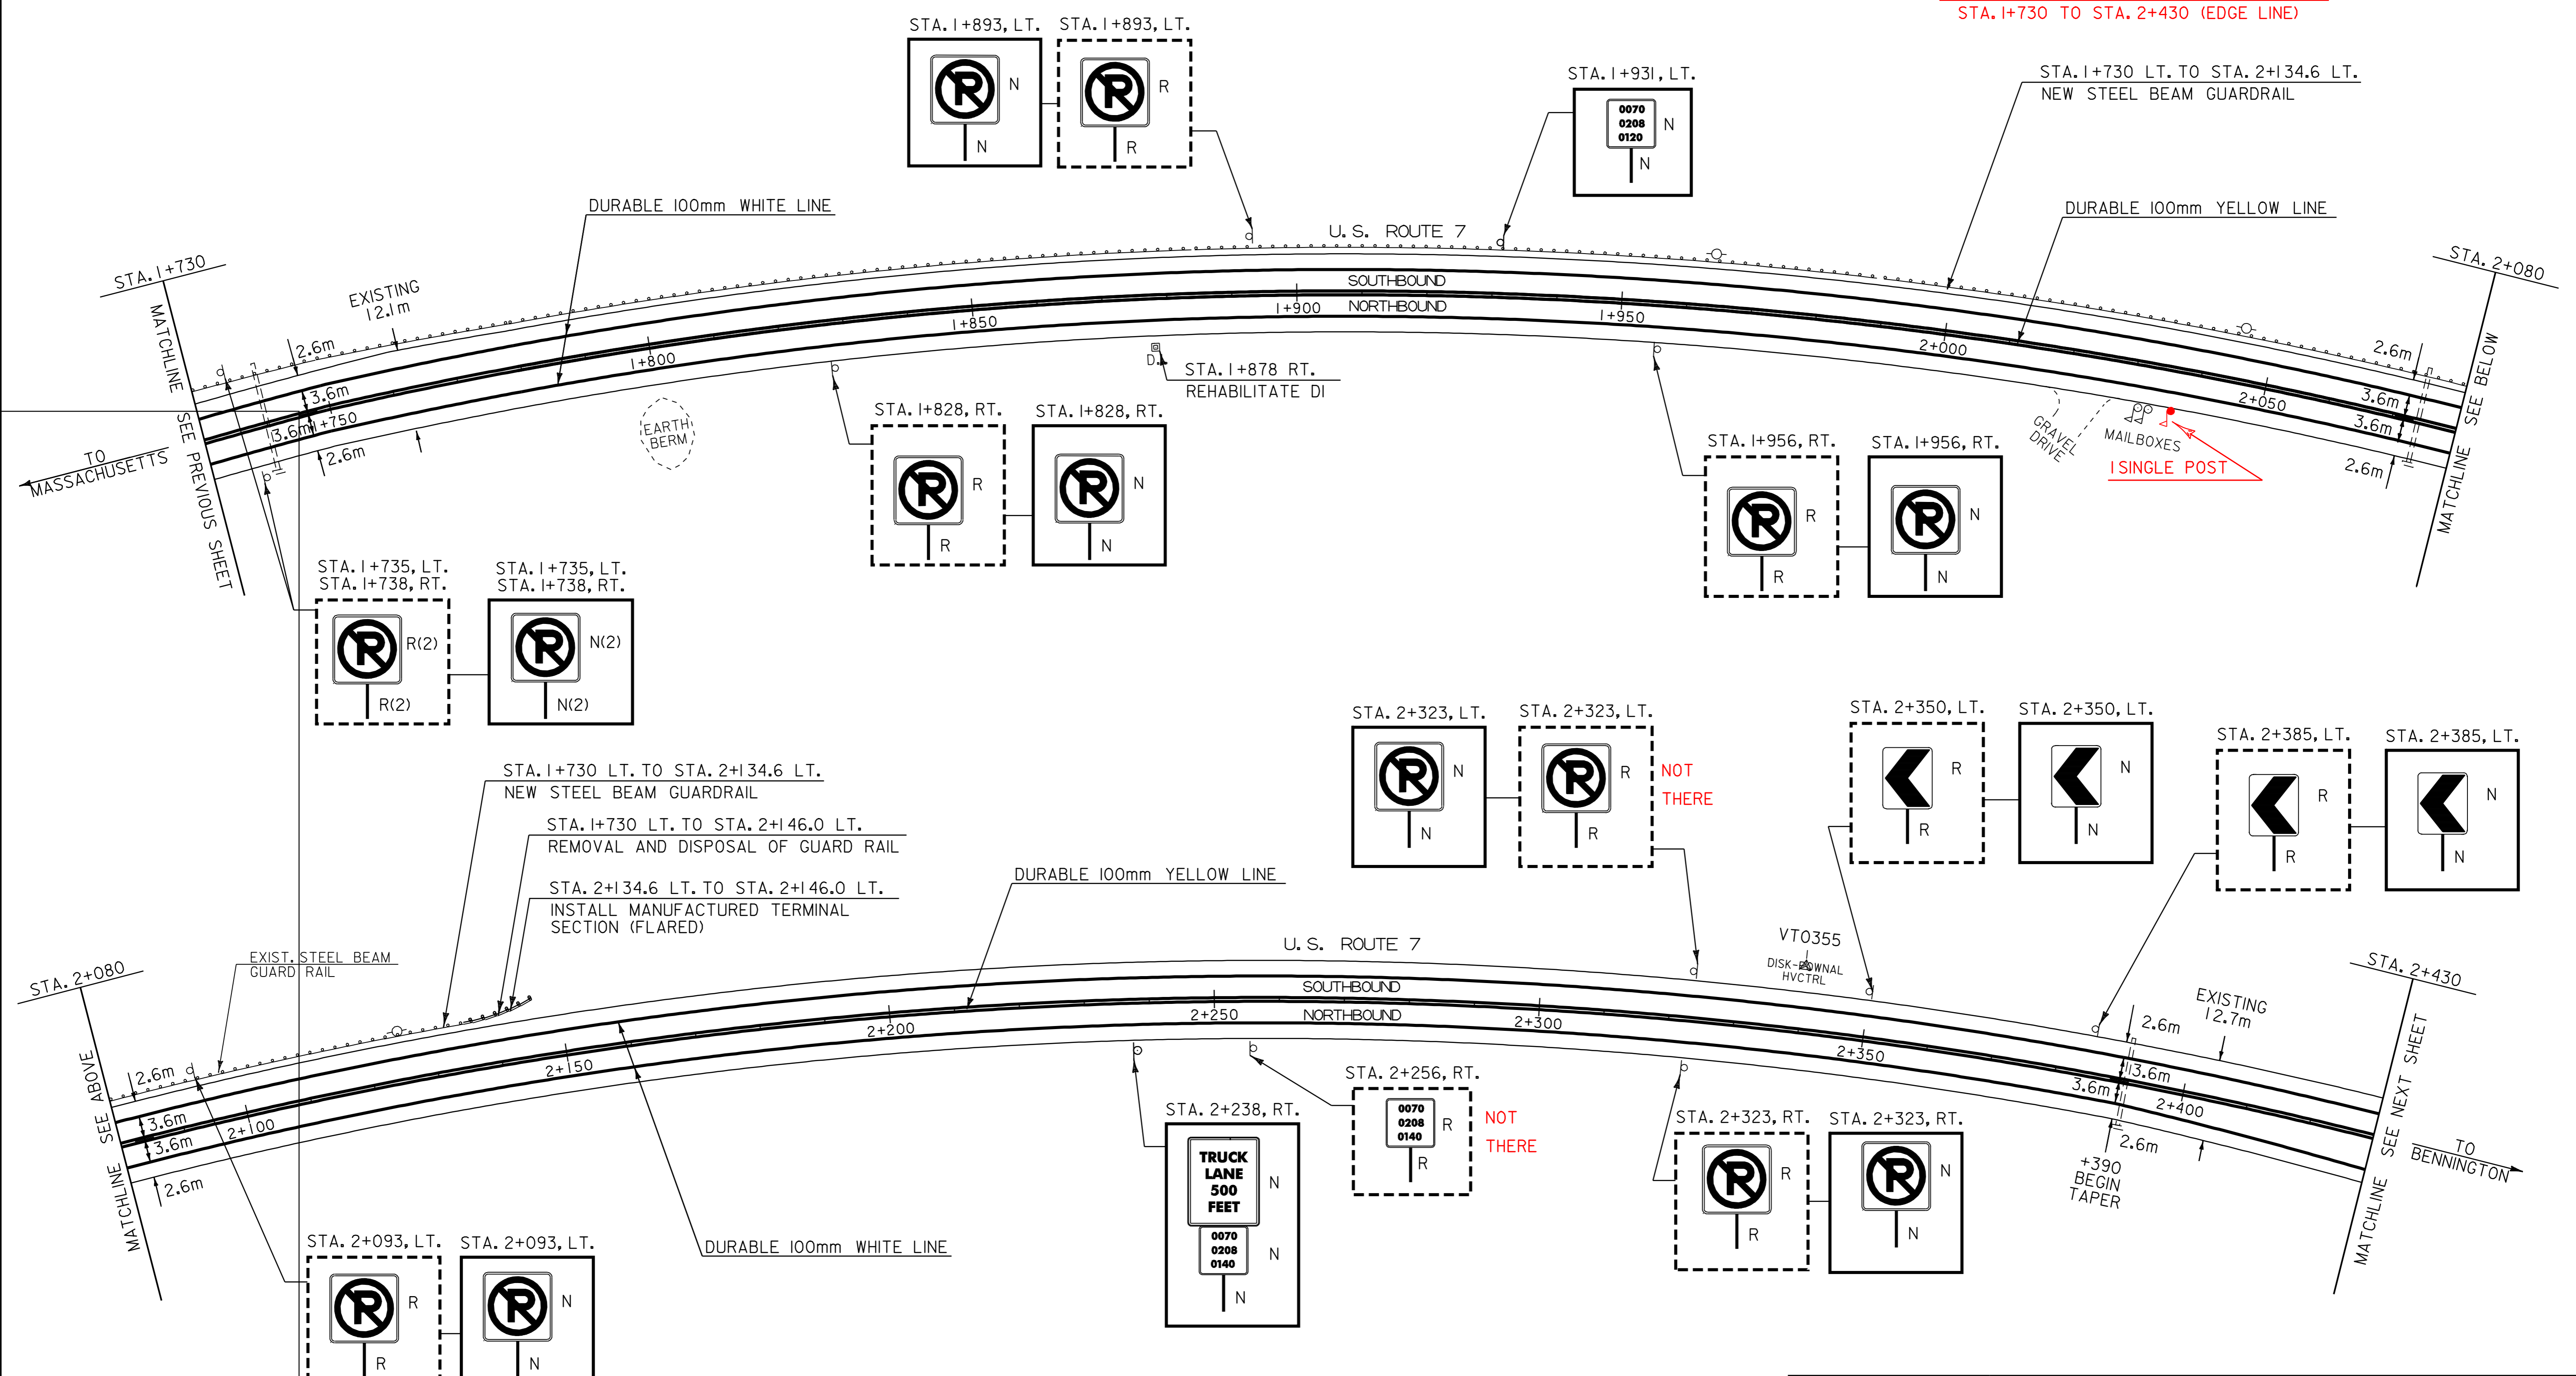

DATUM	
VERTICAL	N/A
HORIZONTAL	N/A

- LEGEND
- N = NEW
 - R = REMOVE
 - R & S = REMOVE AND SALVAGE
 - S = SALVAGE SIGN
 - RET = RETAIN
 - B - B = BACK TO BACK

PAVING PROJECT LAYOUT #5

PROJECT:	POWNAI-BENNINGTON	PROJECT NO.:	NH 2118(I)S
DESIGN FILE NAME:	/pave/98bl68/pbl68.dgn	PLOT DATE:	17-JAN-2006 14
IPARM FILE NAME:	pbl68105.1	SURVEY DATE:	
SURVEYED BY:	ACT, SJL, RAL	DRAWN BY:	ACT
SQUAD LEADER:	JAV	SHEET:	13 OF 65