

TEMPORARY AND DURABLE 100mm YELLOW LINE

STA. 2+730.0 TO STA. 2+736.0 SOLID LT. AND RT.
 STA. 2+736.0 TO STA. 2+808.0 SOLID DOUBLE LT. AND RT.
 STA. 2+824.0 TO STA. 2+890.0 SOLID DOUBLE LT. AND RT.
 STA. 2+786.5 RT. (B HILL ROAD)

TEMPORARY AND DURABLE 100mm WHITE LINE

STA. 2+730.0 TO STA. 2+890.0 SOLID LT. AND RT. (EDGE LINE)
 (WITH EDGE LINE BREAK FOR SIDE ROAD)
 STA. 2+730.0 RT. TO STA. 2+890.0 RT. DASHED (PASSING LANE)
 STA. 2+840.0 LT. TO STA. 2+890.0 LT. DASHED (PASSING LANE)

DURABLE 200mm YELLOW LINE

STA. 2+736.0 TO STA. 2+808 SOLID (CHANNELIZING LINES)
 STA. 2+824 TO STA. 2+890.0 SOLID (CHANNELIZING LINES)

TEMPORARY AND DURABLE LETTER OR SYMBOL

STA. 2+786.5 RT. - "STOP" (B HILL ROAD)

TEMPORARY AND DURABLE 600mm STOP BAR

STA. 2+786.5 RT. (B HILL ROAD)

MANUFACTURED TERMINAL SECTION (FLARED)

STA. 2+744.6 RT. TO STA. 2+756.0 RT.
 STA. 2+812.6 LT. TO STA. 2+824.0 LT.

REMOVAL AND DISPOSAL OF GUARD RAIL

STA. 2+744.6 RT. TO STA. 2+756.0 RT.
 STA. 2+730.0 LT. TO STA. 2+824.0 LT.

NEW STEEL BEAM GUARDRAIL

STA. 2+730 LT. TO STA. 2+812.6 LT.

SHOULDER BERM REMOVAL

~~STA. 2+730 LT. TO STA. 2+813 LT.~~
 STA. 2+730 RT. TO STA. 2+745 RT.

ERECTING SALVAGED SIGNS

I -- AS SHOWN

REMOVING SIGNS

17+6 -- AS SHOWN

REMOVING SIGNS (MOD.)


I -- AS SHOWN

COMMON EXCAVATION

STA. 2+868 TO STA. 2+890

DURABLE 100mm YELLOW LINE (POLYUREA)
 STA. 2+730 TO STA. 2+890 (LT. & RT.)

DURABLE 100mm WHITE LINE (POLYUREA)
 STA. 2+730 TO STA. 2+890 (EDGE LINE)

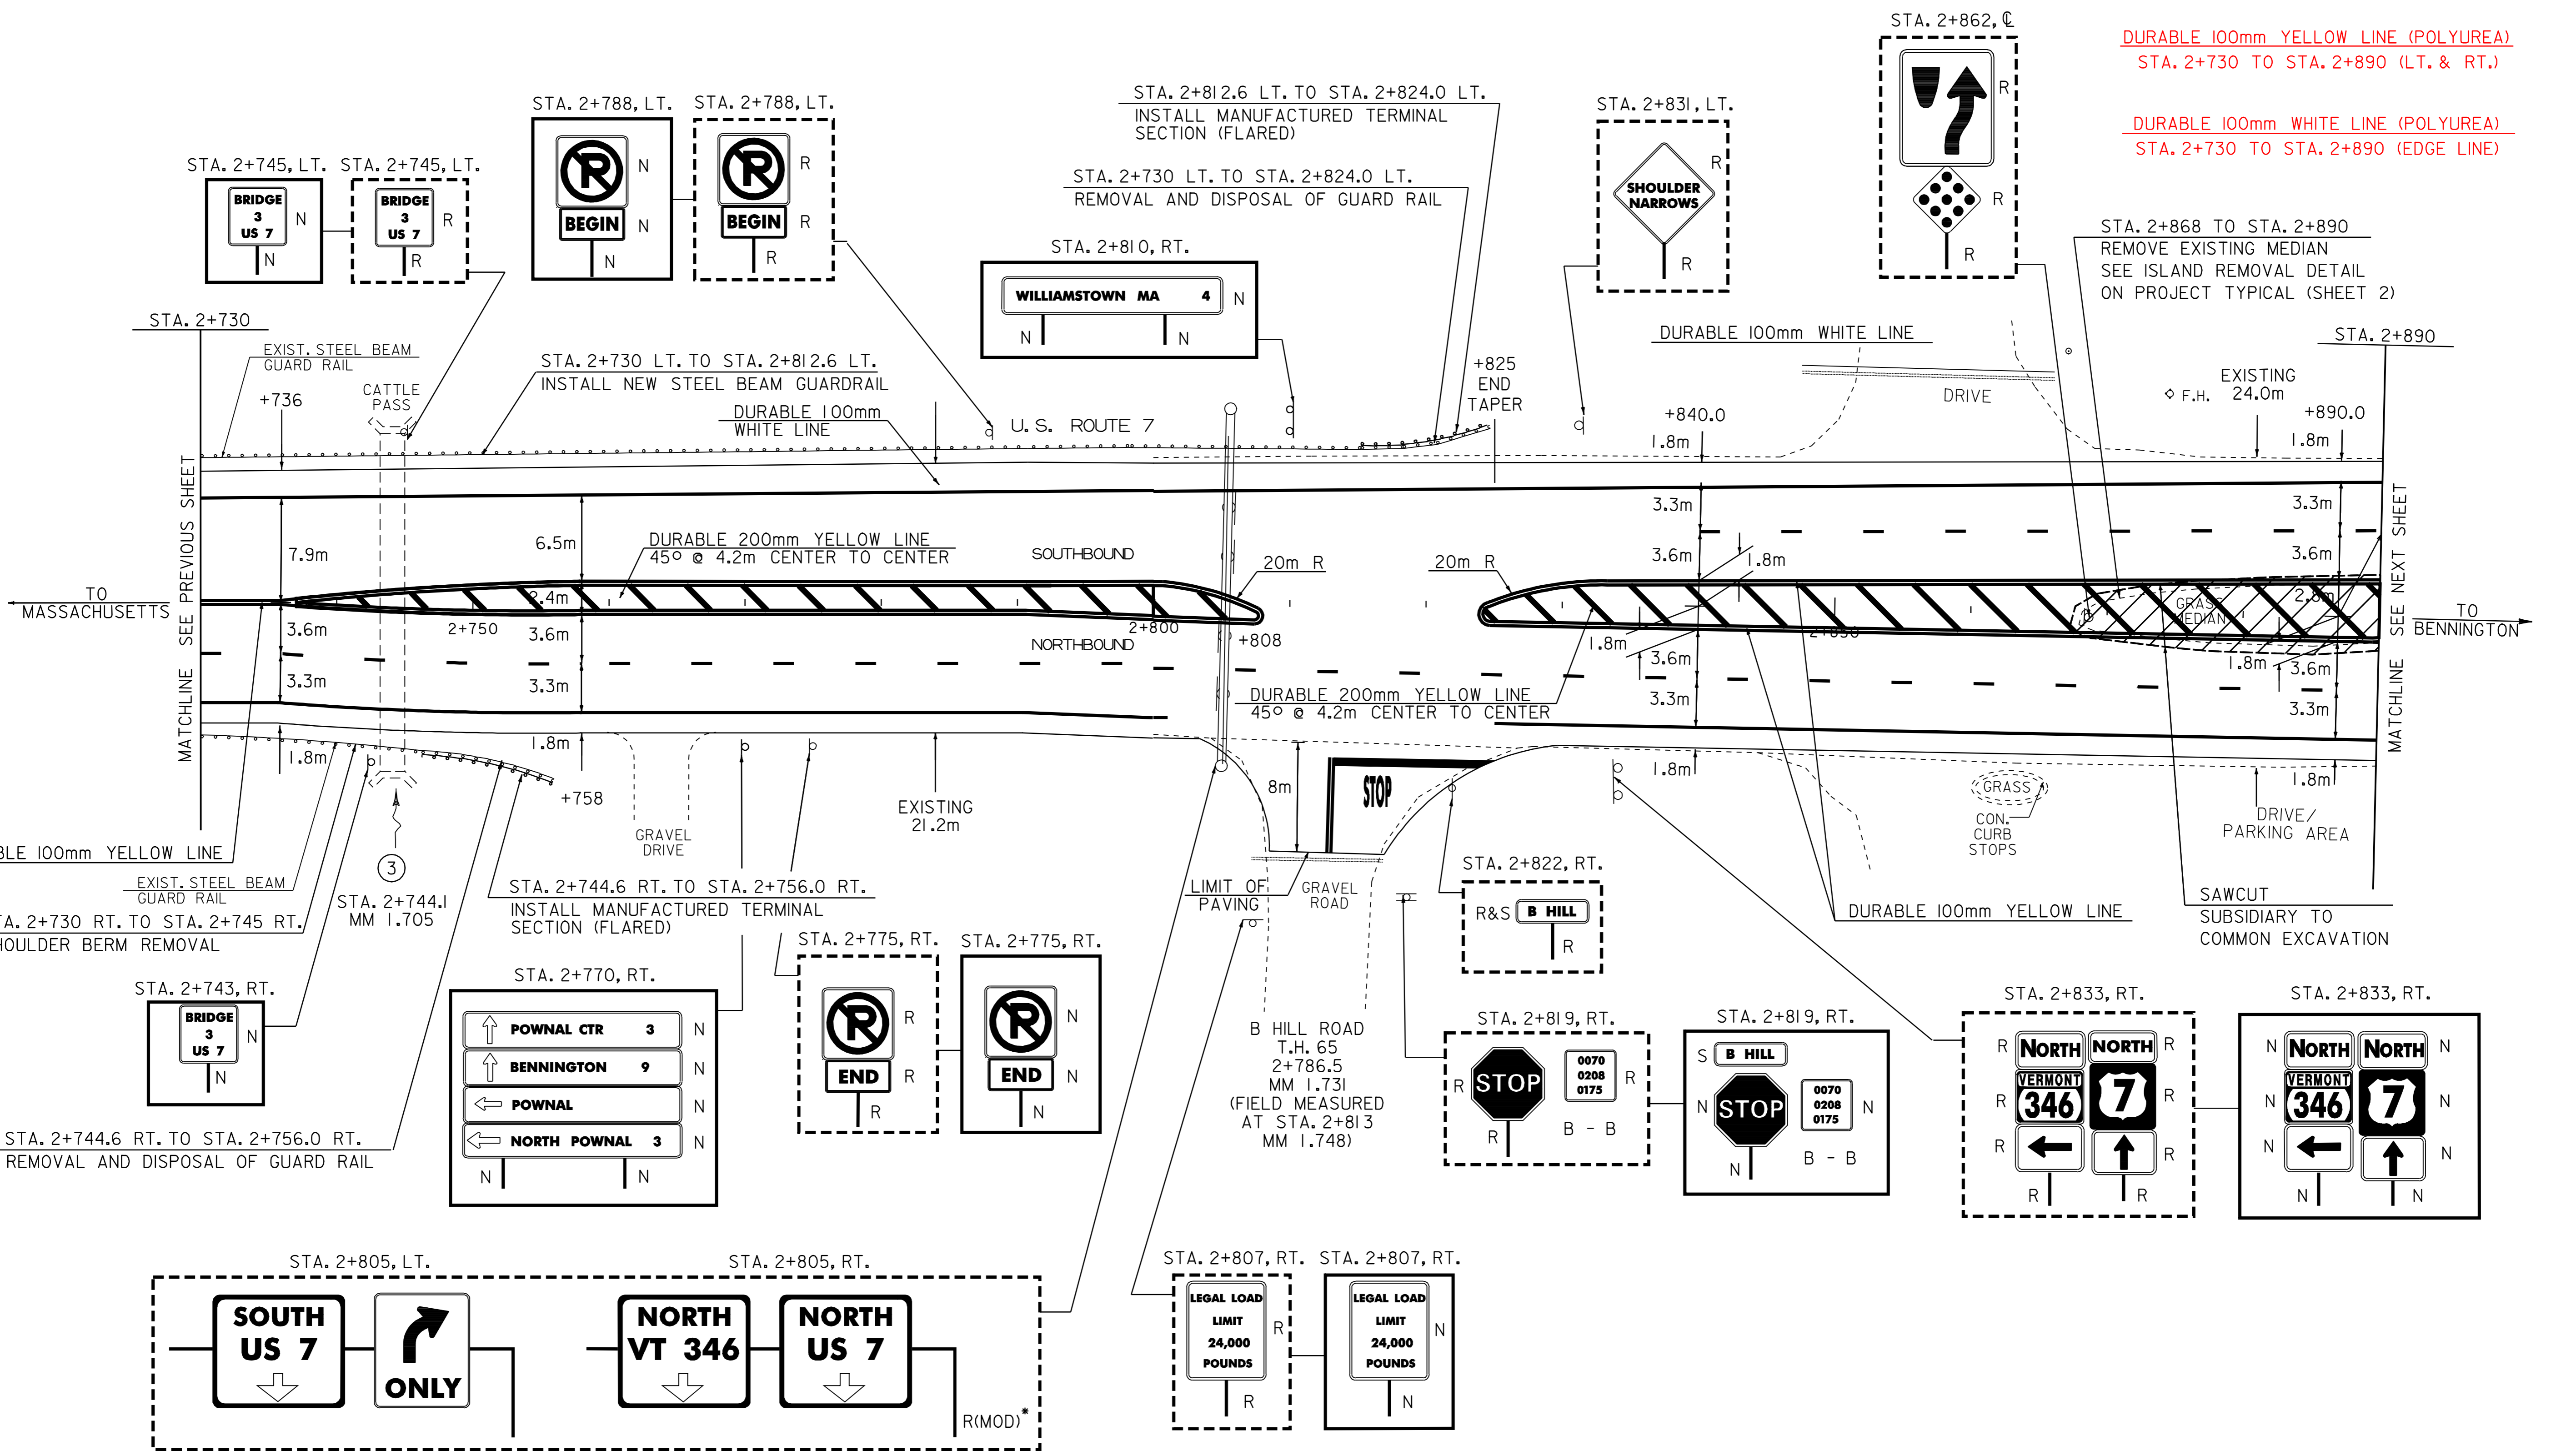

- LEGEND**
- N = NEW
 - R = REMOVE
 - R & S = REMOVE AND SALVAGE
 - S = SALVAGE SIGN
 - RET = RETAIN
 - B - B = BACK TO BACK

PAVING PROJECT LAYOUT #7

PROJECT:	POWNAL-BENNINGTON	PROJECT NO.:	NH 2118(I)S
DESIGN FILE NAME:	/pave/98bl68/pbl68.dgn	PLOT DATE:	17-JAN-2006 14
IPARM FILE NAME:	pbl68i07.i	SURVEY DATE:	
SURVEYED BY:	ACT, SJL, RAL	DRAWN BY:	ACT
SQUAD LEADER:	JAV	SHEET:	15 OF 65

DATUM	
VERTICAL	N/A
HORIZONTAL	N/A

* REMOVE OVERHEAD SIGNS, SIGN STRUCTURE AND BASES