

TEMPORARY AND DURABLE 100mm YELLOW LINE

STA. 3+420.0 TO STA. 3+760.0 SOLID LT. AND RT.
(WITH CENTERLINE BREAK FOR SIDE ROADS)
STA. 3+589.3 RT. (LADD BROOK ROAD)
STA. 3+589.3 LT. (LADD BROOK ROAD)

TEMPORARY AND DURABLE 100mm WHITE LINE

STA. 3+420.0 TO STA. 3+760.0 SOLID LT. AND RT. (EDGE LINE)
(WITH EDGE LINE BREAK FOR SIDE ROADS)
STA. 3+420.0 RT. TO STA. 3+450.0 RT. DASHED (PASSING LANE)

TEMPORARY AND DURABLE LETTER OR SYMBOL

STA. 3+589.3 LT. - "STOP" (LADD BROOK ROAD)
STA. 3+589.3 RT. - "STOP" (LADD BROOK ROAD)

TEMPORARY AND DURABLE 600mm STOP BAR


STA. 3+589.3 RT. (LADD BROOK ROAD)
STA. 3+589.3 LT. (LADD BROOK ROAD)

REMOVING SIGNS

4 -- AS SHOWN

DURABLE 100mm YELLOW LINE (POLYUREA)
STA. 3+420 TO STA. 3+760 (LT & RT.)

DURABLE 100mm WHITELINE (POLYUREA)
STA. 3+420 TO STA. 3+760 (EDGE LINE)

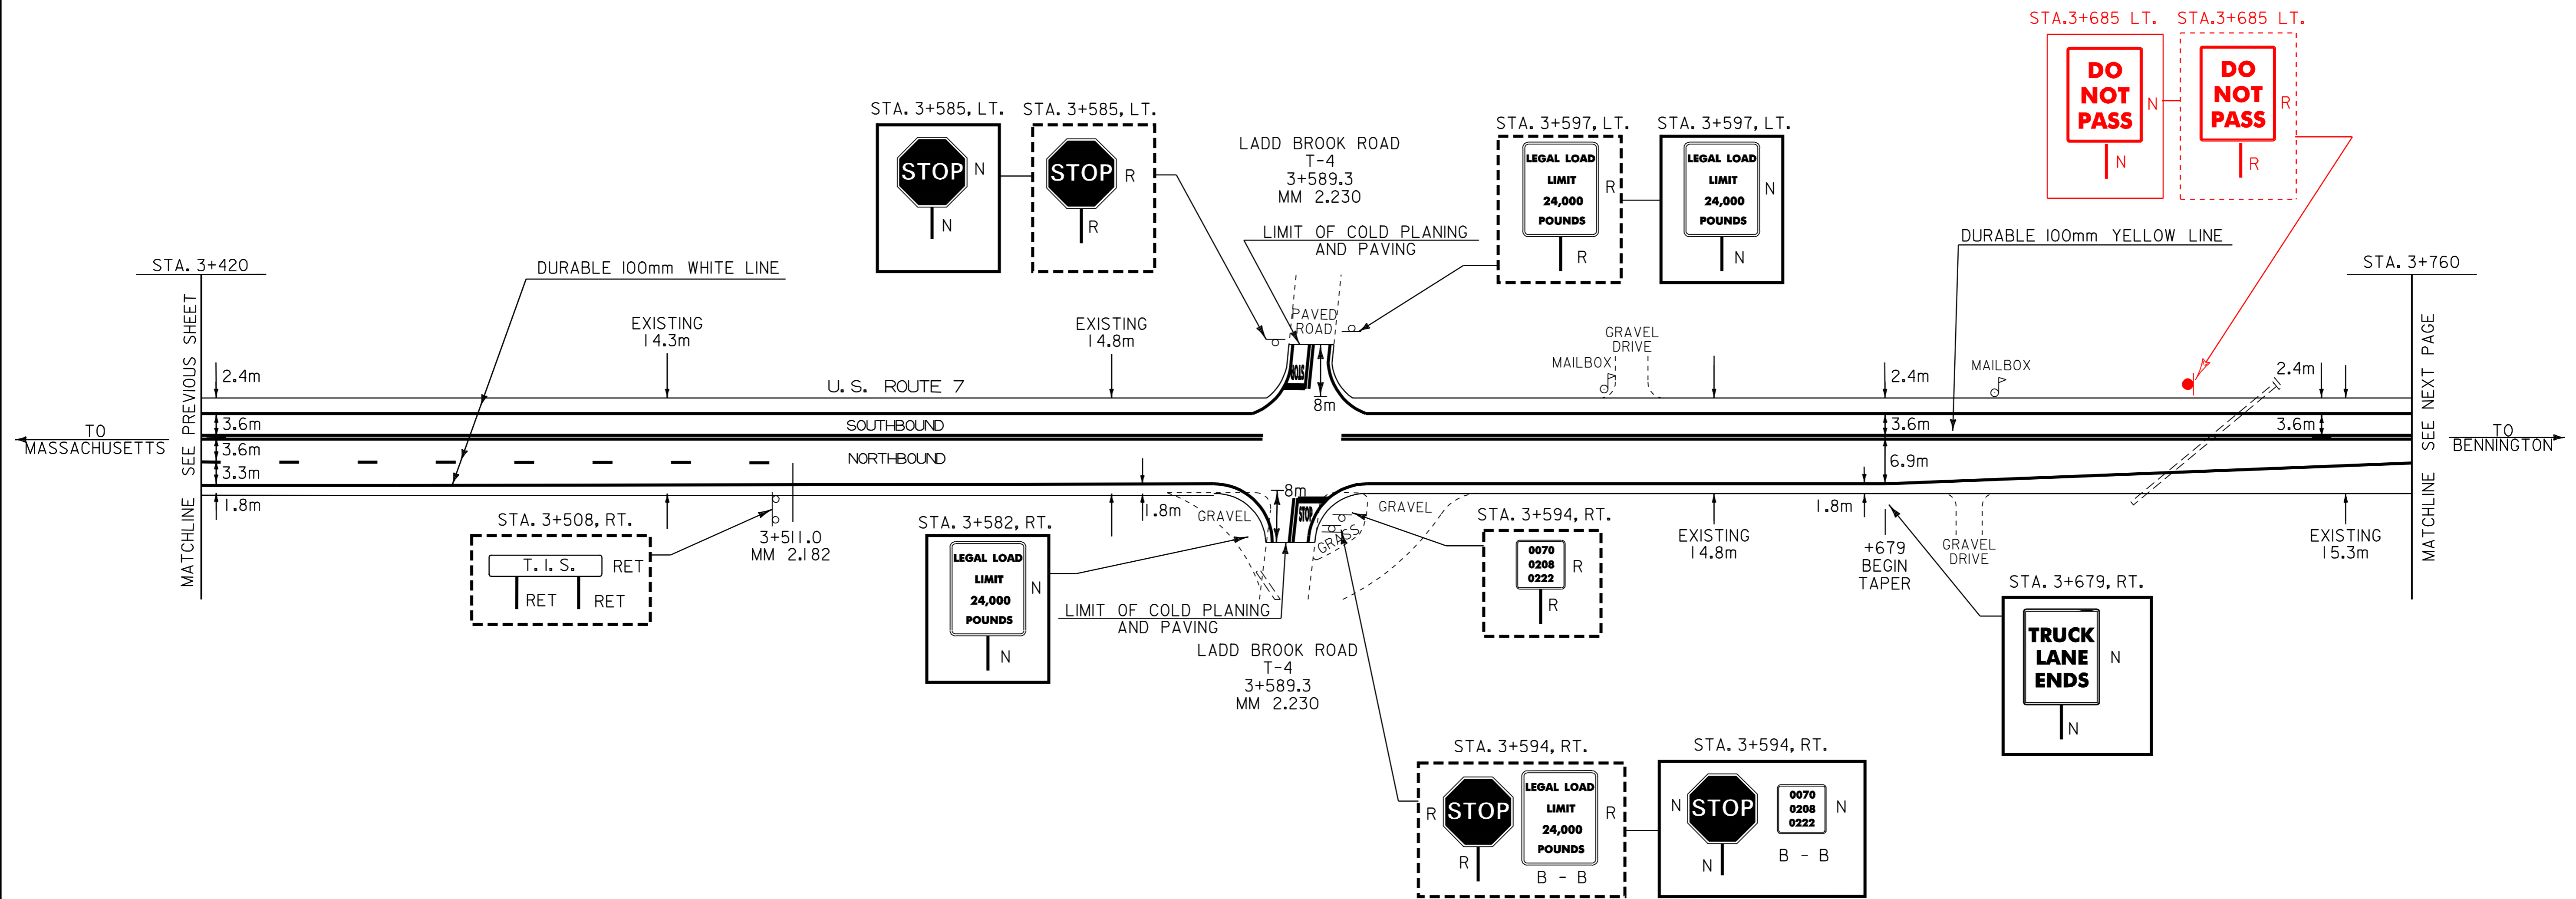

TO MASSACHUSETTS

TO BENNINGTON

- LEGEND
- N = NEW
 - R = REMOVE
 - R & S = REMOVE AND SALVAGE
 - S = SALVAGE SIGN
 - RET = RETAIN
 - B - B = BACK TO BACK

PAVING PROJECT LAYOUT #10

PROJECT:	POWNAI-BENNINGTON	PROJECT NO.:	NH 2118(I)S
DESIGN FILE NAME:	/pave/98bl68/pbl68.dgn	PLOT DATE:	17-JAN-2006 14
IPARM FILE NAME:	pbl68i10.1	SURVEY DATE:	
SURVEYED BY:	ACT, SJL, RAL	DRAWN BY:	ACT
SQUAD LEADER:	JAV	SHEET:	18 OF 65

DATUM	
VERTICAL	N/A
HORIZONTAL	N/A